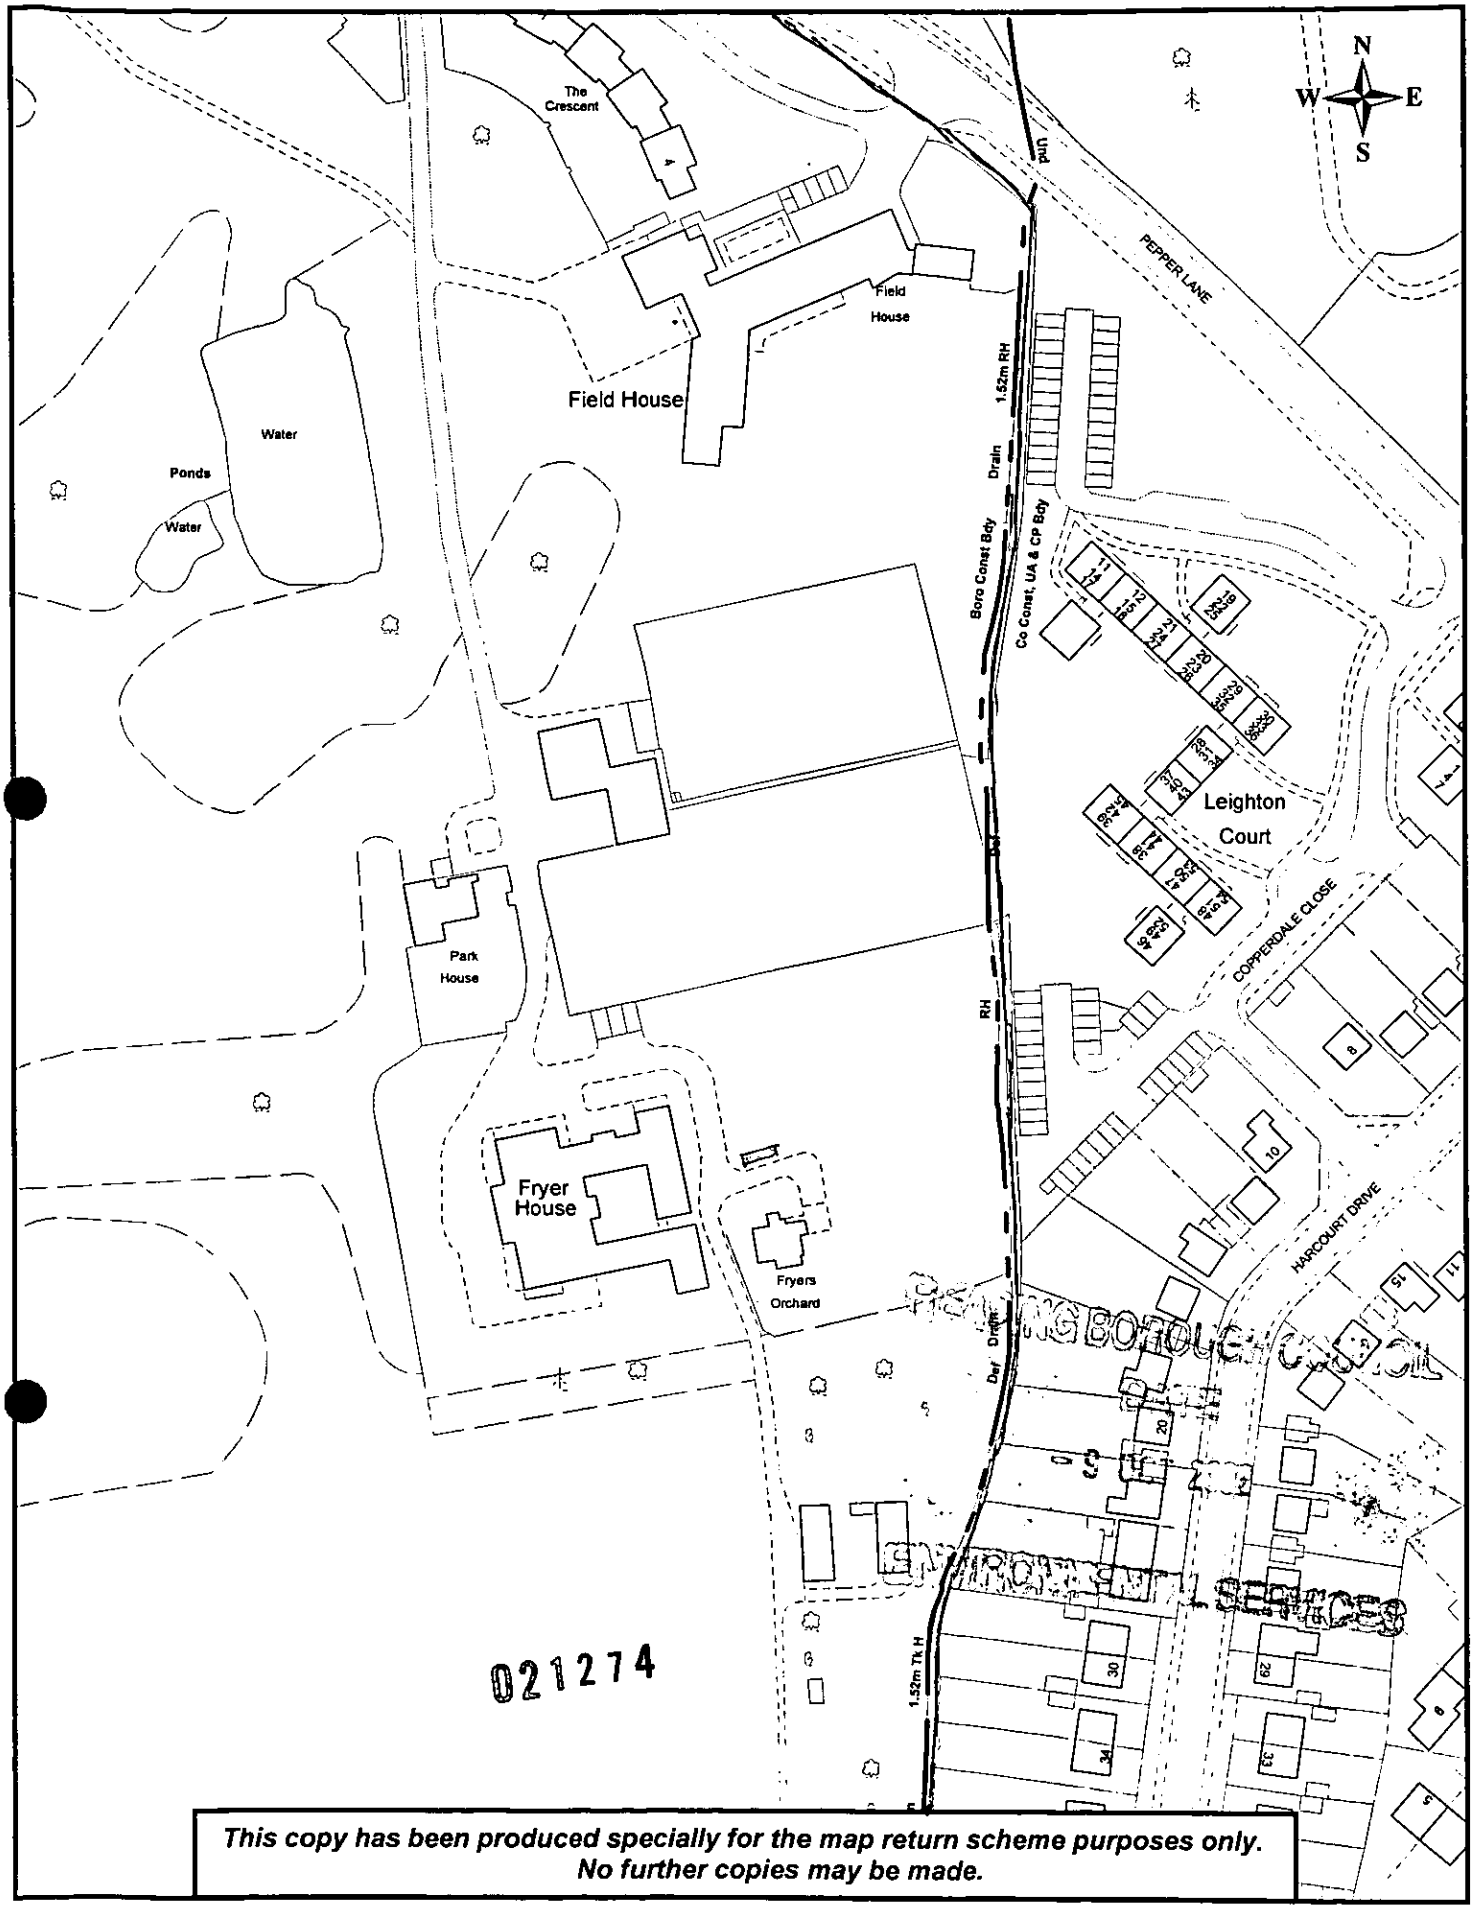

This copy has been produced specially for the map return scheme purposes only. No further copies may be made.

Title: Location Plan
Tennis Courts, Leighton Park School, Pepper Lane

Date: 27/09/2002

Produced by GIS & Mapping Services

Scale: 1:1250

Reading BOROUGH COUNCIL

© Crown Copyright.All rights reserved. Reading Borough Council. Licence no LA 079049. 2002.

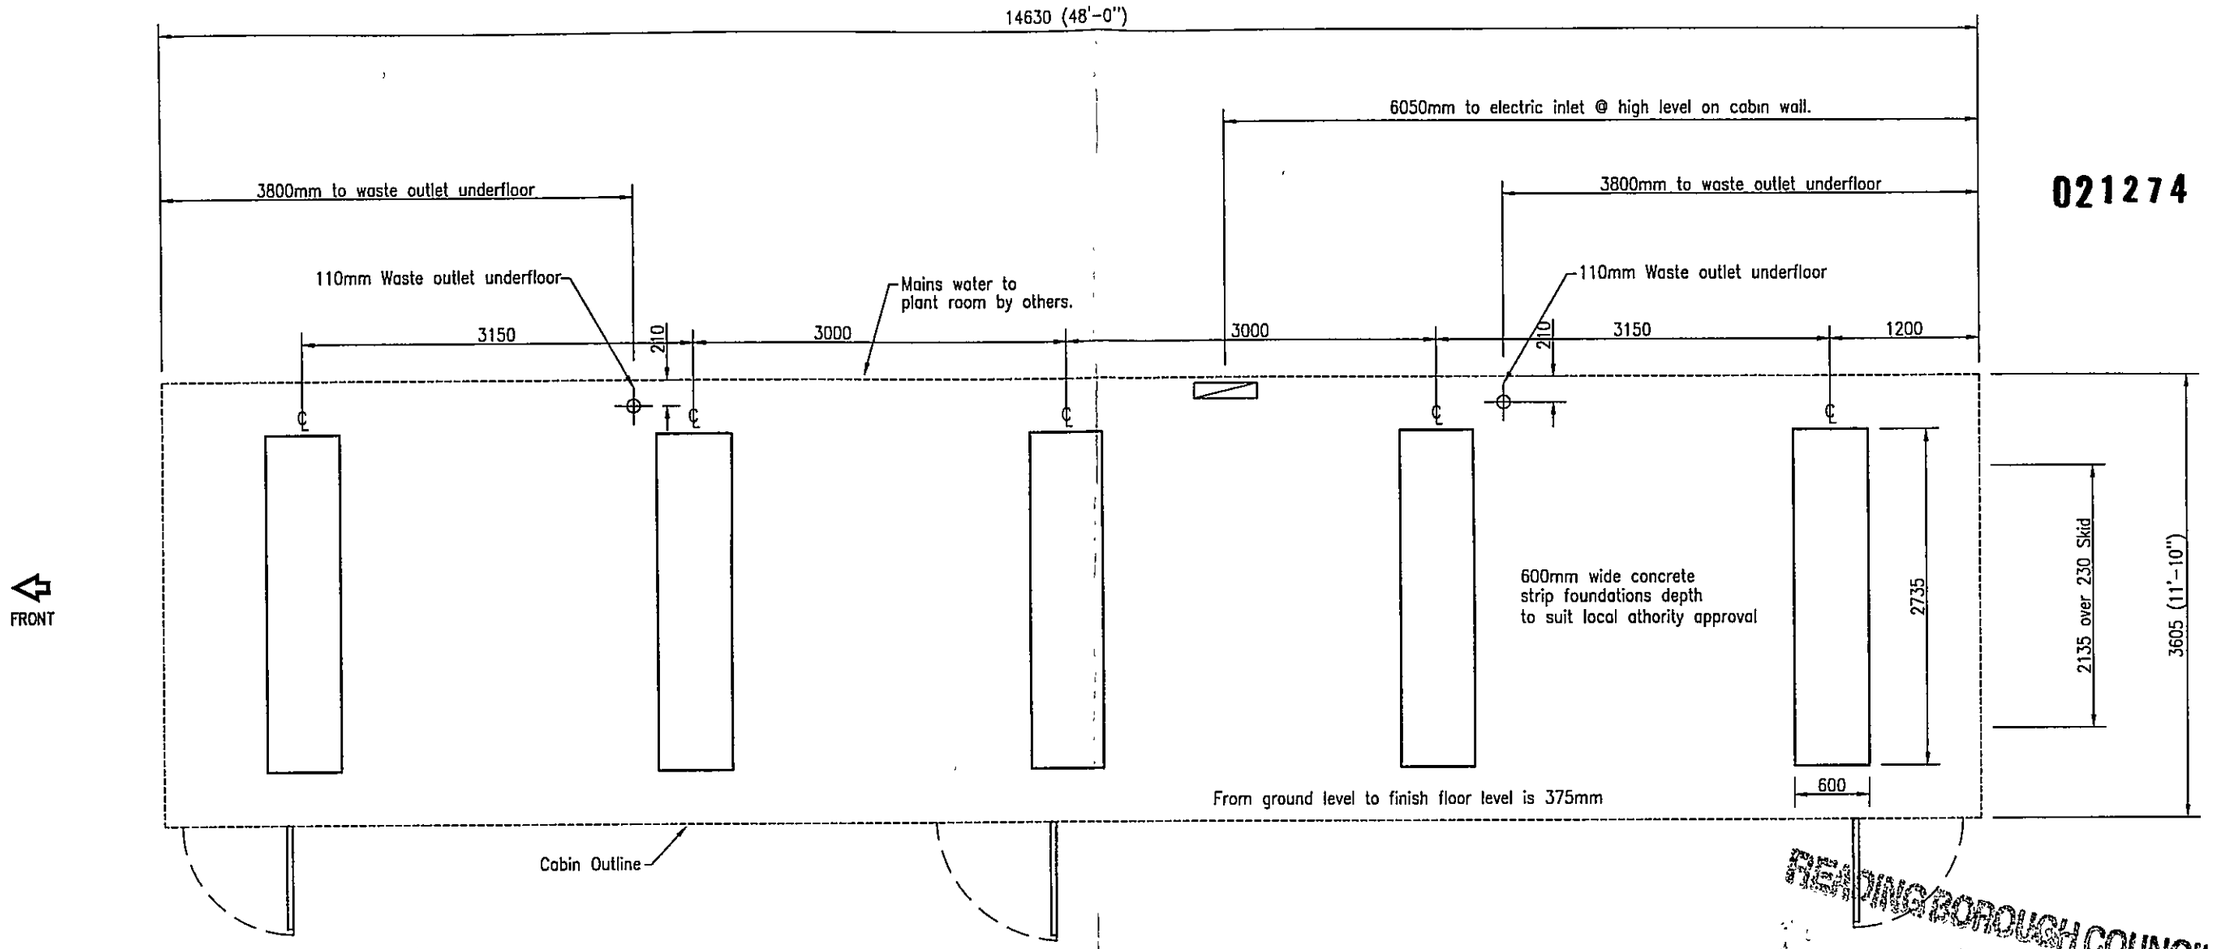

021274

READING BOROUGH COUNCIL
DATE
- 9 OCT 2002
ENVIRONMENTAL SERVICES

LAYOUT DRAWING No 44691S103

CLIENTS APPROVAL OF DRAWINGS

ANY COSTS OR TIME DELAYS ARISING FROM CHANGES AFTER DRAWING APPROVAL WILL BE CHARGEABLE TO THE CLIENT

SIGNED BY:
POSITION:
DATE:

NO WORK WILL COMMENCE ON THIS PROJECT UNTIL WE RECEIVE A SIGNED COPY OF THE DRAWING INDICATING APPROVAL OF LAYOUT.

	ELECTRICAL SWITCHGEAR		2KW CONVECTOR HEATER
	FLUORESCENT LIGHT		MPH 500 HEATER
	BULKHEAD LIGHT		W C
	LIGHT SWITCH		URINAL BOWL
	PULLCORD SWITCH		WASH HAND BASIN
	13A SWITCHED SPUR OUTLET		SINK WITH DRAINER
	13A SWITCHED SOCKET		

	INSTANTANEOUS WATER H'TER
	7 ltr WATER STORAGE H'TER
T	COLD WATER TAP
V	HIGH LEVEL FIXED VENT
VE	VACANT/ENGAGED INDICATOR
L	LOCK
T	COAT HOOK
W/L	WINDOW AT WAIST LEVEL
H/L	WINDOW AT HIGH LEVEL
——	MESHGUARD TO WINDOW
——	SHUTTER TO WINDOW

CABIN REF: RS 1460 37 SI 44691S103
JOB No: 105/3/

REV	AMENDMENT	BY	DATE
1	Initial Issue	JPB	6.8.02

CLIENT: Leighton Park School
Date: 6.8.2002
TITLE: 14.6 x 3.7m Rollaskid Cabin
Scale: 1:50
Shower and Changing
Drawn: JPB

Rollalong
PORTABLE ACCOMMODATION
WOOLSBRIDGE INDUSTRIAL PARK, THREE LEGGED CROSS
WIMBORNE, DORSET, BH21 6SF Tel. 01202 824541

Dwg. No: 44691S103
Rev. 1
Checked: JBaker
Date: 7.6.02

THIS DRAWING IS THE PROPERTY OF ROLLALONG AND MAY NOT BE COPIED OR REPRODUCED WITHOUT PERMISSION IN WRITING FROM ROLLALONG

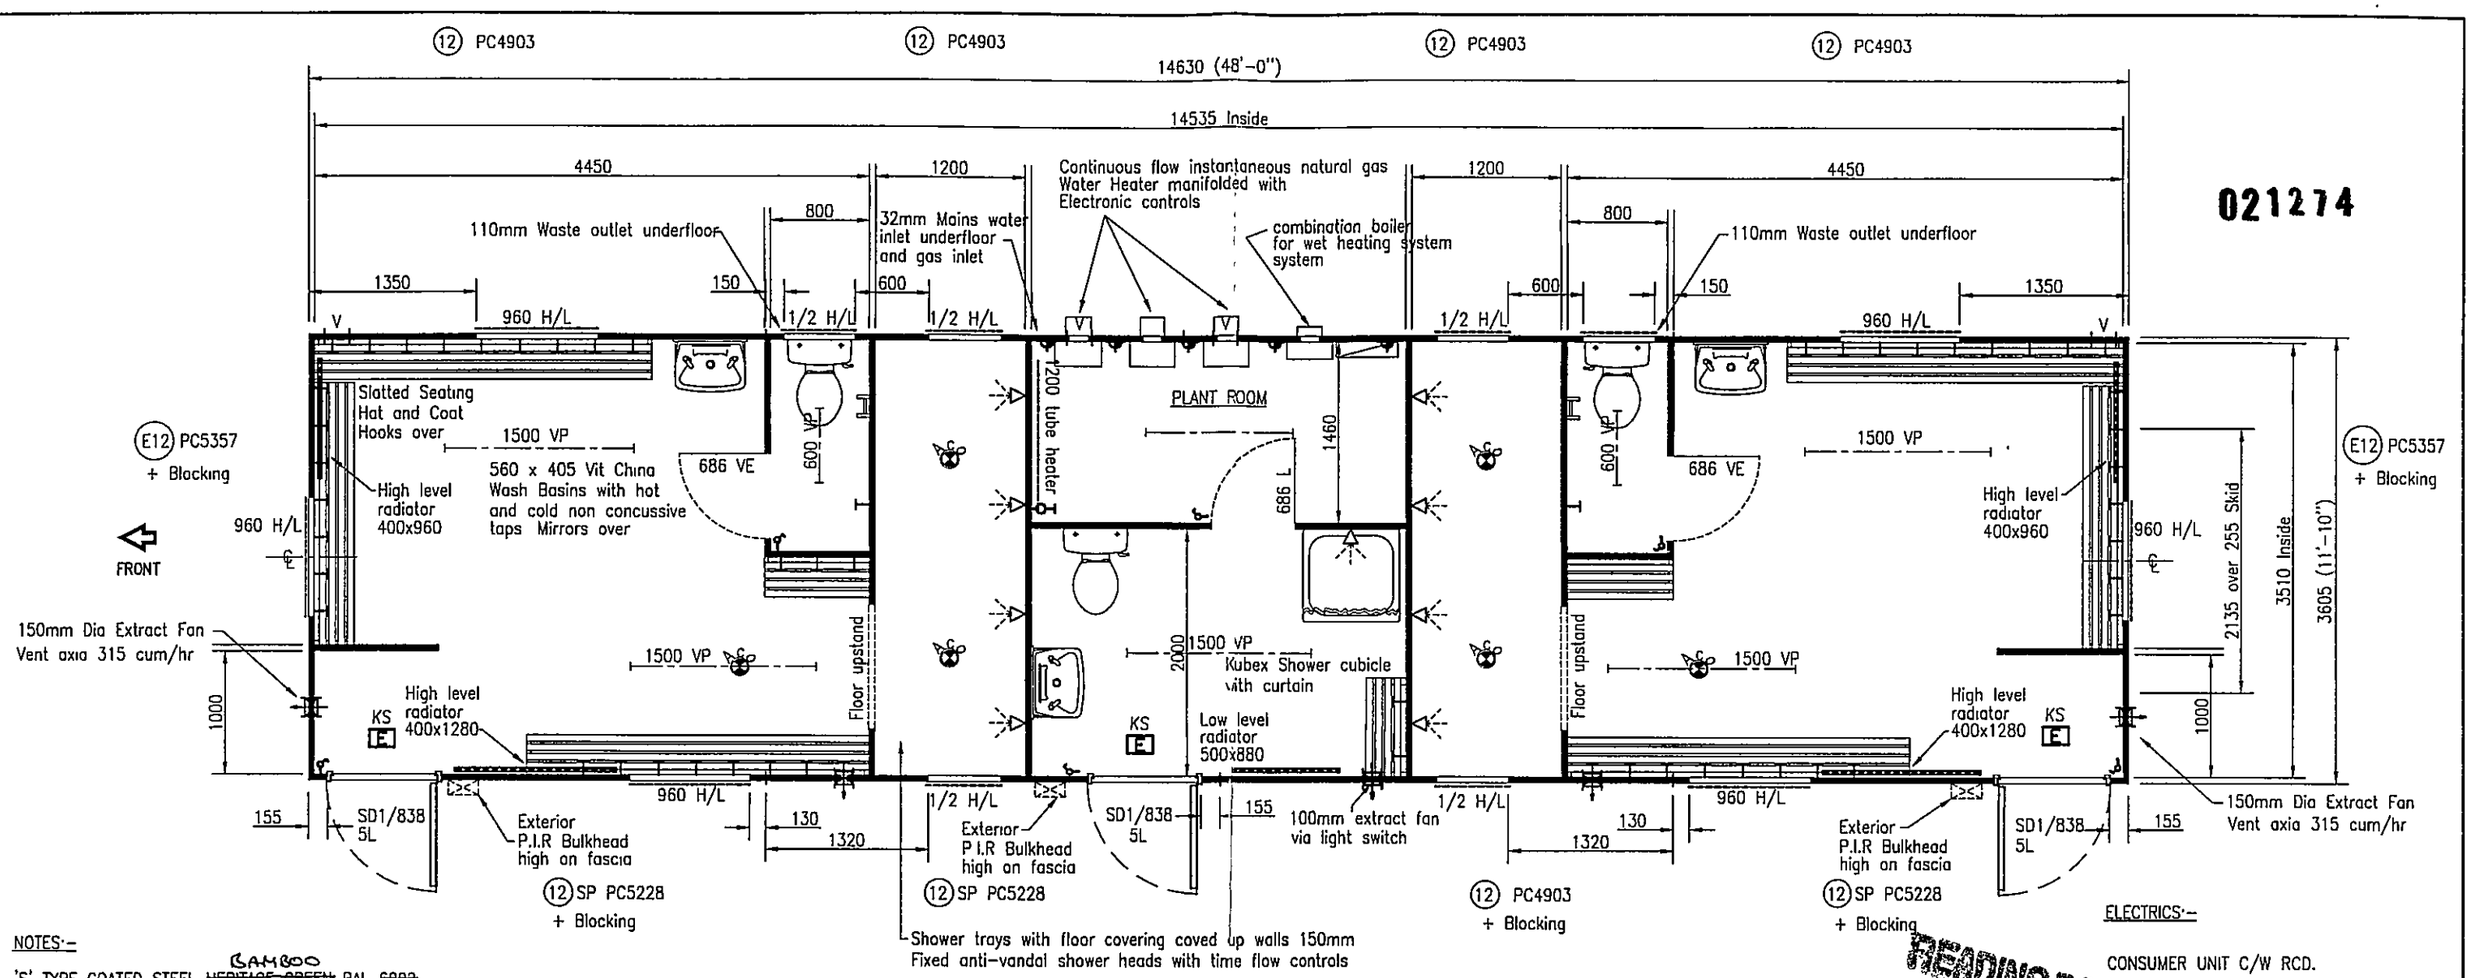

NOTES:-

'S' TYPE COATED STEEL ~~HERITAGE GREEN~~ BAMBOO RAL ~~6002~~
OCEAN BLUE 18-C-39 FASCIAS.
OCEAN BLUE 18-C-39 DOORS.
BLACK SKID
COATED STEEL INTERIOR WHITE 00-E-55.
2300mm HEADROOM.
18mm PLYWOOD FLOOR.
MARLEY DECK ROOF WITH WHITE FACED PLYWOOD CEILING LINING.
HIGH AND LOW LEVEL VENTS TO PLANT ROOM.
HIGH LEVEL WINDOWS 960 X 267mm SINGLE LIGHT OPENING.
HALF HIGH LEVEL WINDOWS 572 x 267mm SINGLE LIGHT OPENING.
MESH GUARDS TO ALL HIGH LEVEL WINDOWS.

SHOWER TRAY

2.0mm ALTRO MARINE FLOOR COVERING WITH JOINTS WELDED FOG T20153. AND COVED 150mm UP WALLS.
SLOPING FLOOR TO ACO FLOOR DRAINS IN SHOWER AREA.

CHANGING ROOMS, REFS CHANGE AND PLANT ROOM.

2.0mm ALTRO WALKWAY 20 FOG UM20153 WITH BLACK SET-IN COVING THROUGHOUT.

HEAVY DUTY SECURITY DOOR COMPLETE WITH FULL HEIGHT STAINLESS STEEL PIANO HINGE AND CENTRAL 5 LEVER MORTICE LOCK LEGGE 5762 COMPLETE WITH LEVER FURNITURE.
DOOR LEAF 1983 x 840mm.

PLUMBING

COMBINATION BOILER TO FEED WET HEATING SYSTEM AND BASINS
SHOWERS FITTED WITH ANTI VANDAL HEADS WITH RADA OR SIMILAR TIME FLOW CONTROLS.
HOT WATER VIA THERMOSTATIC BLENDING VALVE TO SHOWER HEADS.
CONTINUOUS FLOW INSTANTANEOUS NATURAL GAS WATER HEATERS
WITH MANIFOLDS AND ELECTRONIC CONTROLS.
ALL EXPOSED COPPER PIPEWORK TO BE PAINTED WHITE.
WHERE SOIL AND VENT PIPE TERMINATES THROUGH ROOF 150mm
PROTECT PIPE WITH POLY FOR TRANSIT.

ELECTRICS:-

CONSUMER UNIT C/W RCD.
6A LIGHTS AND FAN.
16A SPUR.
5 - 16A WATER HEATERS(CONTROLLERS)
FANS:- FITTED @ 200mm FROM CEILING TO TOP OF FAN.
E = 3 HOUR RATED MAINTAINED EMERGENCY LIGHT
KS WITH KEY SWITCH.

READING BOROUGH COUNCIL
DATE = 9 OCT 2002
ENVIRONMENTAL SERVICES

CLIENTS APPROVAL OF DRAWINGS

ANY COSTS OR TIME DELAYS ARISING FROM CHANGES AFTER DRAWING APPROVAL WILL BE CHARGEABLE TO THE CLIENT.

SIGNED BY:
POSITION:
DATE:

NO WORK WILL COMMENCE ON THIS PROJECT UNTIL WE RECEIVE A SIGNED COPY OF THE DRAWING INDICATING APPROVAL OF LAYOUT.

	ELECTRICAL SWITCHGEAR		2KW CONVECTOR HEATER
	FLUORESCENT LIGHT		MPH 500 HEATER
	BULKHEAD LIGHT		W.C.
	LIGHT SWITCH		URINAL BOWL
	PULLCORD SWITCH		WASH HAND BASIN
	13A SWITCHED SPUR OUTLET		SINK WITH DRAINER
	13A SWITCHED SOCKET		

	INSTANTANEOUS WATER H'TER
	7 ltr WATER STORAGE H'TER
T	COLD WATER TAP
V	HIGH LEVEL FIXED VENT
VE	VACANT/ENGAGED INDICATOR
L	LOCK
T	COAT HOOK
W/L	WINDOW AT WAIST LEVEL
H/L	WINDOW AT HIGH LEVEL
———	MESHGUARD TO WINDOW
———	SHUTTER TO WINDOW

CABIN REF: RS 1460 37 SI 44691S004
JOB No: 105/3/

REV	AMENDMENT	BY	DATE
2	amended to AR2	JPB	6.8.2002
1	Initial Issue	NDP	17.6.02

CLIENT: Leighton Park School — Date: 17.6.02
TITLE: 14.6 x 3.7m Rollaskid Cabin — Scale: 1:50
Shower and Changing Room — Drawn: NDP

Rollalong PORTABLE ACCOMMODATION
WOOLSBRIDGE INDUSTRIAL PARK, THREE LEGGED CROSS, WIMBORNE, DORSET, BH21 6SF Tel: 01202 824541

Dwg. No: 44691S004 — Rev. 2
Checked: JBaker — Date: 6.8.02

THIS DRAWING IS THE PROPERTY OF ROLLALONG AND MAY NOT BE COPIED OR REPRODUCED WITHOUT PERMISSION IN WRITING FROM ROLLALONG.

021274

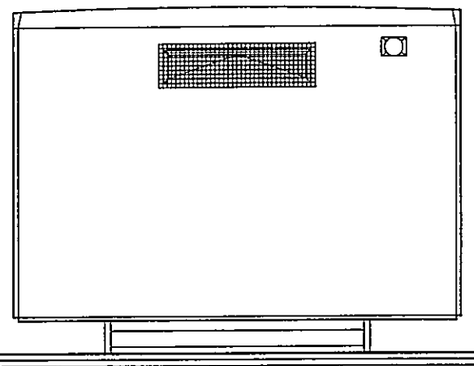

SIDE

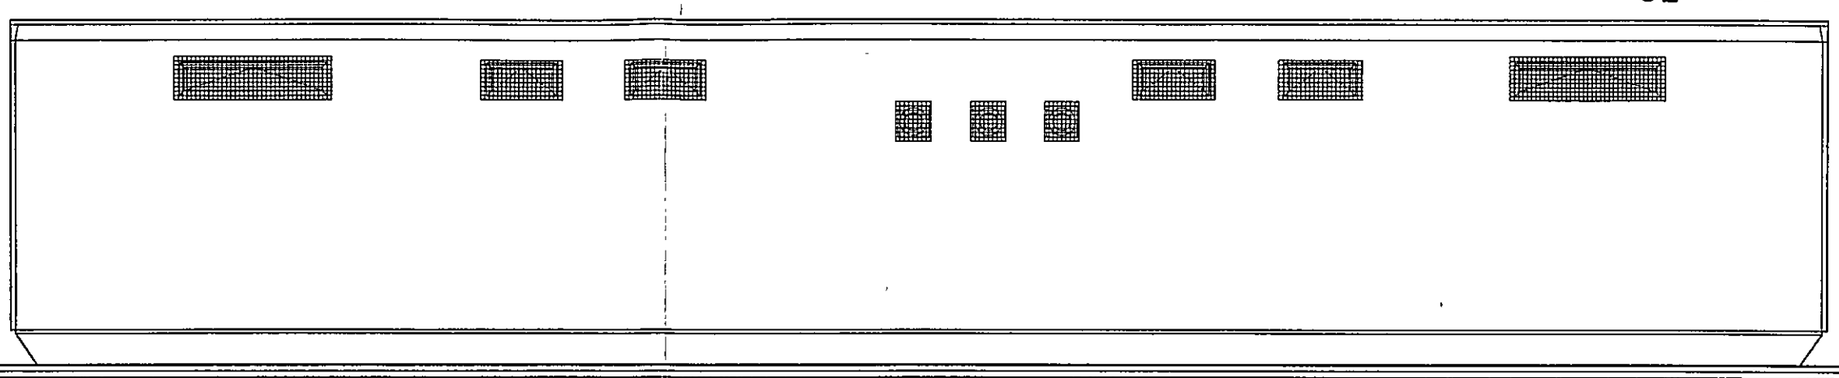

REAR

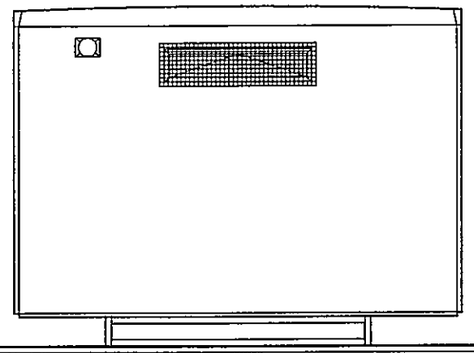

SIDE

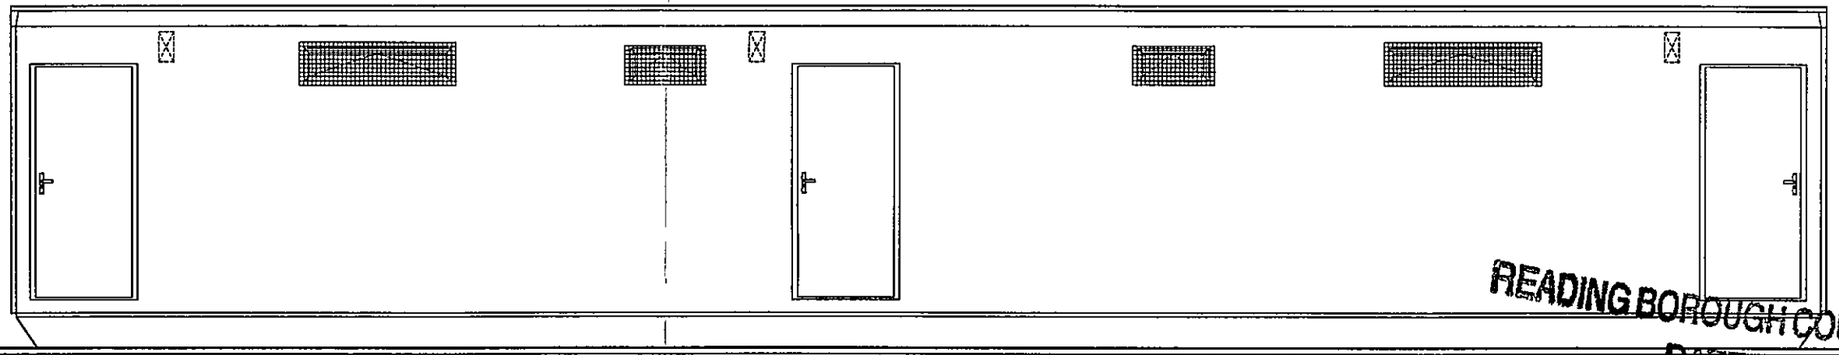

FRONT

ELEVATION ILLUSTRATIVE ONLY

READING BOROUGH COUNCIL
DATE
- 9 OCT 2002
ENVIRONMENTAL SERVICES

LAYOUT PLAN REF 44691S004

CLIENTS APPROVAL OF DRAWINGS

ANY COSTS OR TIME DELAYS ARISING FROM CHANGES AFTER DRAWING APPROVAL WILL BE CHARGEABLE TO THE CLIENT.

SIGNED BY:
POSITION:
DATE:

NO WORK WILL COMMENCE ON THIS PROJECT UNTIL WE RECEIVE A SIGNED COPY OF THE DRAWING INDICATING APPROVAL OF LAYOUT.

	ELECTRICAL SWITCHGEAR		2KW CONVECTOR HEATER
	FLUORESCENT LIGHT		MPH 500 HEATER
	BULKHEAD LIGHT		W.C.
	LIGHT SWITCH		URINAL BOWL
	PULLCORD SWITCH		WASH HAND BASIN
	13A SWITCHED SPUR OUTLET		SINK WITH DRAINER
	13A SWITCHED SOCKET		

	INSTANTANEOUS WATER H'TER
	7 ltr WATER STORAGE H'TER
T	COLD WATER TAP
V	HIGH LEVEL FIXED VENT
VE	VACANT/ENGAGED INDICATOR
L	LOCK
T	COAT HOOK
W/L	WINDOW AT WAIST LEVEL
H/L	WINDOW AT HIGH LEVEL
——	MESHGUARD TO WINDOW
——	SHUTTER TO WINDOW

CABIN REF: RJ 1460 37 SI 44691S104
JOB No: 105/3/

REV	AMENDMENT	BY	DATE
1	Initial Issue	JPB	7.8.02

CLIENT: Leighton Park School — Date: 7.8.02
TITLE: 14.6 x 3.7m Rollajack Cabin — Scale: 1:50
Elevation — Drawn: JPB

Rollalong
PORTABLE ACCOMMODATION
WOOLSBRIDGE INDUSTRIAL PARK, THREE LEGGED CROSS
WIMBORNE, DORSET, BH21 6SF Tel: 01202 824541

Dwg. No: 44691S104 — Rev. 1
Checked: JBaker — Date: 7.8.02

THIS DRAWING IS THE PROPERTY OF ROLLALONG AND MAY NOT BE COPIED OR REPRODUCED WITHOUT PERMISSION IN WRITING FROM ROLLALONG.