


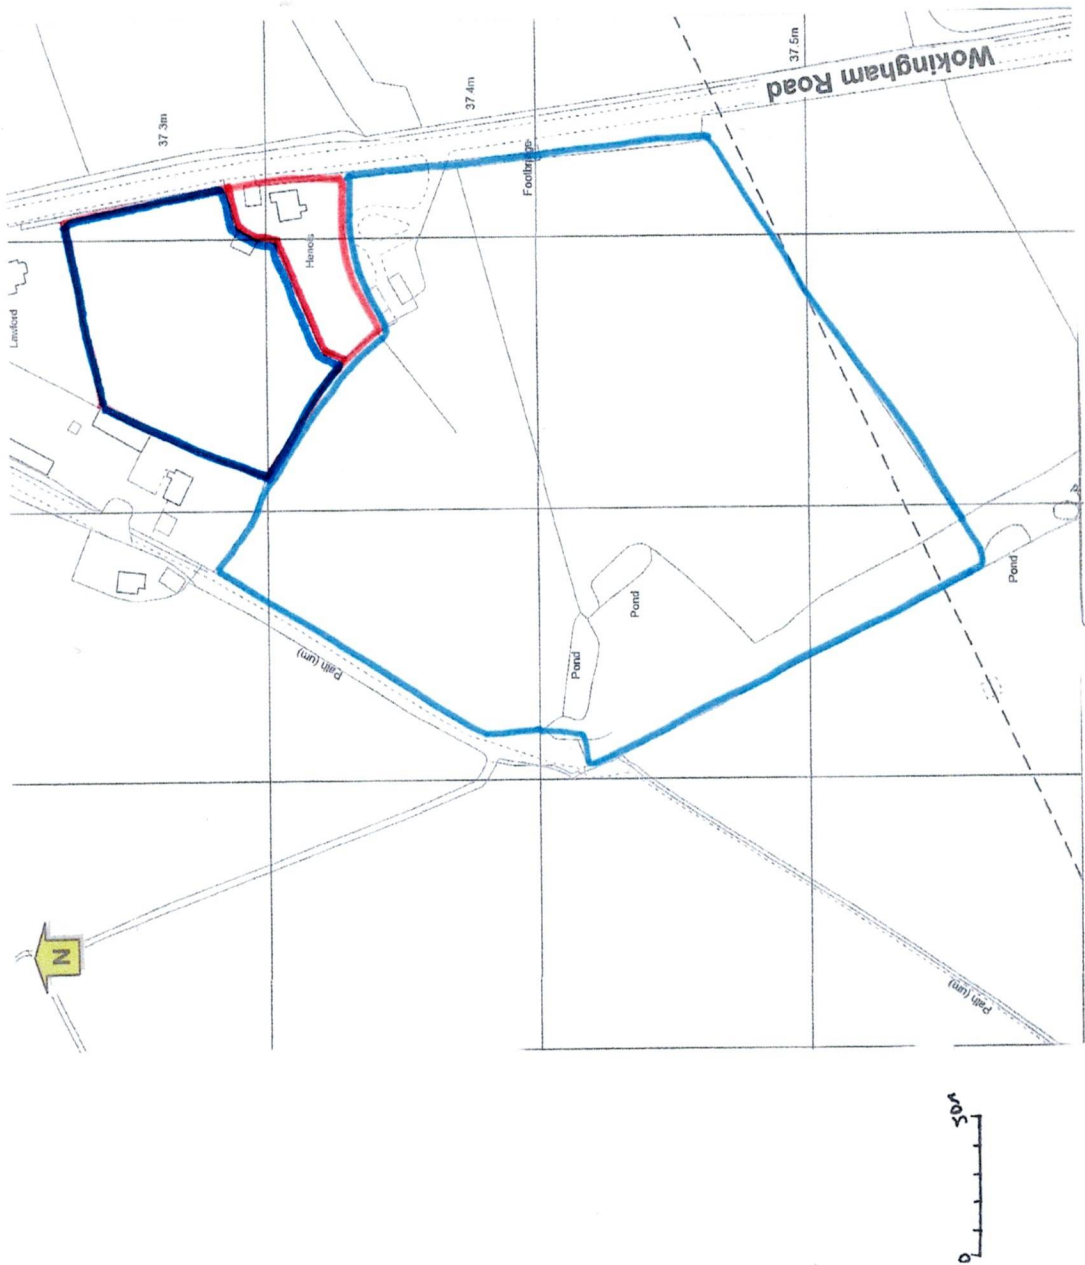

Do not scale except for planning & building regulations purposes

Licence number 100046766

Mark Leedale Planning Chartered Town Planning Consultants

57 Abbey Street,
Farnham,
Surrey GU9 7RJ
01252 718855
markleedale@hotmail.com

Revision notes:

- A 26.5.24 Red line altered at lpa request
- B
- C

Client:

S Holdstock Esq.

Location:

Heriots, Wokingham Road, Hurst

RG10 0RX

Drawing title:

Location plan

Scale:

1:2,500 @A4

Date:

July 2022

Drawing number:

MLP/01 A