99/69957/F

APPROVED PLANS

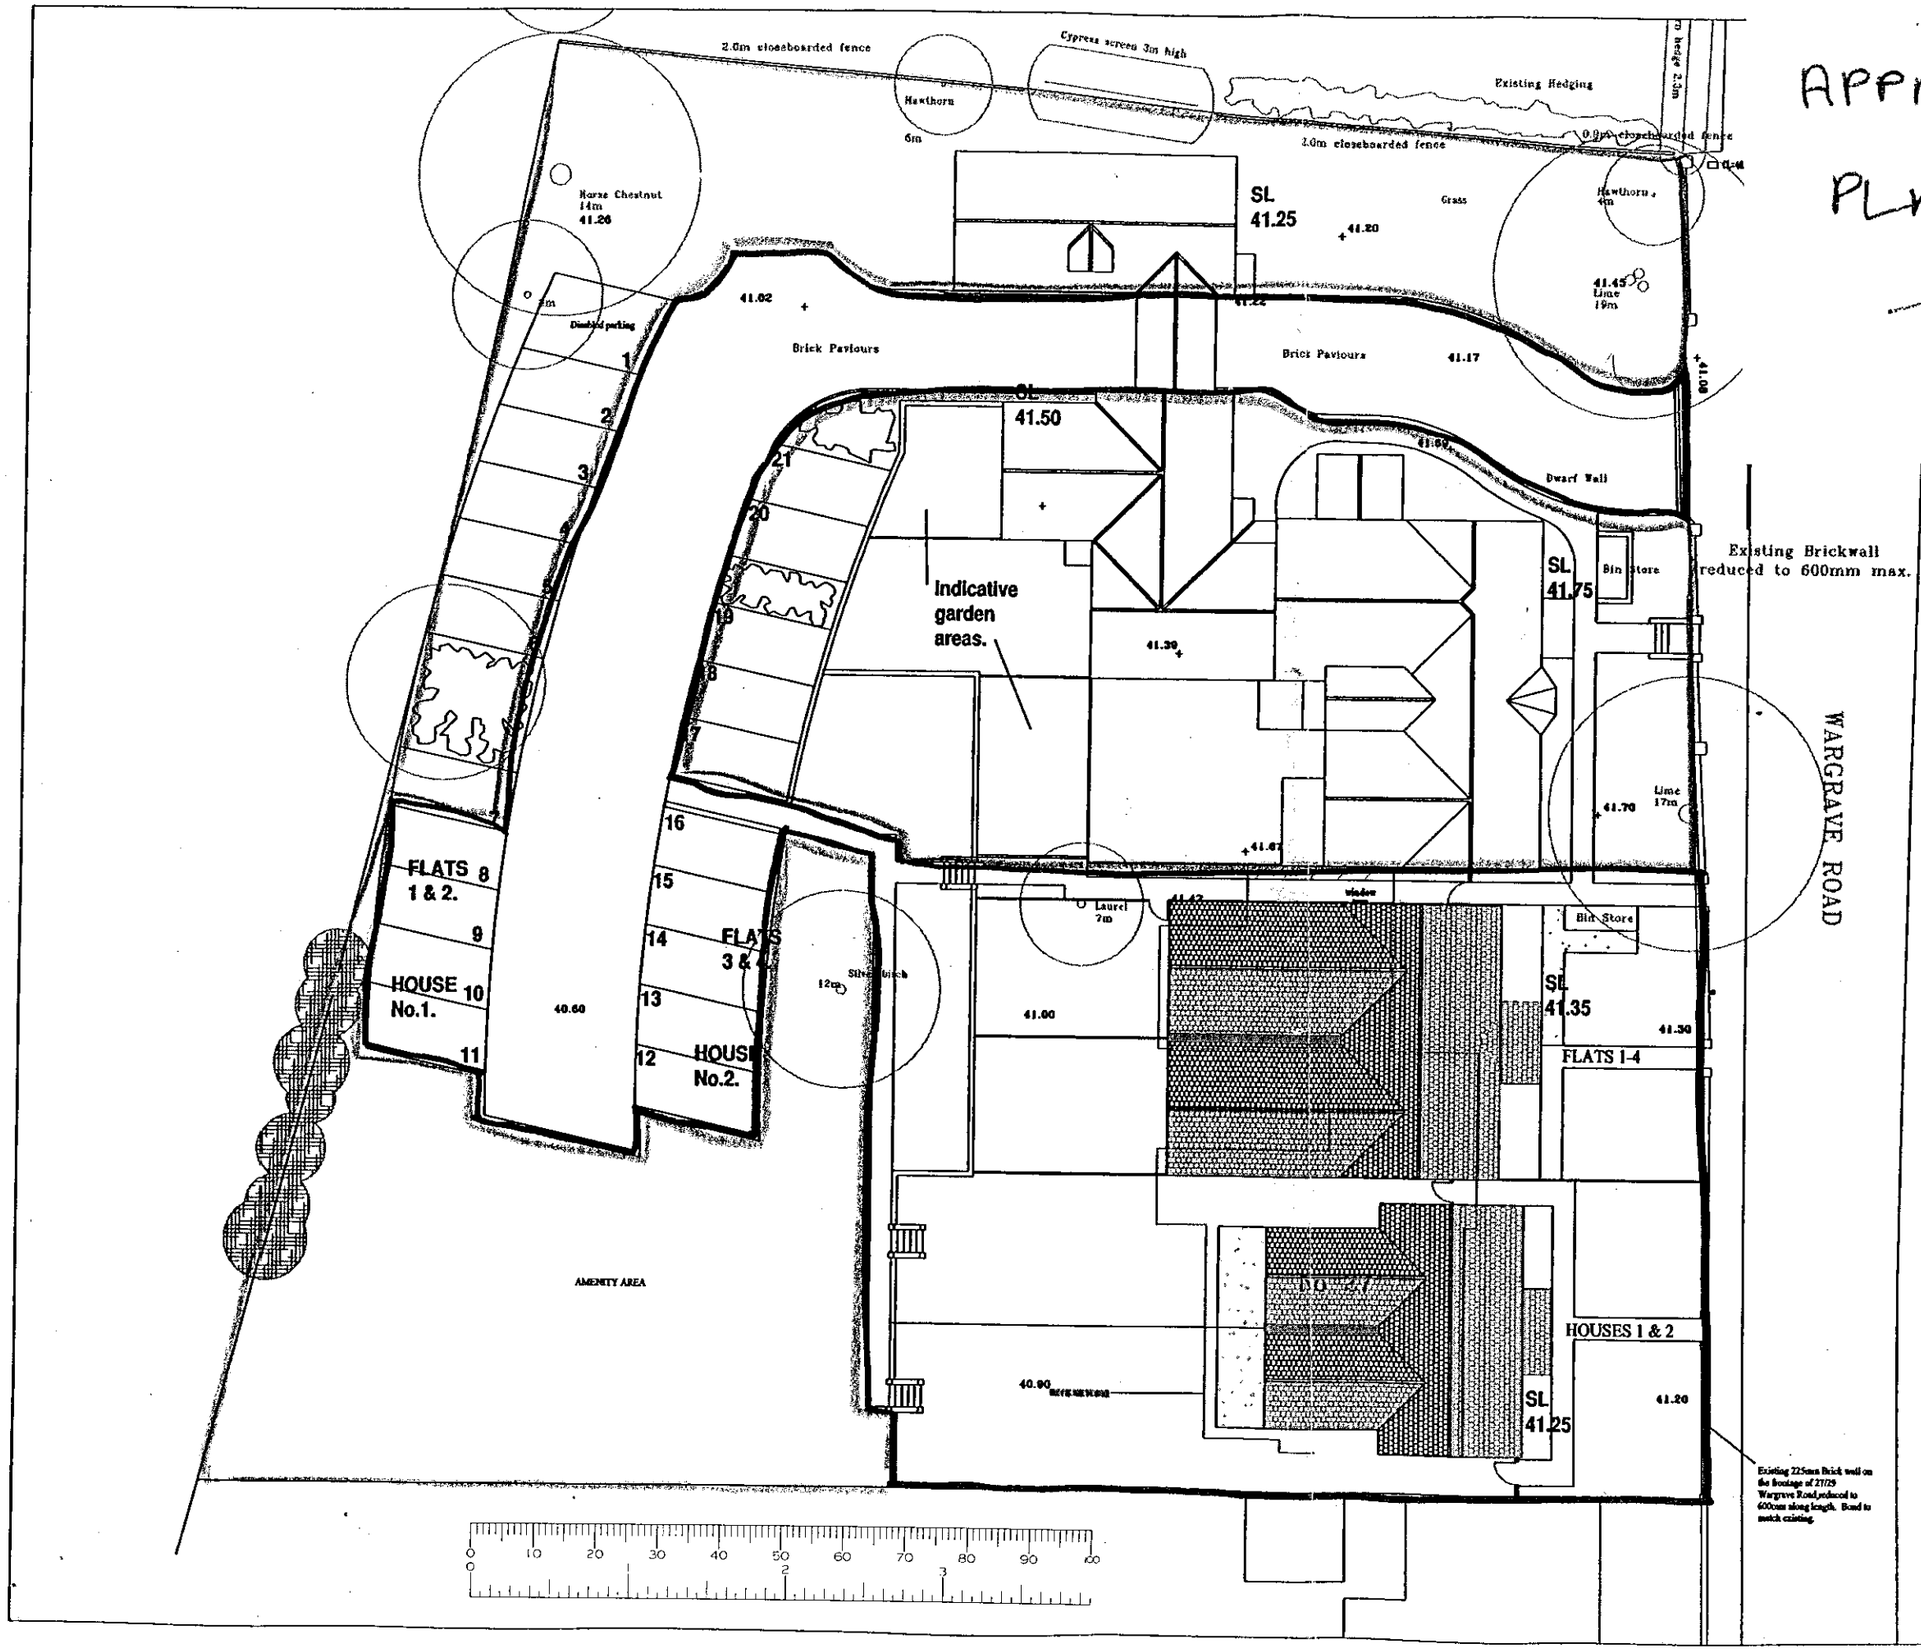

Notes:Porch and windows altered, chimney removed.

Notes:General alterations.

Notes:Amended to L/A comments.

Notes:Amended to L/A comments.

ED

The KEEN Partnership

Culham House, 122 Castle Reading, Berks RG1 7RJ

Client:

T.V.H.A.

Job Title: Proposed development at: 27/29 Wargrave Road, Twyford, Berkshire.

Drawing Title:

Site Layout.

Scale: 1/250.

A3

Date: Oct. 99.

Drawn By: P.J.M.

Drawing No.: 7011-99-01D

0118 9510855 Fax: 0118 9510

E-mail: keen.partnership@virgin.net

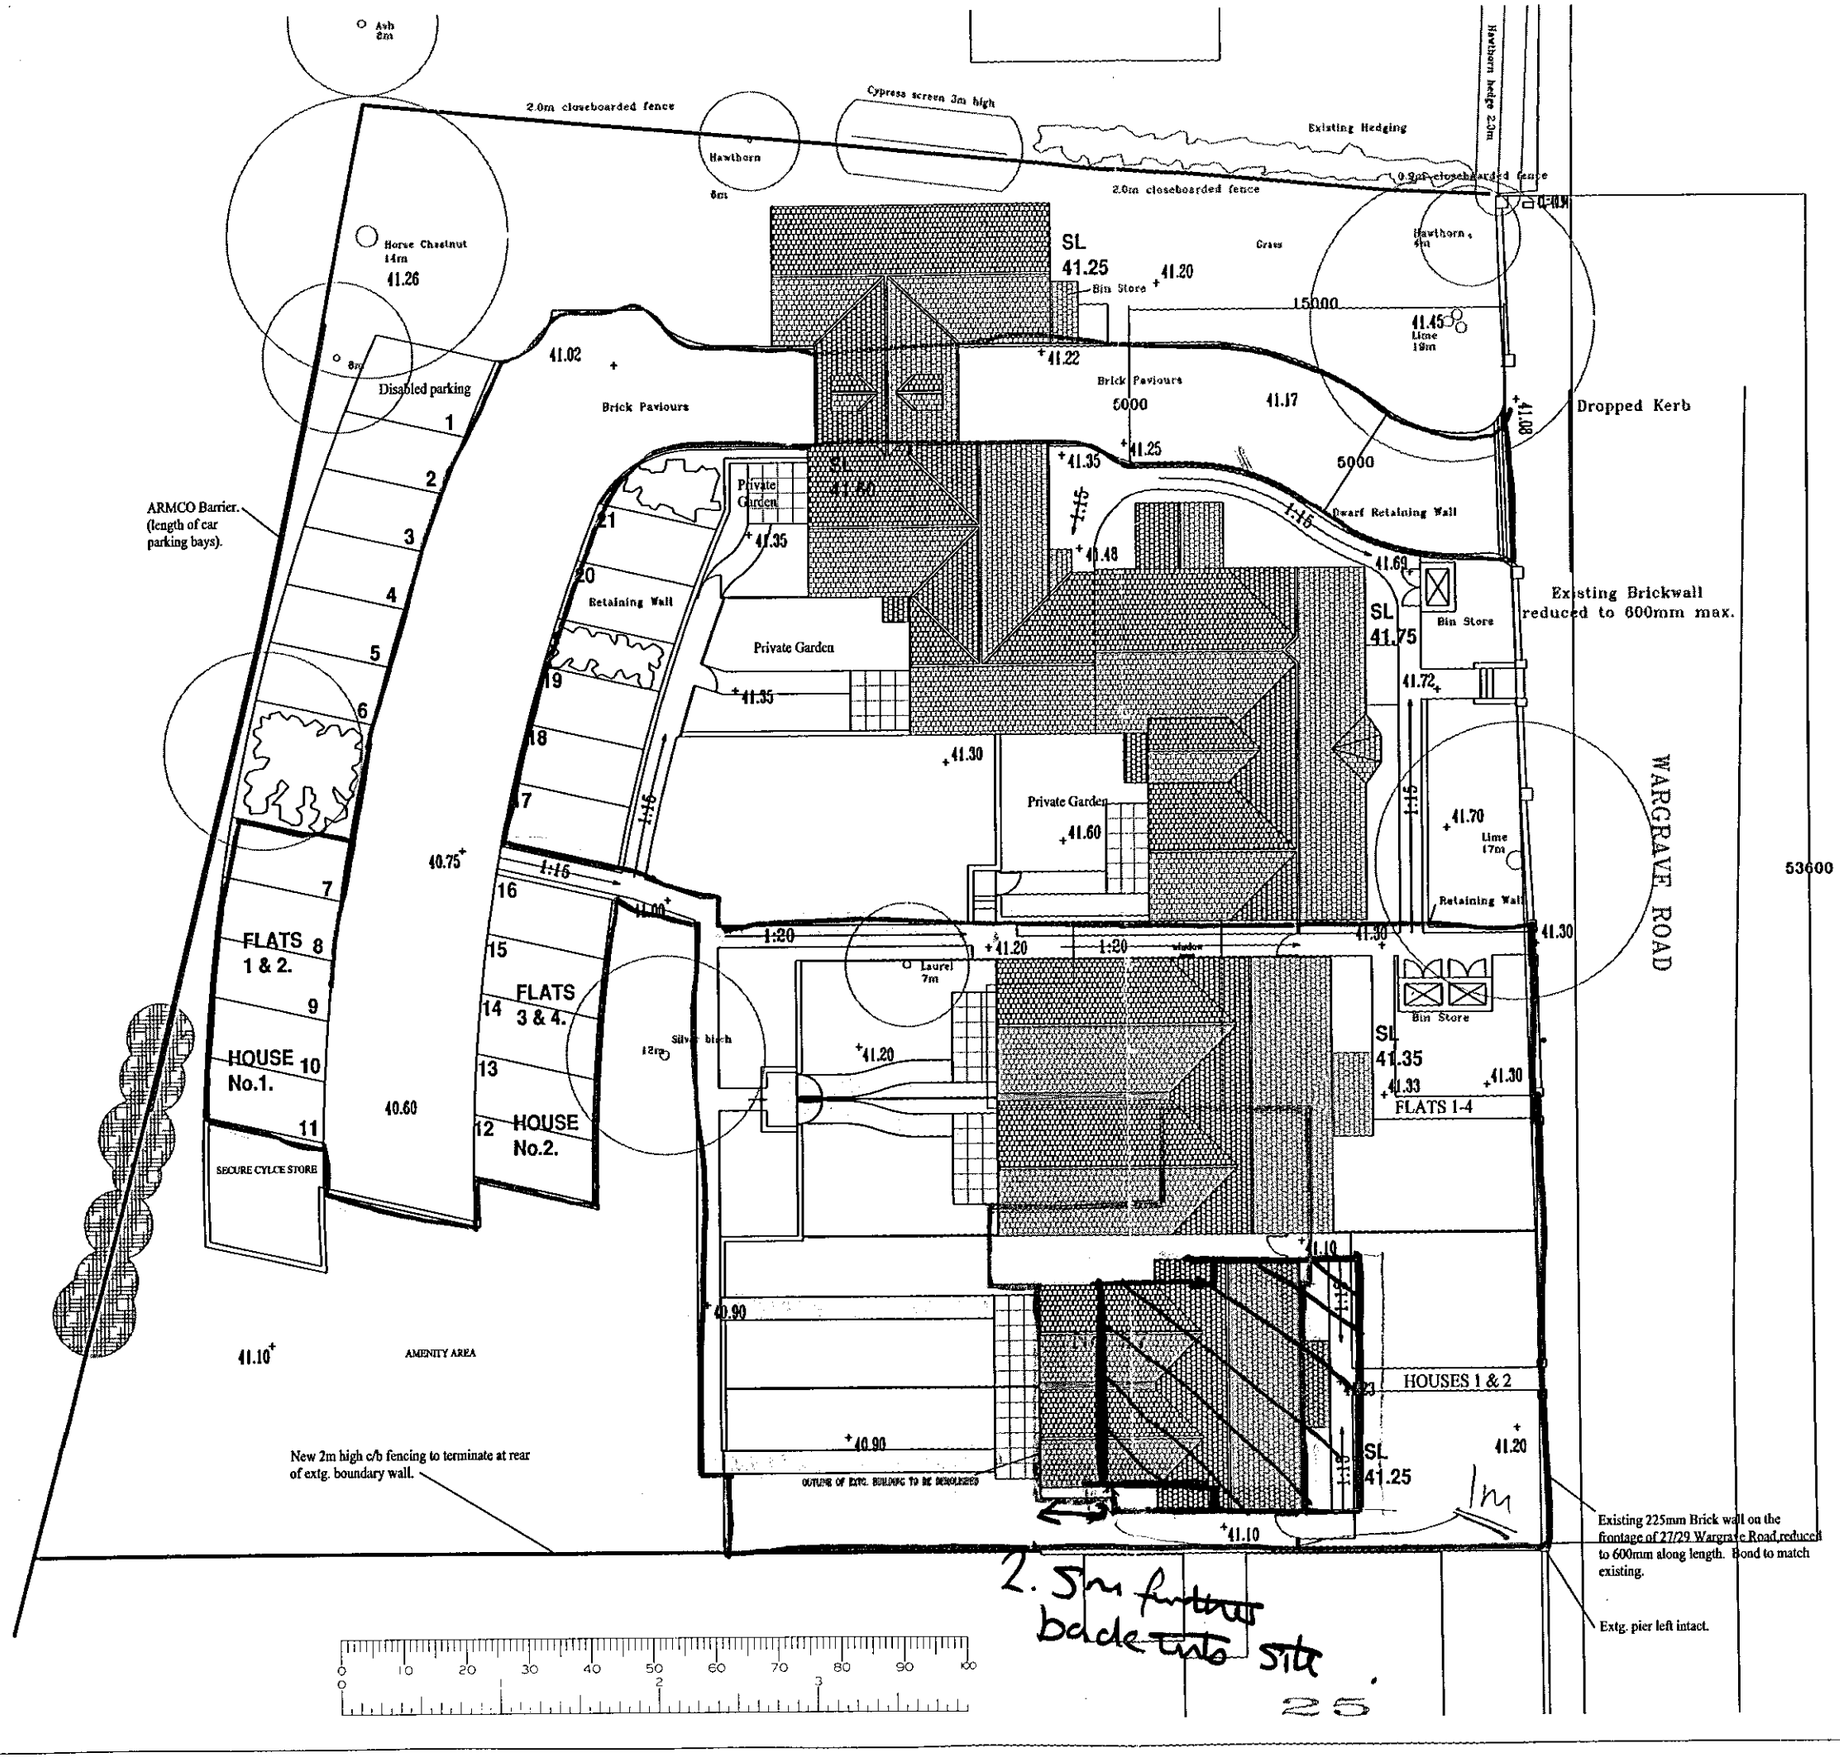

Revision:	Date:	Notes:
A	Oct 99	Porch and windows altered, Chimney removed
B	Oct 99	General Alterations
C	Oct 99	Amended to L.A. comments
D	Oct 99	Amended to L.A. comments
E	Mar 00	Amended to planning conditions

18.MAR2000* 0910

Same red line

Previous approval

Back of existing house.

HOUSES 1 & 2 repositioned further back on site

The KEEN Partnership

Culham House, 122 Castle Street
Reading, Berks RG1 7RJ

Client:
TVHA

Job Title:
Proposed Development at:
27/29 Wargrave Road,
Twyford,
Berkshire

Drawing Title:
Site Layout

Scale: 1/250 A3

Date: Oct 99

Drawn By:

Drawing No.: 7011-99-01E

Tel: 0118 9510855 Fax:0118 9510866
E-mail: info@keenpartnership.co.uk

Revision:	Date:	Notes:
A	Oct 99	Porch and windows altered, Chimney removed
B	Oct 99	General Alterations
C	Oct 99	Amended to L.A. comments
D	Oct 99	Amended to L.A. comments
E	Mar 00	Amended to planning conditions

16.MAR2000* 0910

APPROVED

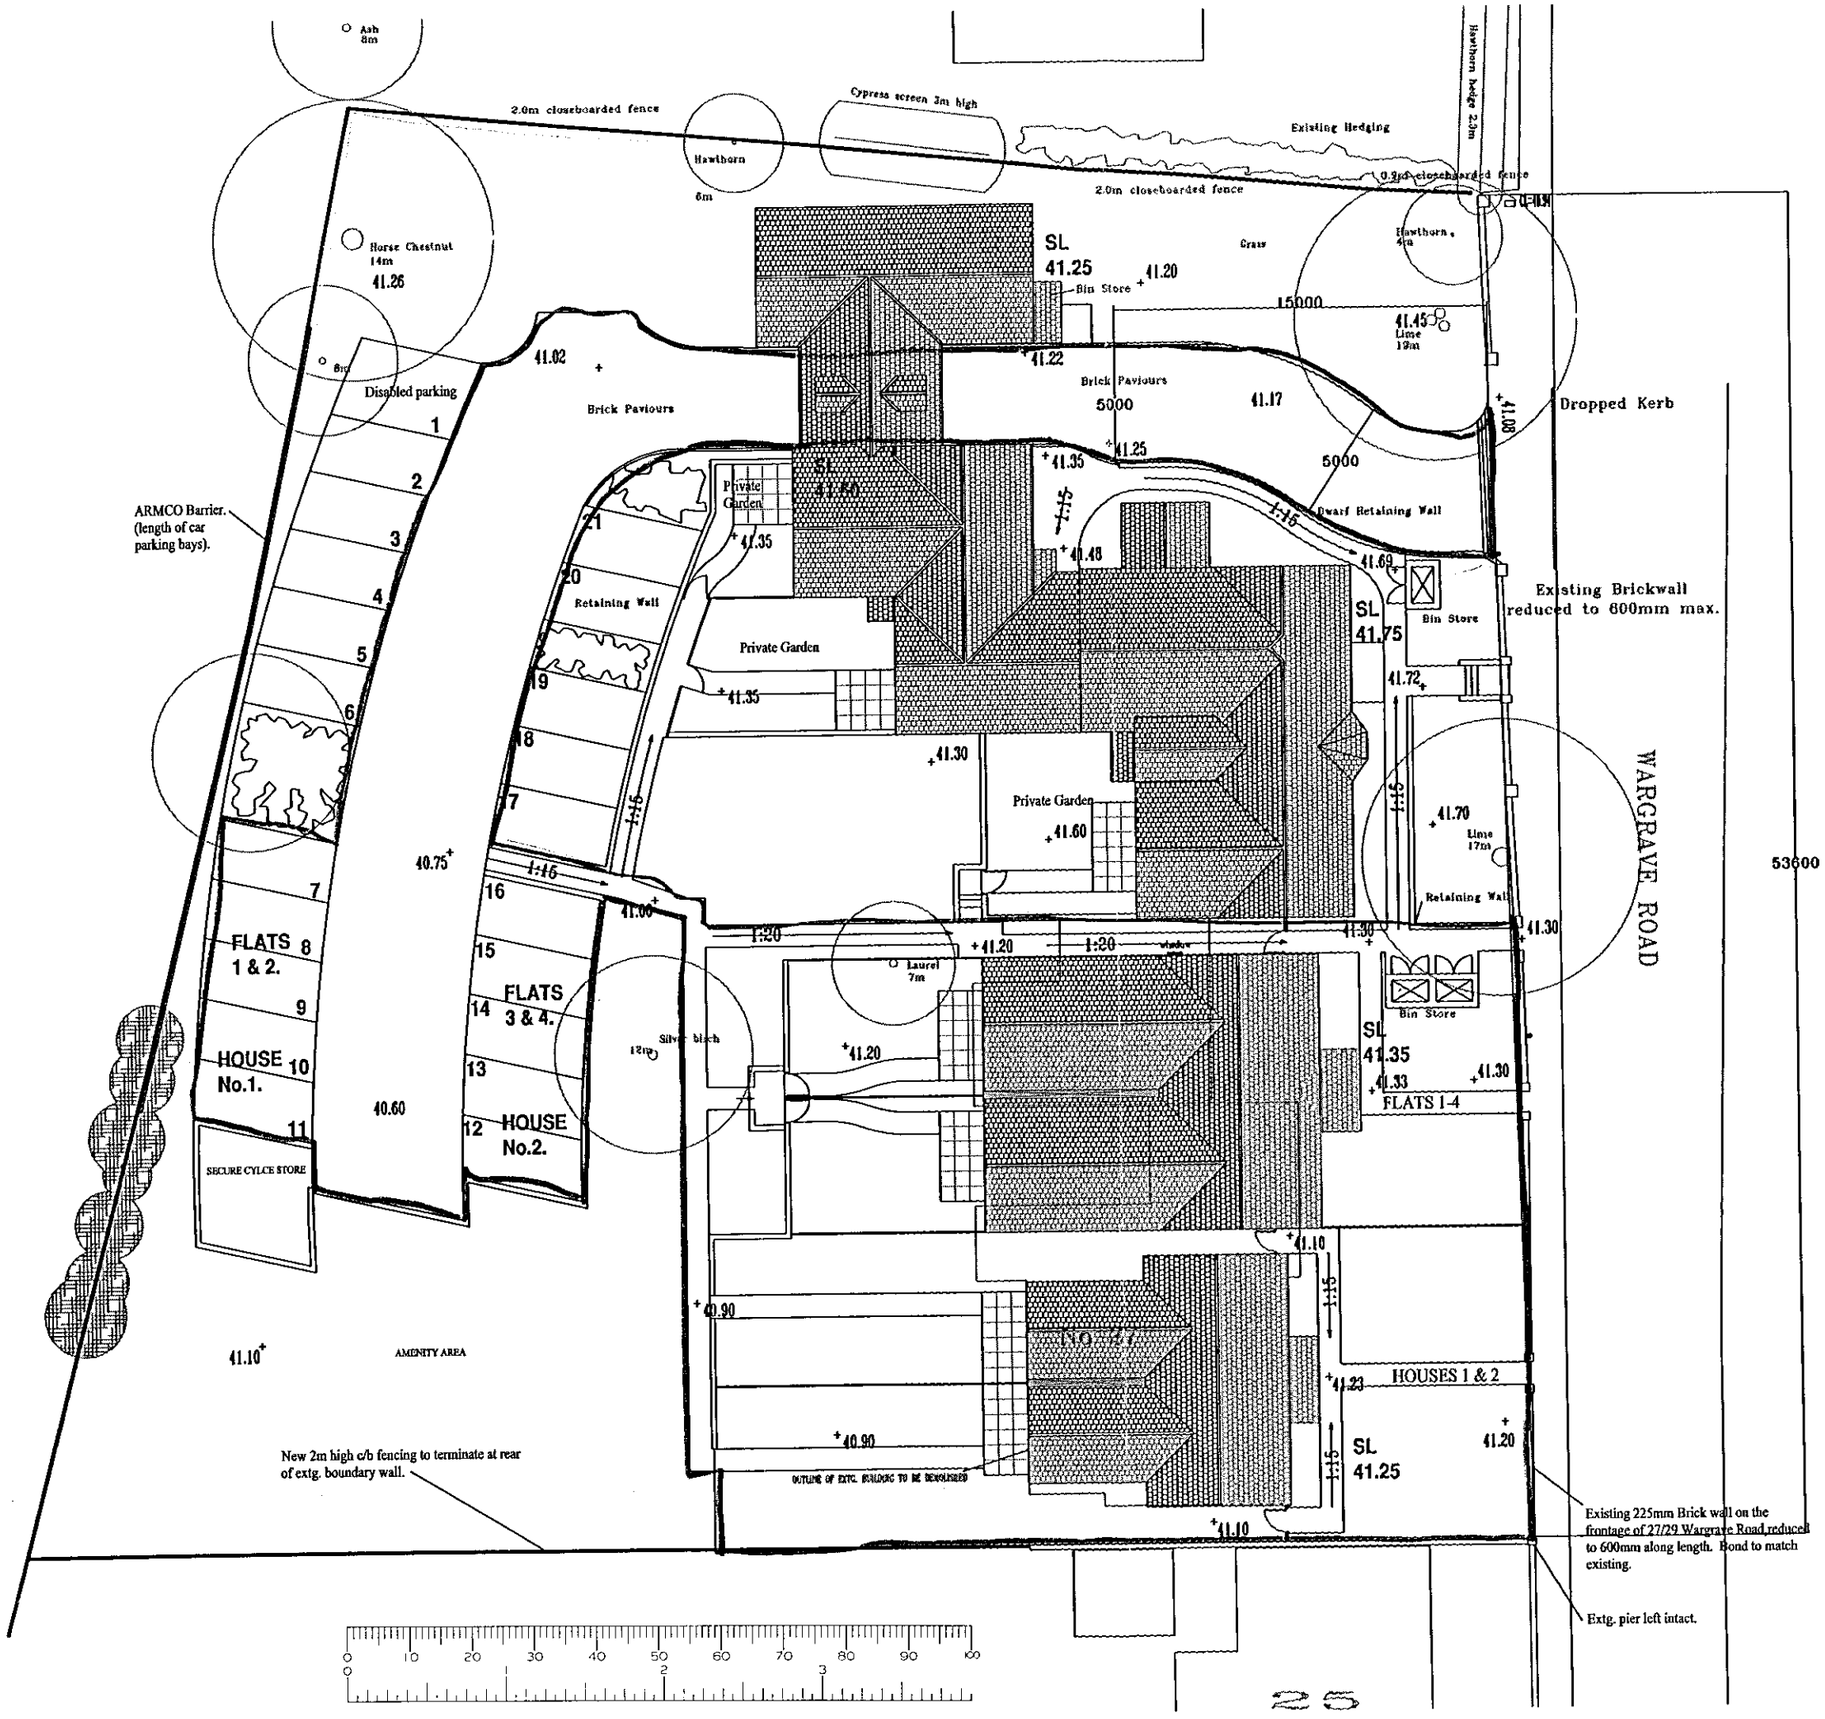

HOUSES 1 & 2 repositioned further back on site

The KEEN Partnership

Culham House, 122 Castle Street
Reading, Berks RG1 7RJ

Client:
TVHA

Job Title:
Proposed Development at:
27/29 Wargrave Road,
Twyford,
Berkshire

Drawing Title:
Site Layout

Scale: 1/250 A3

Date: Oct 99

Drawn By:

Drawing No.: 7011-99-01E

Tel: 0118 9510855 Fax:0118 9510866
E-mail: info@keenpartnership.co.uk



FRONT ELEVATION

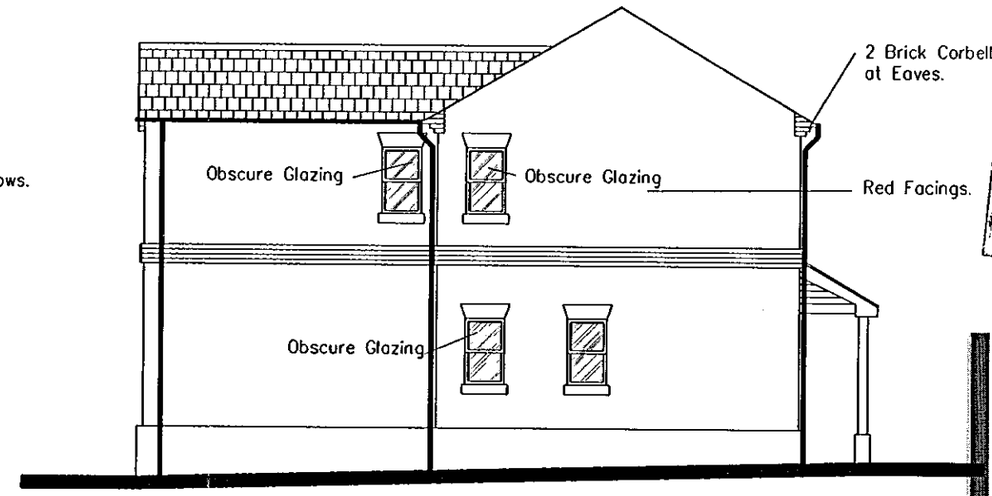

SIDE ELEVATION

Revision:A	Date:Oct. 99.	Notes:Porch and windows altered, chimney removed.
Revision:B	Date:Oct. 99.	Notes:General alterations.
Revision:C	Date:Oct. 99.	Notes:Amended to L/A comments.
Revision:D	Date:Oct. 99.	Notes:Amended to L/A comments.

APPROVED

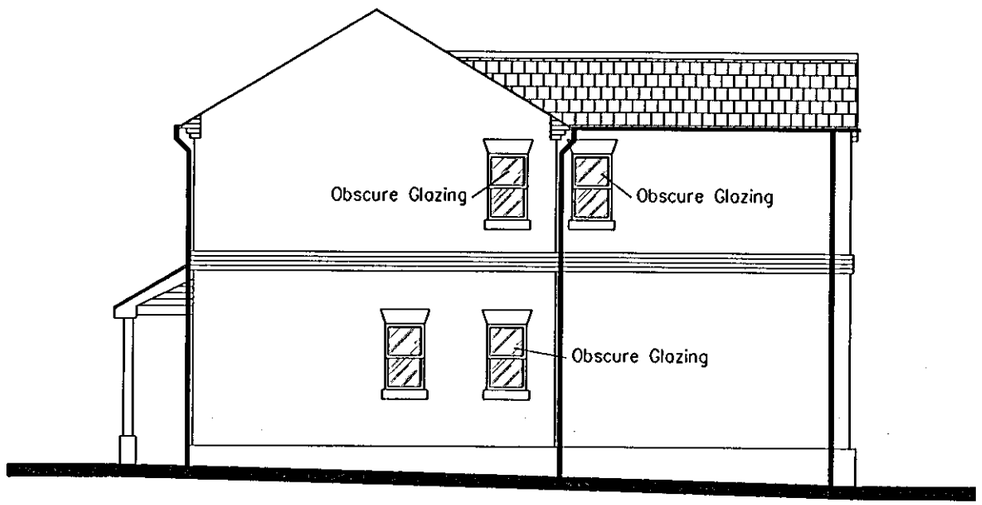

SIDE ELEVATION

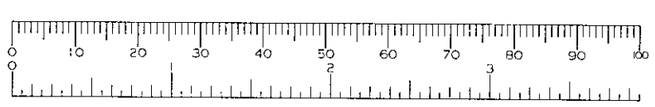

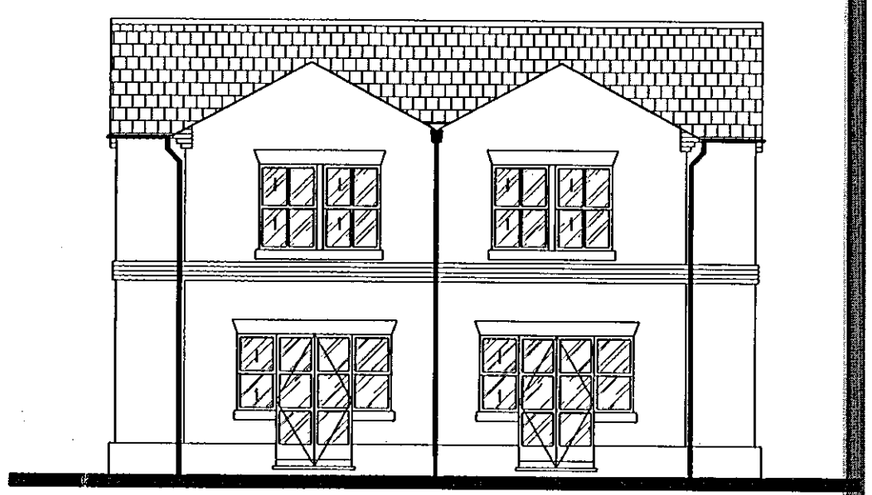

REAR ELEVATION

The KEEN Partnership
Culham House, 122 Castle
Reading, Berks RG1 7RJ

Client:

T.V.H.A.

Job Title: **Proposed development at: 27/29 Wargrave Road, Twyford, Berkshire.**

Drawing Title:

ELEVATIONS. HOUSES 1 & 2.

Scale: **1/100.** A3

Date: **Feb. 2000.** Drawn By:

Drawing No.: **7011-00-113.**

0118 9510855 Fax: 0118 951(
E-mail: keen.partnership@virgin.net

APPROVED

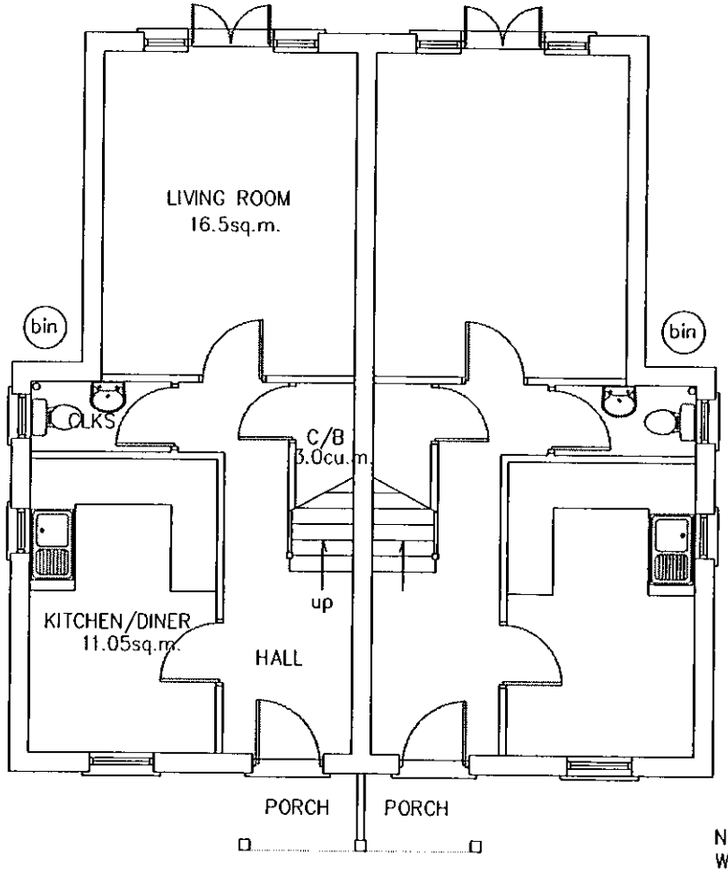

GROUND FLOOR PLAN

NOTE:
Windows to be timber framed painted white.
Timber porch to be painted white.

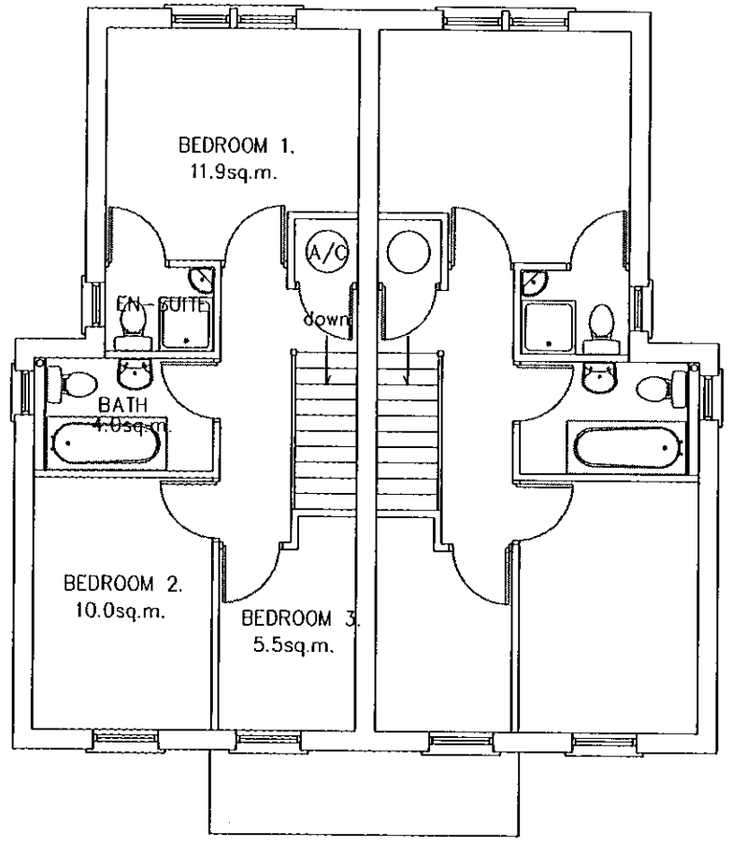

FIRST FLOOR PLAN



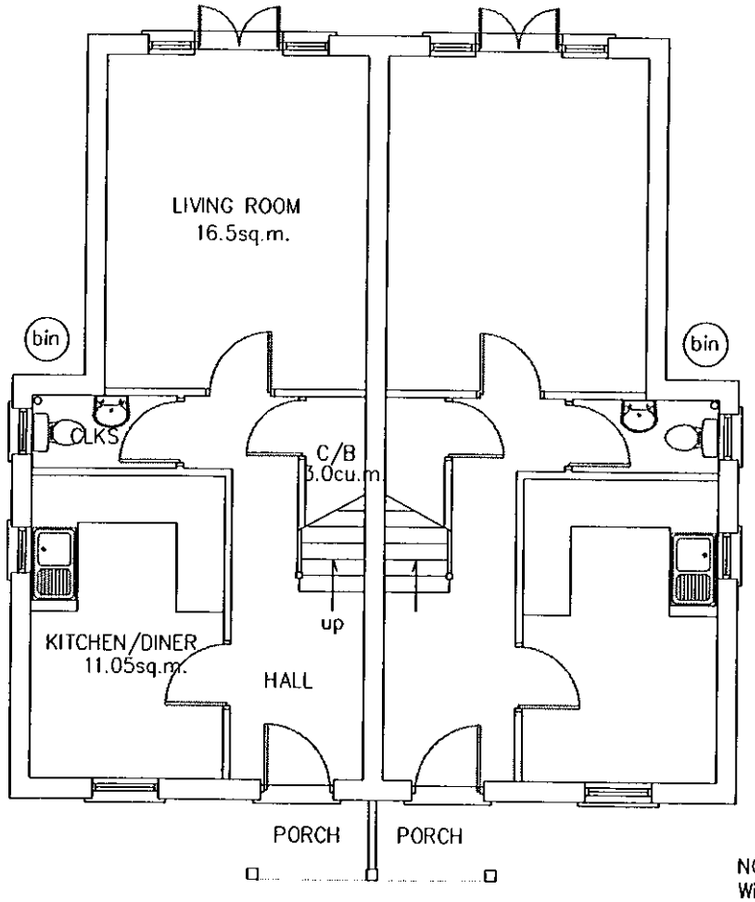

GROUND FLOOR PLAN

NOTE:
Windows to be timber framed painted white.
Timber porch to be painted white.

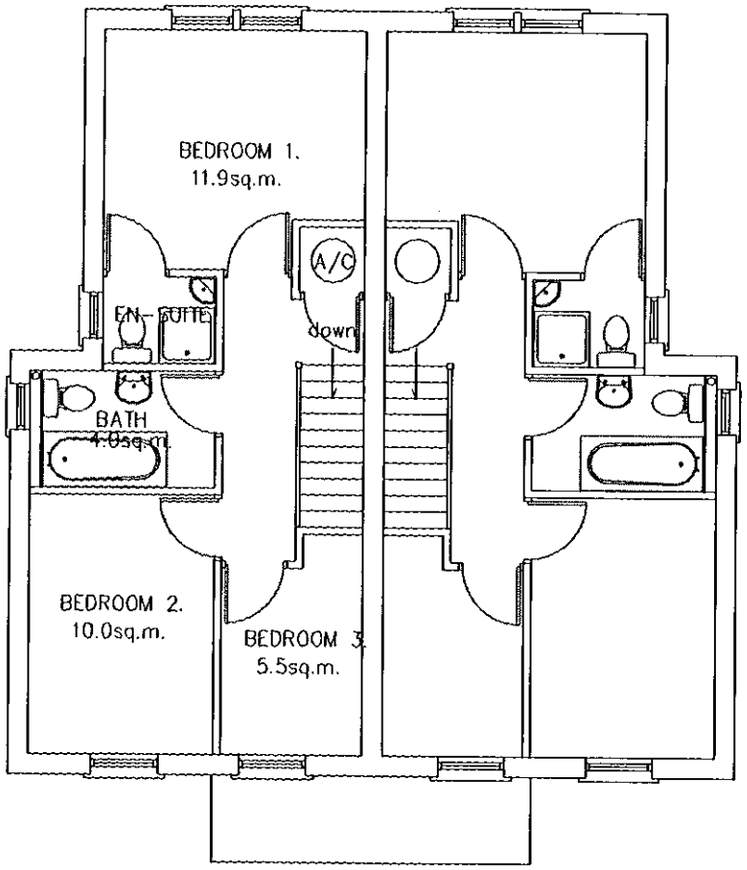

FIRST FLOOR PLAN

APPROVED

Same as previous approval.

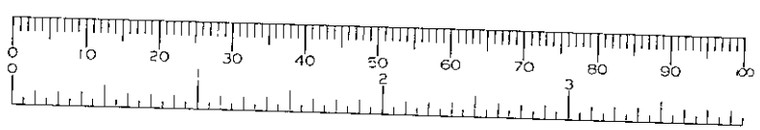

NOT PART OF
DECISION.
FOR INFO ONLY.



'ATION



SIDE ELEVATION

From No. 25

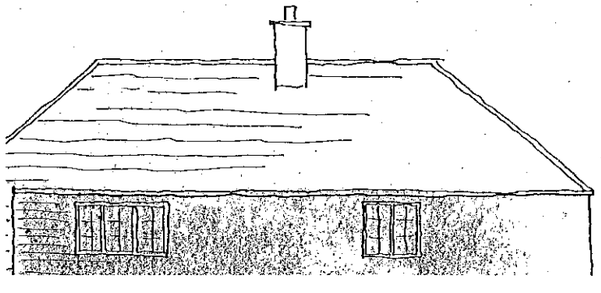

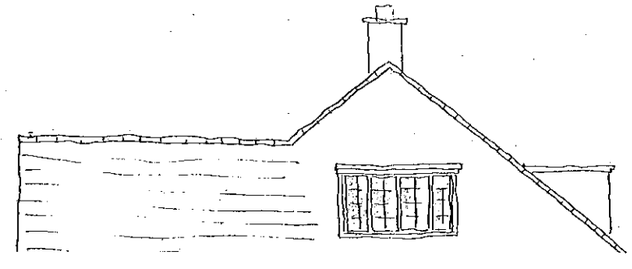

10 APR 2000
COPIES TO:
FILE:
CS
APP
DC
POL
PLANNING SEC

A		
	Date	Revisio

KE
Chartered Buildi
Architectural Desig
& Building En
Culham H
122 Castle
READING R
Tel: 0118 9
Fax: 0118 9

The Association of BUILDING ENGINEERS

Client

THAMES VALLEY HOUSING

Job Title

RESIDENTIAL DEVELOPMENT

27 - 29 WARGRAVE ROAD

TWYFORD

1:100

Drawing Title