APPROVED

REVISED PLAN

Anglian Home improvements

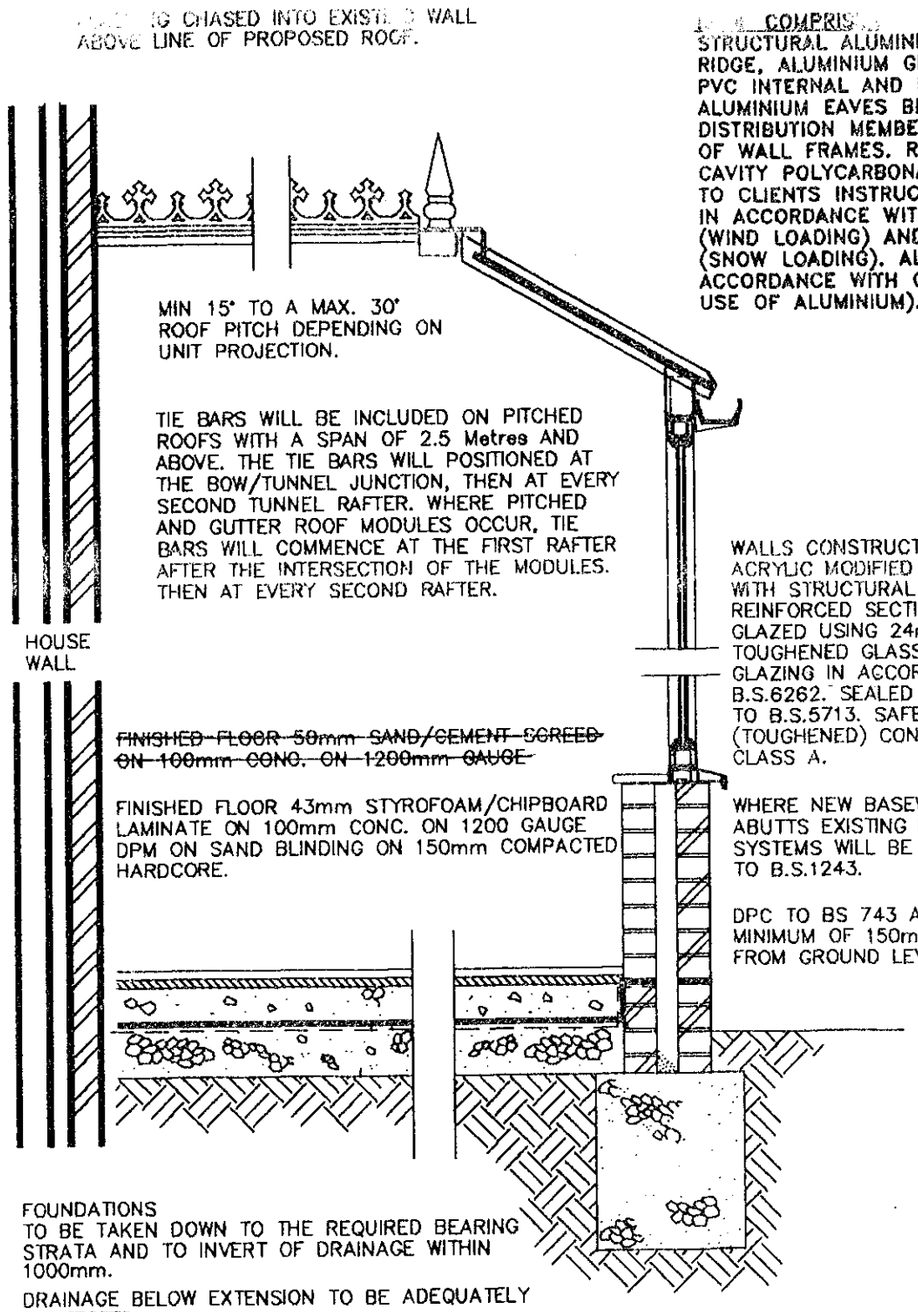

...G CHASED INTO EXISTI... WALL ABOVE LINE OF PROPOSED ROOF.

MIN 15° TO A MAX. 30° ROOF PITCH DEPENDING ON UNIT PROJECTION.

TIE BARS WILL BE INCLUDED ON PITCHED ROOFS WITH A SPAN OF 2.5 Metres AND ABOVE. THE TIE BARS WILL POSITIONED AT THE BOW/TUNNEL JUNCTION, THEN AT EVERY SECOND TUNNEL RAFTER. WHERE PITCHED AND GUTTER ROOF MODULES OCCUR, TIE BARS WILL COMMENCE AT THE FIRST RAFTER AFTER THE INTERSECTION OF THE MODULES. THEN AT EVERY SECOND RAFTER.

~~FINISHED FLOOR 50mm SAND/CEMENT SCREED ON 100mm CONC. ON 1200mm GAUGE~~

FINISHED FLOOR 43mm STYROFOAM/CHIPBOARD LAMINATE ON 100mm CONC. ON 1200 GAUGE DPM ON SAND BLINDING ON 150mm COMPACTED HARDCORE.

FOUNDATIONS
TO BE TAKEN DOWN TO THE REQUIRED BEARING STRATA AND TO INVERT OF DRAINAGE WITHIN 1000mm.

DRAINAGE BELOW EXTENSION TO BE ADEQUATELY PROTECTED

COMPRIS...
STRUCTURAL ALUMINIUM, VENTILATED RIDGE, ALUMINIUM GLAZING BARS WITH PVC INTERNAL AND EXTERNAL CAPPINGS. ALUMINIUM EAVES BEAM (LOAD DISTRIBUTION MEMBER) SECURED TO TOP OF WALL FRAMES. ROOF GLAZING TO MULTI-CAVITY POLYCARBONATE OR GLASS SHEETS TO CLIENTS INSTRUCTIONS. ROOF DESIGNED IN ACCORDANCE WITH CP3 CHAPTER 5 (WIND LOADING) AND BS 6399 PART 3 (SNOW LOADING). ALL DESIGNED IN ACCORDANCE WITH CP118 (STRUCTURAL USE OF ALUMINIUM).

WALLS CONSTRUCTED IN ACRYLIC MODIFIED PVCu WITH STRUCTURAL ALUMINIUM REINFORCED SECTIONS AND GLAZED USING 24mm O/A TOUGHENED GLASS SEALED UNITS. GLAZING IN ACCORDANCE WITH B.S.6262. SEALED UNITS CONFORM TO B.S.5713. SAFETY GLASS (TOUGHENED) CONFORMS TO B.S.6206, CLASS A.

WHERE NEW BASEWALL / BRICKWORK GABLE ABUTTS EXISTING PROPERTY, FIXING SYSTEMS WILL BE USED IN ACCORDANCE TO B.S.1243.

DPC TO BS 743 AND A MINIMUM OF 150mm FROM GROUND LEVEL.

NOTE:- CONSERVATORIES WITH A PITCHED TRANSLUCENT ROOF, UNDER 30m² AREA, ARE NOT SUBJECT TO BUILDING REGULATIONS, PROVIDED IT IS BUILT AT GROUND LEVEL.

TYPICAL SECTION

NOTE:
This cross sectional drawing is shown as a "Typical Example" And is intended for information purposes only. Site Conditions and sub-soil bearing strata will dictate final Design.

DWG: SHT2NVBW REV: E

PROPOSED . PVCu CONSERVATORY.
AT . . . . . 24 MAYS ROAD
WOKINGHAM
RG40 1RW

FOR . . . . MR & MRS DAVISON

COPIES TO: ACK: FILE: 01 JUN 2000 CS APP DC POL PLANNING

SURVEYOR: PLEASE CONFIRM THAT ALL THE ABOVE DETAILS ARE CORRECT. . YES ☑

DATE.	REVISIONS.	BY.
5/4/2000	WIDTH & FACET DIMENSIONS AMENDED.	KH.
17/4/2000	FACET ANGLES CHANGED.	KH.
31/5/00	UNIT RE-DRAWN TO CUSTOMERS SPECIFICATION	A.SMITH

DRAWING No. 099/01242A	DRAWN BY.. Roy Leftwich	DATE 29/03/00
BRANCH NAME	SURVEYOR.. KATE HENNING.	DATE 31/5/2000

The Company Surveyor has discussed the above survey with me and I agree to the designs and other details finalised during the Surveyor's visit and I understand that I must settle the account with the Installers upon completion.

Customers Signature ..... Date 1/4/00.

Expected Installation Date
ASAP AFTER PLANNING.

Comments on deferred installation
.....

Method of payment
INT. FREE FINANCE.

Code
.....

Confirmed with customer as:
INT. FREE FINANCE.
(Anglian does not accept final balance payment by credit card.)

APPROVAL REQUIRED ☑ Where applicable

PLANNING PERMISSION	YES ☑	NO ☐	RESTRICTIVE COVENANTS	YES ☐	NO ☑
BUILDING REGULATION	YES ☐	NO ☑	HOUSING ASSOC. CONSENT	YES ☐	NO ☑
LISTED BUILDING CONSENT	YES ☐	NO ☑	BUILDERS CONSENT	YES ☐	NO ☑
CONSERVATION AREA	YES ☐	NO ☑	LANDLORDS CONSENT	YES ☐	NO ☑

APPROVED
REVISED PLAN

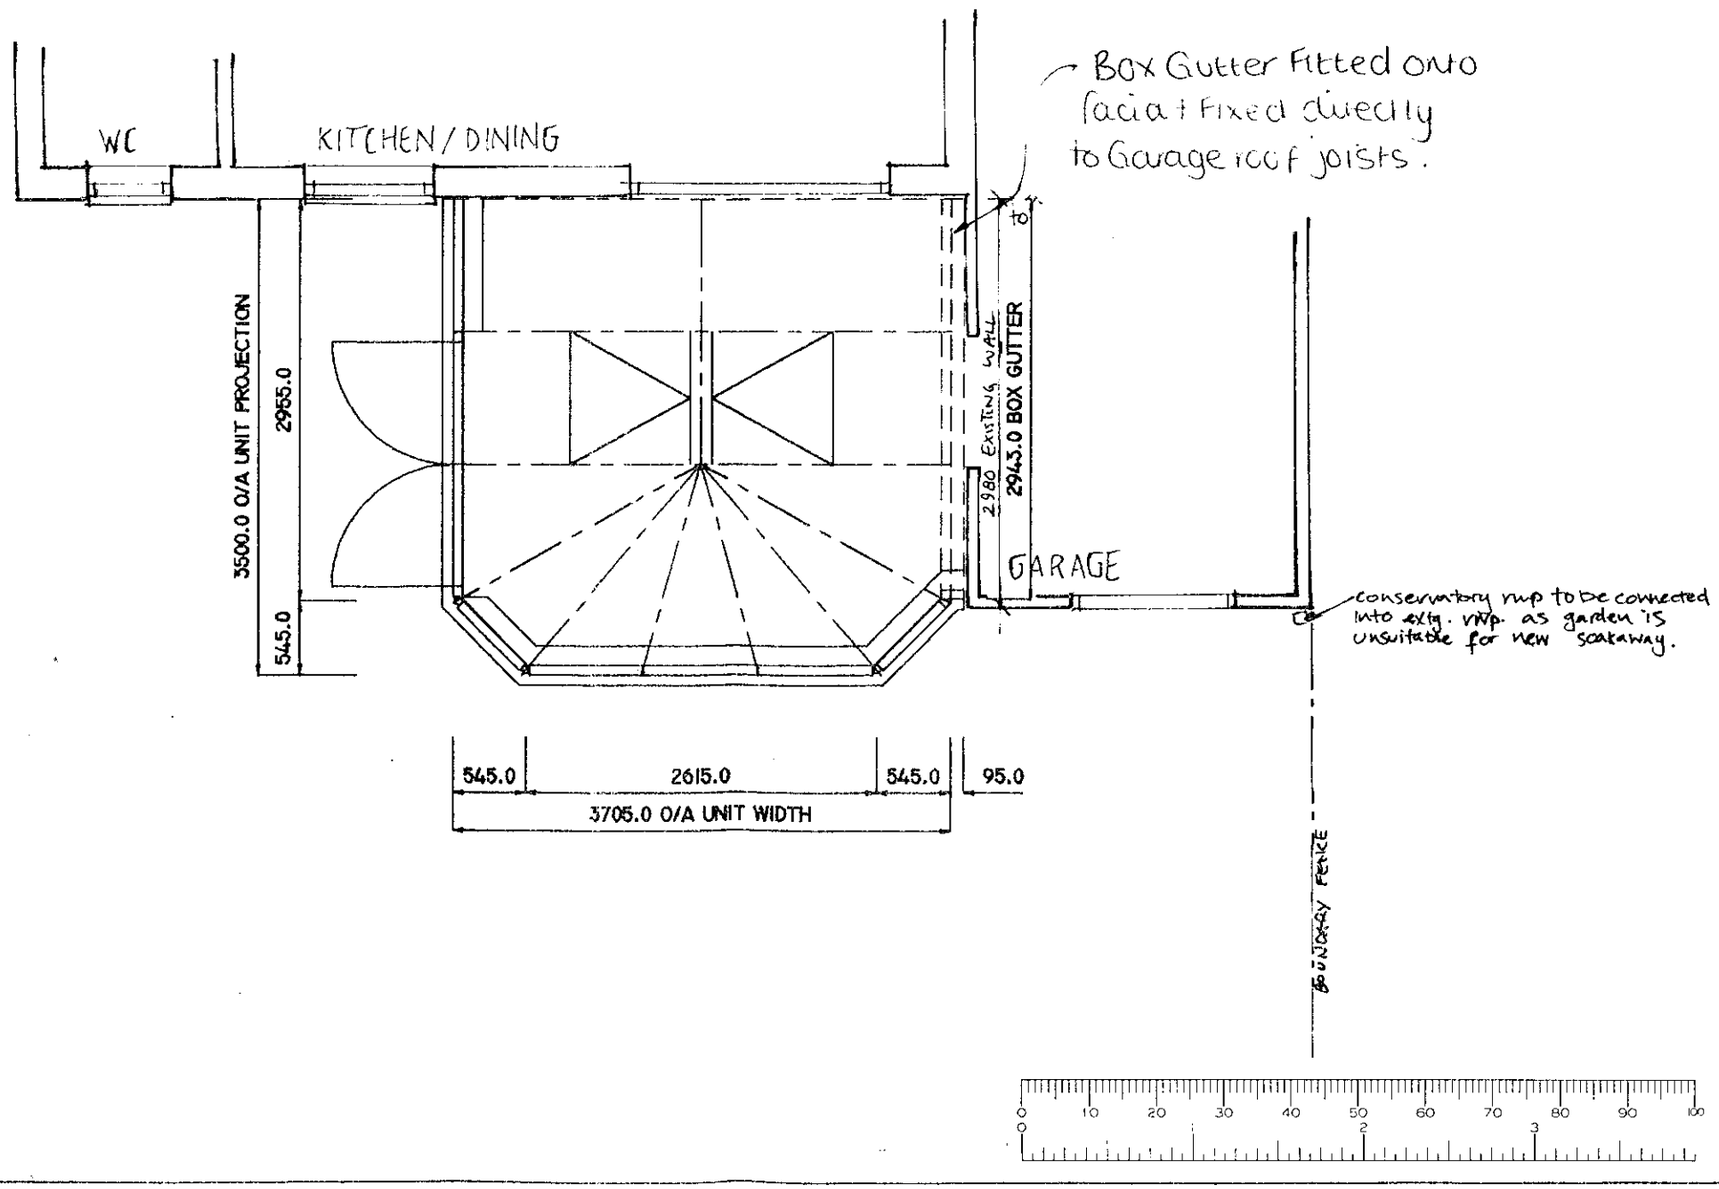

Customers Signature	Date
.....	.....

Drawing No.	Unit Elevation.
099/01242A	PLAN LAYOUT / ROOF DETAILS.

Scale..	Drawn..
1:50	NJT
Date.. 31/05/00	Surveyor.

APPROVED
REVISED PLAN

BARGE BOARDS APPROX 7-9m each TO BE FITTED TO FRONT & REAR OF PROPERTY AT SAME TIME AS CONSERVATORY IS INSTALLED

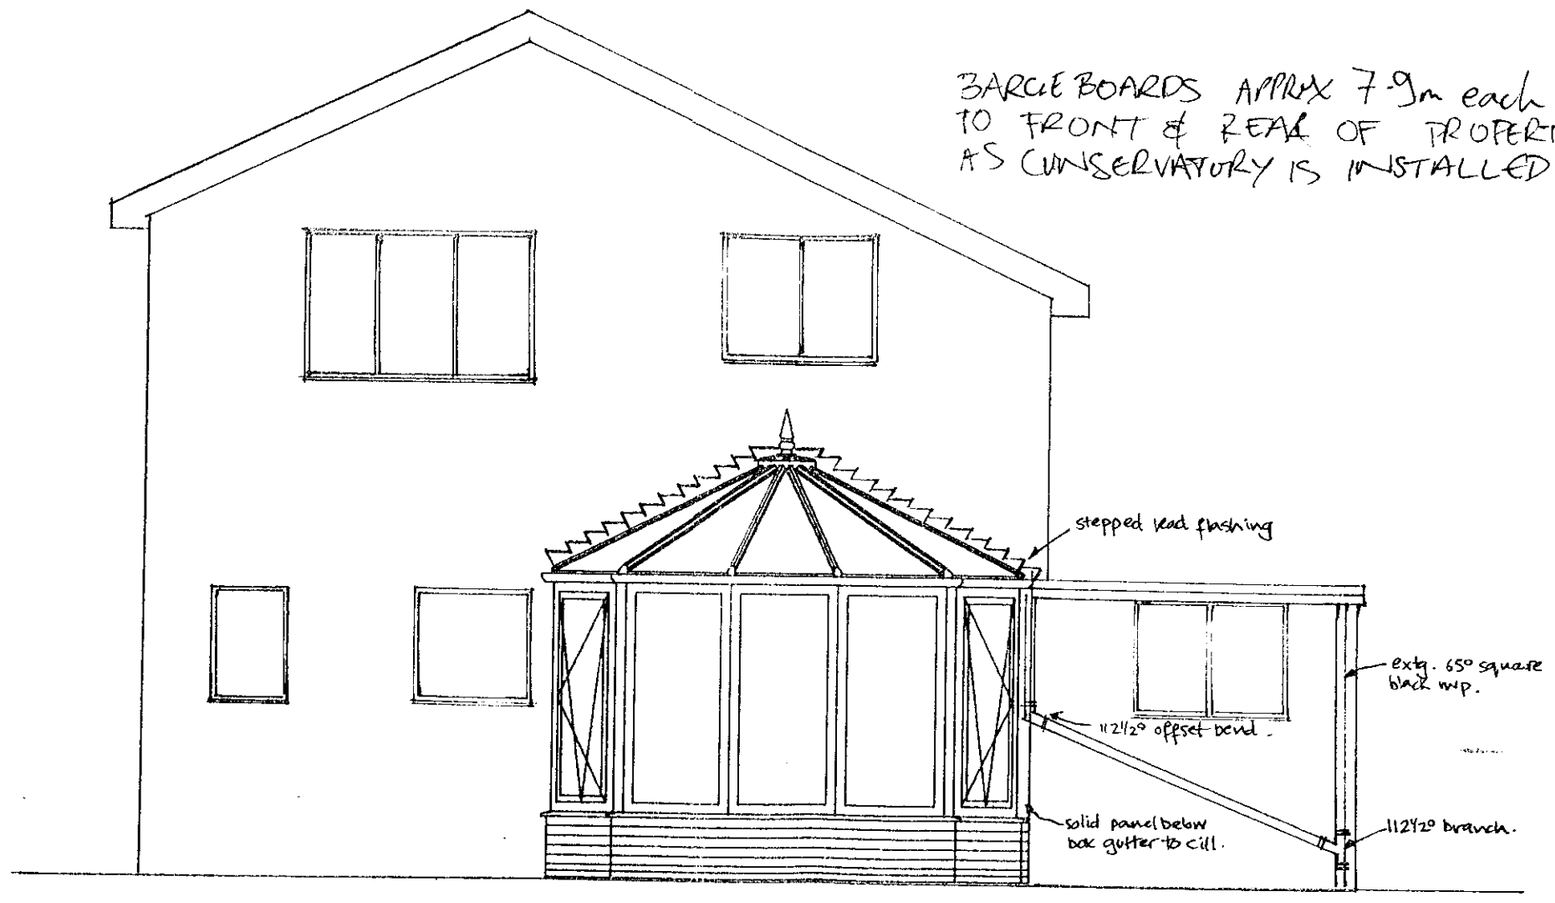

SPECIFICATION:
1 NO. DOUBLE DOOR WHERE SHOWN (OPENING OUT)
2 NO. TILT & TURN VENTS WHERE SHOWN
BASEWALL HEIGHT 375MM
2 NO. ROOF VENTS WHERE SHOWN
ROOF PITCH 23.2°

Customers Signature	Date	Drawing No.	Property Elevation:	Unit Elevation:	Scale..	Drawn..
.....	.....	099/01242A		FRONT ELEVATION.	1:50	NJT
					Date.. 31/05/00	Surveyor.

APPROVED
REVISED PLAN

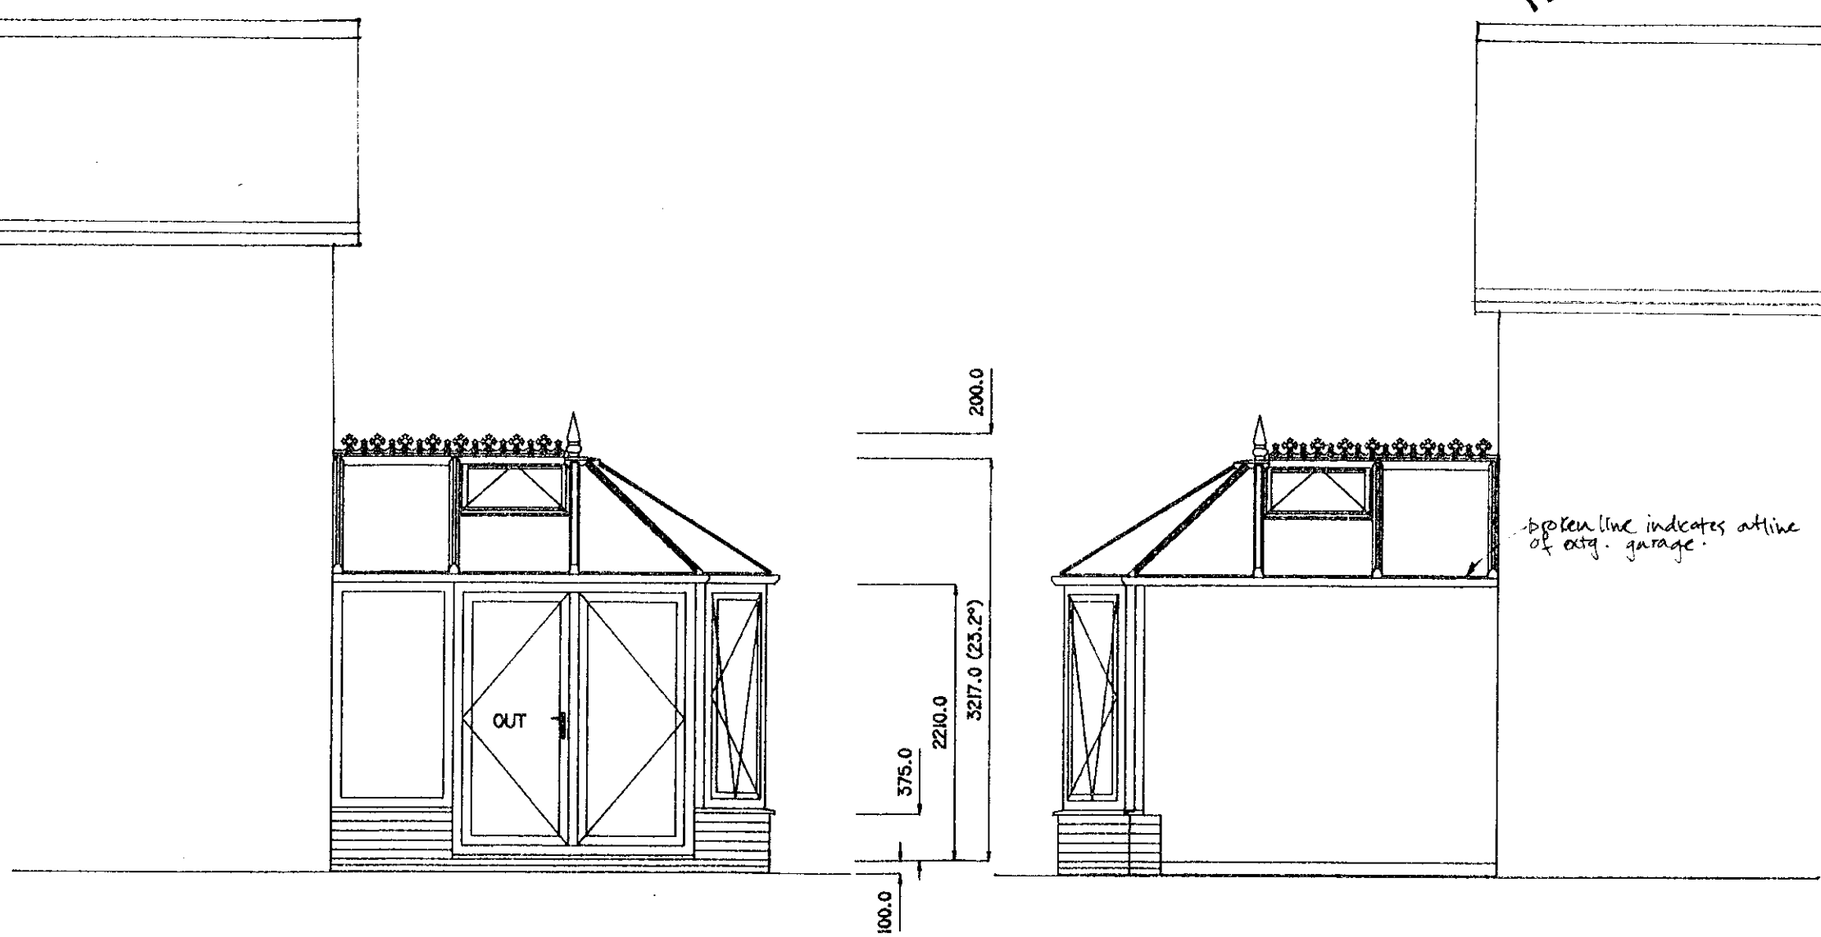

Customers Signature	Date	Drawing No.	Property Elevation:	Unit Elevation:	Scale..	Drawn..
.....	.....	099/01242A		SIDE ELEVATIONS.	1:50	NJT
					Date.. 31/05/00	Surveyor.

PRODUCT CHECK SHEET.

CONSERVATORY ADMIN.

☑ Where applicable

PRODUCT: WHITE KNIGHT ☑ DUAL KNIGHT ☐ CRUSADER ☐ EXCALIBUR ☐ GOLDEN OAK ☐ TIMBER ☐

** NOTE - ALL CRUSADER CONSERVATORIES ARE GLAZED EXTERNALLY.*

EXCALIBUR COLOUR: N\A OUT/WHITE IN.

ROOF COLOUR: WHITE OUT/ WHITE IN.

ROOF MATERIAL: POLYCARBONATE ☐ GLASS ☑ TIMBER ☐ GRP ☐

ROOF MATERIAL COLOUR: CLEAR /SPEC. (GLASS) DOUBLE 'K'

ROOF VENT: YES ☑ NO ☐ QUANTITY: 2 MANUAL ☑ AUTOMATED ☐ RIDGEFLOW: YES ☑ NO ☐

HANDLE COLOUR: SILVER ☐ WHITE ☐ GOLD ☑ TYPE: STRAIGHT ☑ CURVED ☐

DENTIL MOULDING: YES ☐ NO ☑

THRESHOLD: LOW ☐ HIGH ☑ WHEELCHAIR ☐

SPECIAL GLASS TO FRAMES: PILKINGTON 'K' (If required)

OBSCURE GLAZING PATTERN: N\A (If required)

S.G.O.: YES ☐ NO ☑

WINDOW BOARDS: YES ☐ NO ☑ (IF NO, BRANCH ORDER AS DURABOARD)

EXTRA FRAMES: YES ☐ NO ☑ (IF YES, PLEASE SUPPLY INFORMATION)

EXTRA TIMBER: YES ☐ NO ☑ (IF YES, PLEASE SUPPLY TIMBER SHEET)

NUMBER OF DOWNPIPES: 1 POSITION: L/H ☐ R/H ☑ INTERMEDIATE ☐ (AS VIEWED FROM OUTSIDE).

SOAKAWAY REQUIRED YES ☐ NO ☑ Position Left/Right

R.W. LINK TO EXISTING SYSTEM YES ☑ NO ☐

LOCAL COUNCIL ☑ HOUSING ASSOCIATION ☐ BUILDER ☐ OTHERS ☐

ADDRESS - WOKINGHAM D.C.

BRANCH/SURVEY.

☑ Where applicable

WINDOW BOARDS: WHITE ☑ MAHOGANY ☐ GOLDEN OAK ☐ LIGHT OAK ☐ TIMBER ☐ TILED ☐

BRICK TYPE (IF KNOWN): LBC REGENCY.

INTERNAL BASEWALL FINISH: BRICK ☐ PLASTER ☑

SKIRTING BOARD: YES ☑ NO ☐ SPECIFY TYPE: 4" HARDWOOD.

FLOOR FINISH: SCREED ☐ COSEYFLOOR ☑ OTHER (SPECIFY)

RETAINING HOOKS: SILVER ☐ BRASS ☑ NONE ☐

S.G.O. (SPECIFY & QUANTITY): NIL.

HANDLE COLOUR: SILVER ☐ WHITE ☐ GOLD ☑ TYPE: STRAIGHT ☑ CURVED ☐

SITE ACCESS (SPECIFY): SIDE ACCESS.

REMOVE SITE OBSTRUCTION (SPECIFY): NO

MATURE TREES (SPECIFY): NO

SKIP DETAIL: ROAD ~~☐~~ DRIVE ☑ COMMENTS: IN PARKING BAY.

RAINWATER ACCESSORIES (SPECIFY): YES - XTRA HOPP + BRANCH.

PAVING (REINSTATE OR NEW, SPECIFY): REINSTATE.

ELECTRICS:

PLUMBING: BY CUSTOMER'S SUB-CONTRACTOR.

ANCILLARYS:

APPROVED REVISED PLAN

** NOTE - IF WORK BY CUSTOMERS OWN CONTRACTOR PLEASE STATE 'BY OTHERS'*

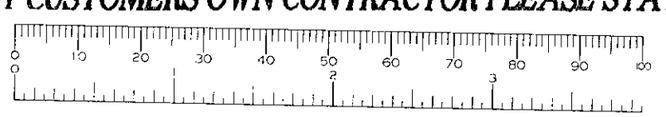

Customers Signature	Date		Drawing No.	Description.	Scale..	Drawn..
M K G Davies	1/4/00		099/01242A	CHECK SHEET.	N/A	RTL
					Date.. 31/5/00	Surveyor. KATE HENNINER

DWG: ENGNTBW	REV: C

SURVEYORS BASE PLAN

(TO ACCOMPANY ACTUAL BASE PLAN PROVIDED BY CONSERVATORY ADMIN.)

NOTES

1. ALL DIMENSIONS IN MILLIMETRES AND TO BE CHECKED ON SITE PRIOR TO COMMENCEMENT OF WORK.
2. ONLY FIGURED DIMENSIONS TO BE TAKEN FROM THIS DRAWING.
3. DO NOT SCALE OFF DRAWING.
4. ANY EXISTING BRICK VENTS TO BE DUCTED THROUGH PROPOSED BASE.
5. GROUND LEVEL TO BE LOWERED LOCALLY TO GIVE REQUIRED CLEARANCE FOR D.P.C.
6. SURFACE WATER TO BE DISCHARGED VIA NEW 68 DIA. RAINWATER DOWN PIPE ~~AND SHOED INTO GRATING OVER GULLEY AND INTO 100 DIA. UPVC DRAIN BEDDING ON PEA SHINGLE TO FALL 1:40 min INTO NEW SOAKAWAY 5.0 m. MIN. AWAY FROM BUILDINGS, TO BE FILLED WITH HARDCORE, AGGREGATE AND PEA GRAVEL~~ INTO EXTG. RWP. 1/4/00.
7. BUILD NEW 375 mm (3 COURSE) BASE WALL ABOVE D.P.C LEVEL OF UNIT. BASE WALL TO BE CONSTRUCTED IN 100 MM THICK BLOCKWORK/BRICKWORK INTERNALLY, 50 MM THICK CAVITY FILLED WITH FIBREGLASS INSULATION BATS, 100 MM THICK BRICKWORK EXTERNALLY, AND TO INCORPORATE D.P.C MIN 150 MM ABOVE GROUND LEVEL AND TO INCLUDE "BUTTERFLY" GALVANISED WIRE TYPE WALL TIES STAGGERED 900 MMM HORIZONTALLY, 450 MM VERTICALLY AND TO BE DOUBLED UP AROUND CORNERS AND REVEALS. CLOSE INTERNAL SKIN AT JAMBS AGAINST 150 MM WIDE D.P.C CAVITY BELOW GROUND LEVEL TO BE FILLED WITH LEAN MIX CONCRETE TO WITHIN 150 MM OF D.P.C. LEVEL OF UNIT. ALL NEW VISIBLE BRICKWORK, INCLUDING BRICKWORK BELOW D.P.C. LEVEL AND ABOVE EXTERNAL GROUND LEVEL TO PERIMETER OF UNIT TO MATCH EXISTING HOUSE BRICKWORK (WHERE POSSIBLE).

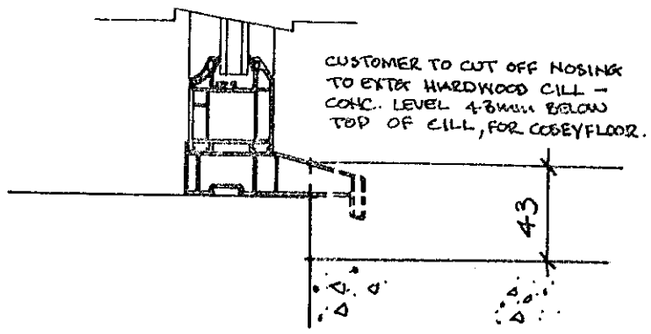

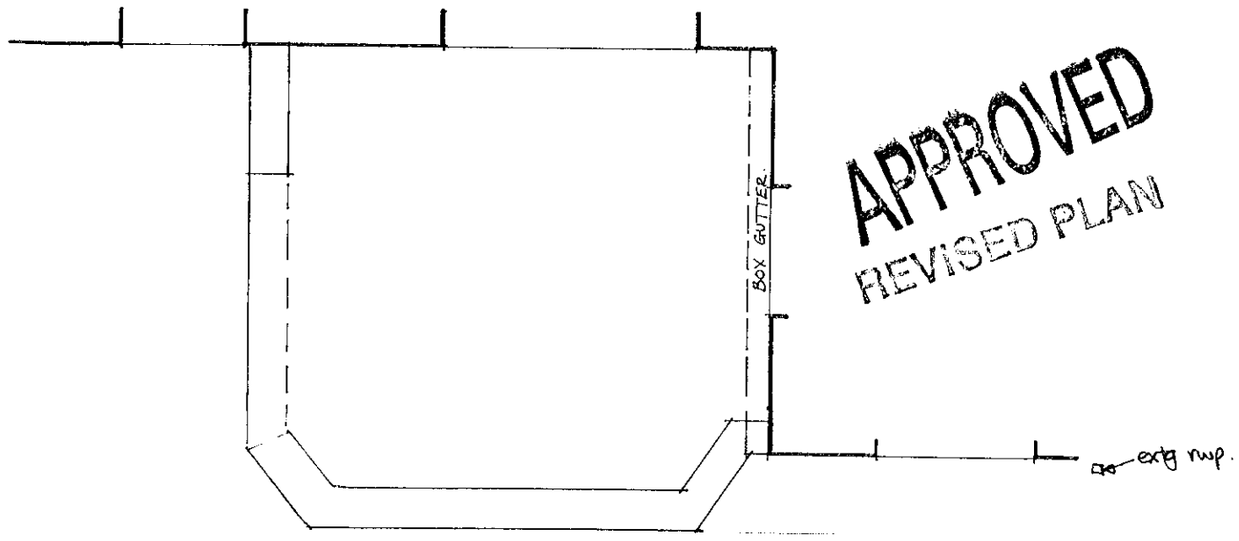

APPROVED
REVISED PLAN

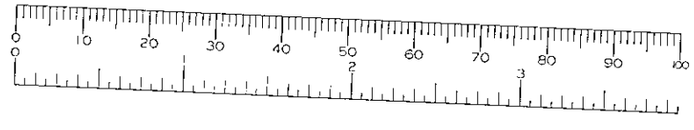

NOTE- BUILDER ENSURE EXISTING WALLS ARE PLUMB PRIOR TO COMMENCEMENT OF BASEWORKS.

Customers Signature	Date		Drawing No.	Unit Elevation.	Scale..	Drawn..
W Mc Davison	1/4/00		099/01242A	BASE LAYOUT.	1:50	RTL
					Date.. 31/5/00	Surveyor. KATE HENNING.

13.APR.2000* 1237

Anglian Home improvements

FLASHING CHASED INTO EXISTING WALL ABOVE LINE OF PROPOSED ROOF.

ROOF COMPRISES
STRUCTURAL ALUMINIUM, VENTILATED RIDGE, ALUMINIUM GLAZING BARS WITH PVC INTERNAL AND EXTERNAL CAPPINGS. ALUMINIUM EAVES BEAM (LOAD DISTRIBUTION MEMBER) SECURED TO TOP OF WALL FRAMES. ROOF GLAZING TO MULTI-CAVITY POLYCARBONATE OR GLASS SHEETS TO CLIENTS INSTRUCTIONS. ROOF DESIGNED IN ACCORDANCE WITH CP3 CHAPTER 5 (WIND LOADING) AND BS 6399 PART 3 (SNOW LOADING). ALL DESIGNED IN ACCORDANCE WITH CP118 (STRUCTURAL USE OF ALUMINIUM).

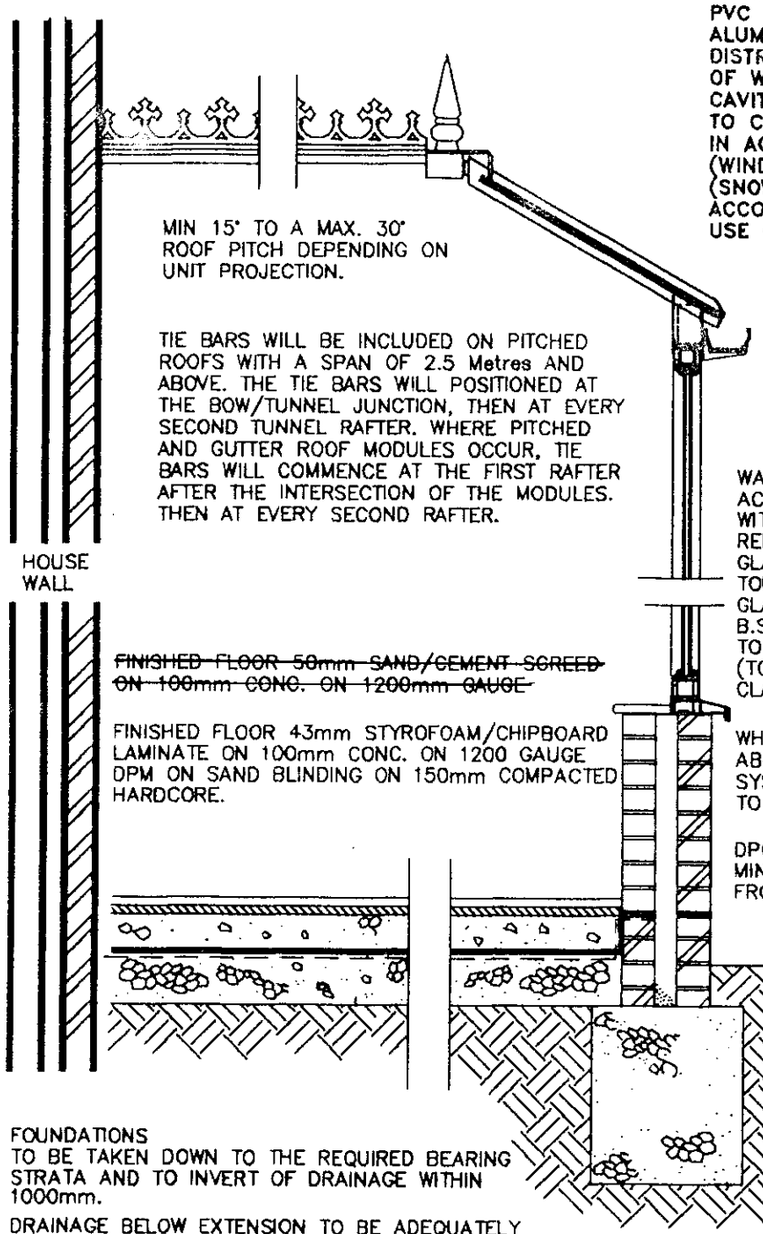

NOTE:– CONSERVATORIES WITH A PITCHED TRANSLUCENT ROOF, UNDER 30m² AREA, ARE NOT SUBJECT TO BUILDING REGULATIONS, PROVIDED IT IS BUILT AT GROUND LEVEL.

TYPICAL SECTION

NOTE:
This cross sectional drawing is shown as a "Typical Example" And is intended for information purposes only. Site Conditions and sub-soil bearing strata will dictate final Design.

DWG: SHT2NVBW REV: E

SUPERSEDED

PROPOSED . PVCu CONSERVATORY.
AT . . . . . 24 MAYS ROAD
WOKINGHAM
RG40 1RW

FOR . . . . MR & MRS DAVISON

SURVEYOR: PLEASE CONFIRM THAT ALL THE ABOVE DETAILS ARE CORRECT. . YES ☑

DATE.	REVISIONS.	BY.
5/4/2000	WIDTH & FACET DIMENSIONS AMENDED.	KL.

DRAWING No. 099/01242

DRAWN BY.. Roy Leftwich — DATE 29/03/00

BRANCH NAME

SURVEYOR.. KATE HENNING. — DATE 5/4/2000

The Company Surveyor has discussed the above survey with me and I agree to the designs and other details finalised during the Surveyor's visit and I understand that I must settle the account with the Installers upon completion.

Customers Signature ..... Date 1/4/00.

Expected Installation Date
ASAP AFTER PLANNING.

Comments on deferred installation
.....
.....

Method of payment
INT. FREE FINANCE.

Code
.....

Confirmed with customer as:
INT. FREE FINANCE.
(Anglian does not accept final balance payment by credit card.)

APPROVAL REQUIRED ☑ Where applicable

PLANNING PERMISSION	YES	☑	NO	☐	
BUILDING REGULATION	YES	☐	NO	☑	
LISTED BUILDING CONSENT	YES	☐	NO	☑	
CONSERVATION AREA	YES	☐	NO	☑	
RESTRICTIVE COVENANTS	YES	☐	NO	☑	
HOUSING ASSOC. CONSENT	YES	☐	NO	☑	
BUILDERS CONSENT	YES	☐	NO	☑	
LANDLORDS CONSENT	YES	☐	NO	☑	

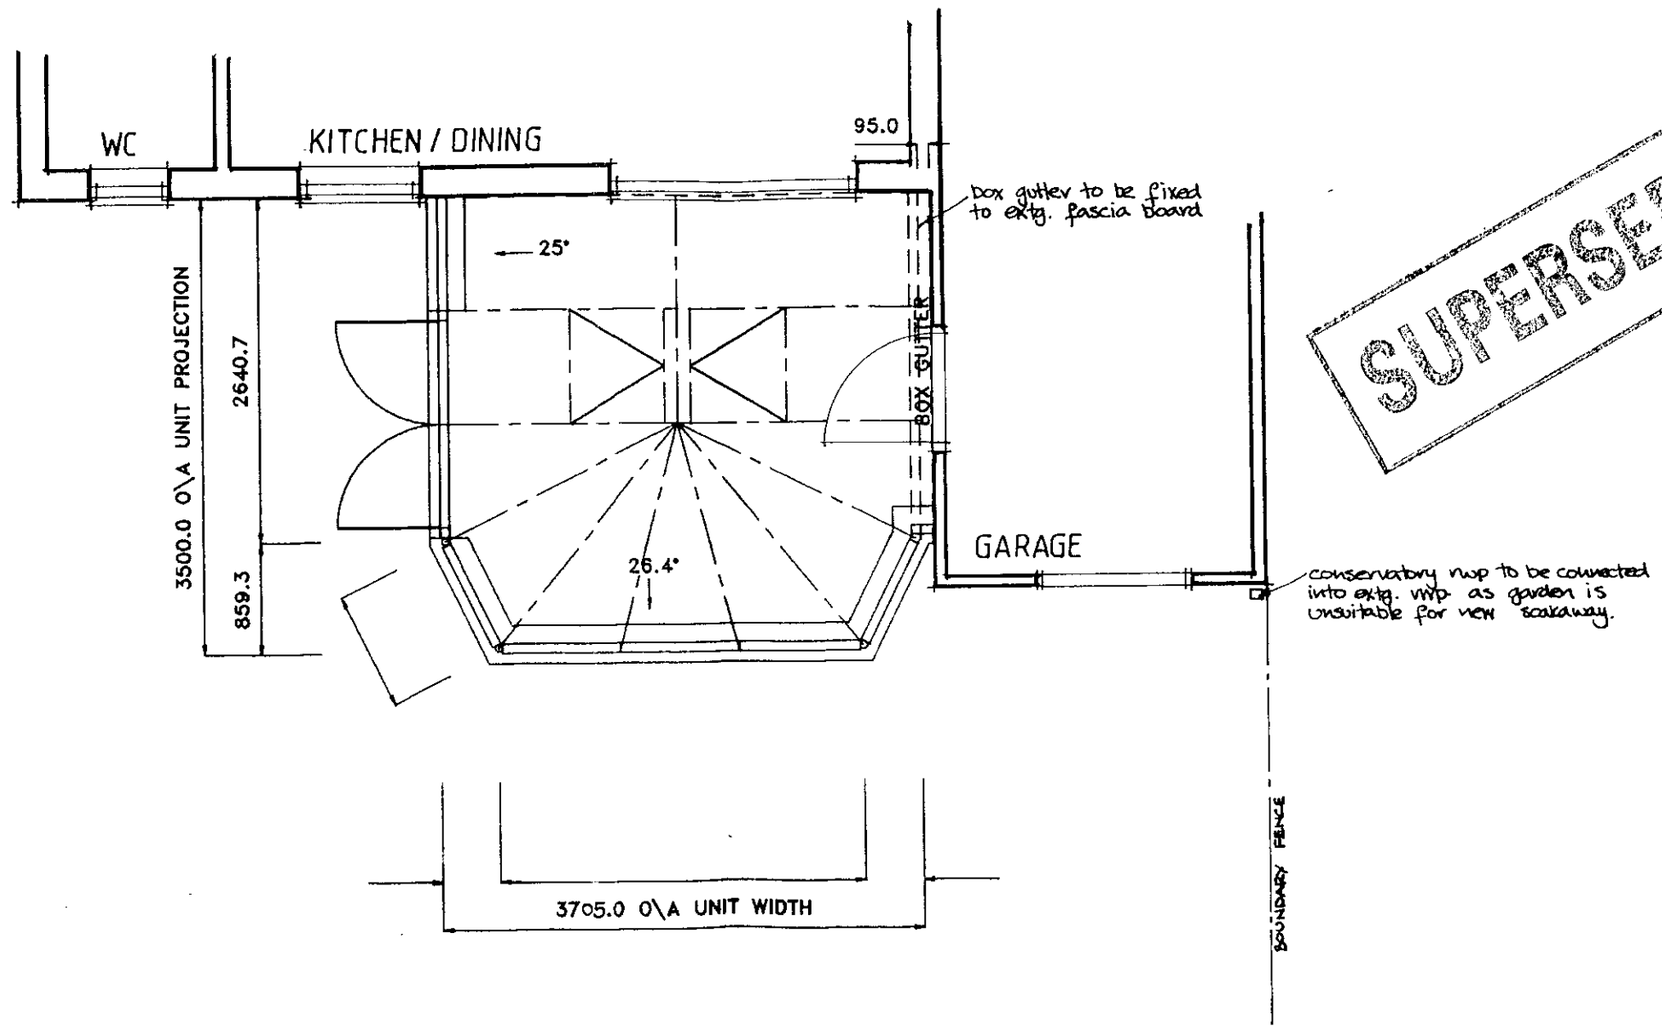

SUPERSEDED

Customers Signature	Date	Drawing No.	Unit Elevation.	Scale..	Drawn..
[signature]	1/4/00	099/01242	PLAN LAYOUT / ROOF DETAILS.	1:50	RTL
				Date.. 29/03/00	Surveyor. KATE HENNING.

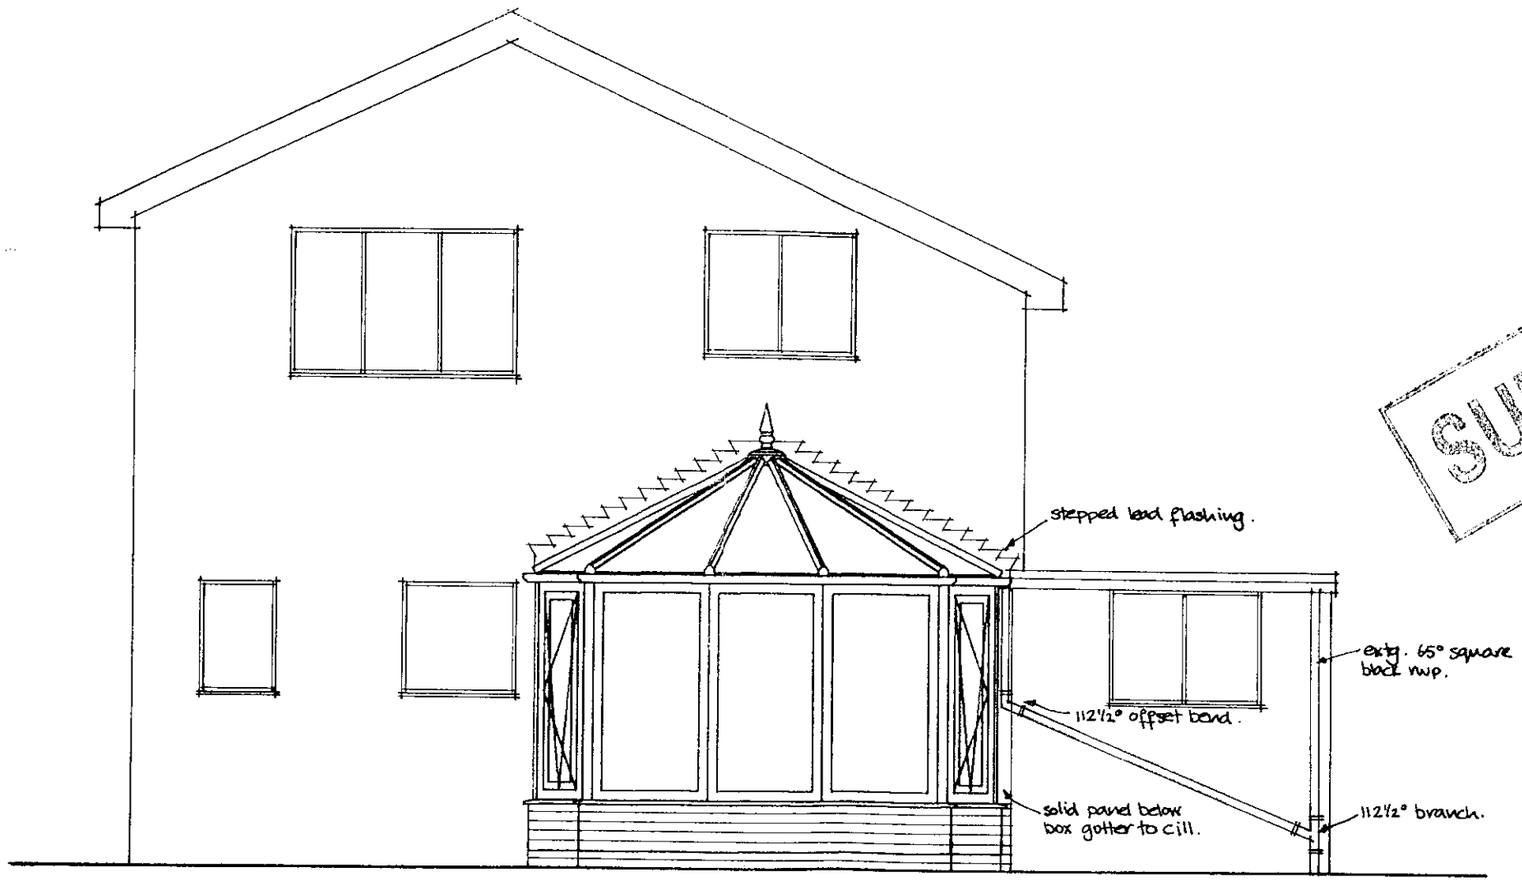

SUPERSEDED

SPECIFICATION:

1No. DOUBLE DOOR WHERE SHOWN (OPEN OUT)
2No. TILT & TURN VENTS WHERE SHOWN
BASEWALL HEIGHT 375mm
RIDGEFLOW REQUIRED
2No. ROOF VENTS WHERE SHOWN
ROOF PITCH 25° & 26.4° WHERE SHOWN ON PLAN

Customers Signature	Date	Drawing No.	Property Elevation:	Unit Elevation:	Scale..	Drawn..
K R L Davis	1/4/00	099/01242	REAR ELEVATION	FRONT ELEVATION.	1:50	RTL
					Date.. 29/03/00	Surveyor. KATE HENNING

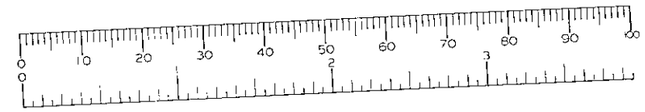

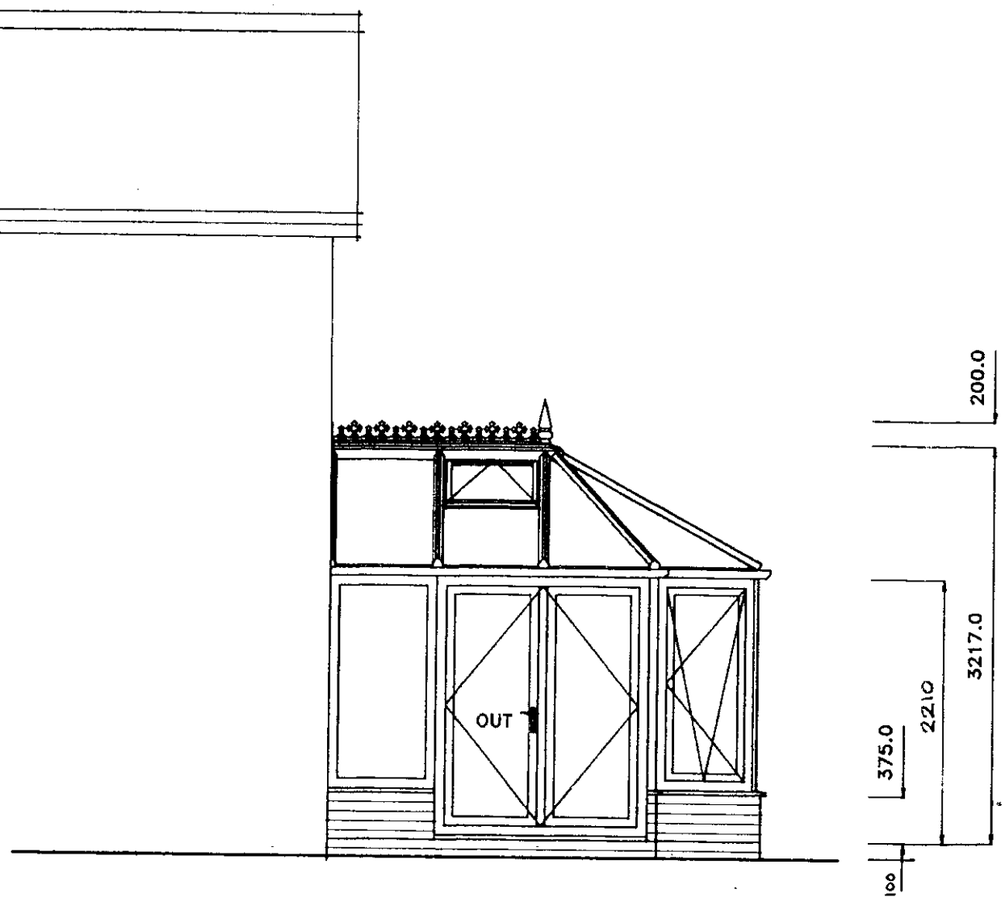

SUPERSEDED

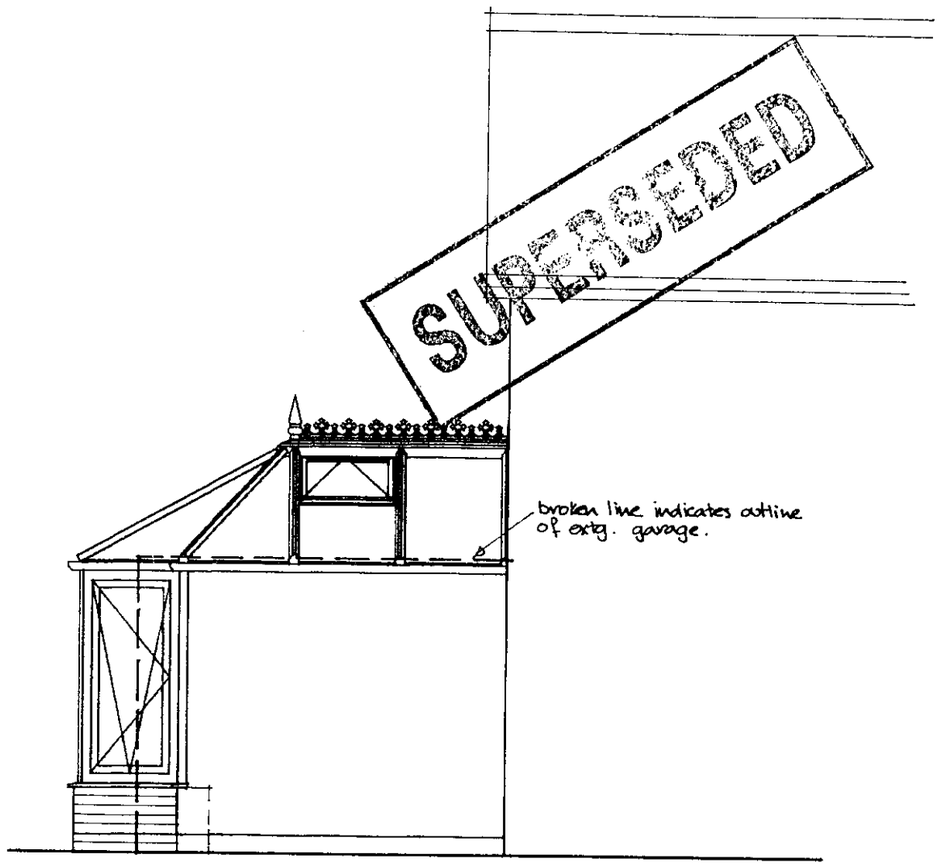

Customers Signature	Date	Drawing No.	Property Elevation:	Unit Elevation:	Scale..	Drawn..
K R LeDavia	1/4/00	099/01242	SIDE ELEVATIONS	SIDE ELEVATIONS.	1:50	RTL
					Date.. 29/03/00	Surveyor. KATE HENNING.

PRODUCT CHECK SHEET.

CONSERVATORY ADMIN.

☑ Where applicable

PRODUCT: WHITE KNIGHT ☑ DUAL KNIGHT ☐ CRUSADER ☐ EXCALIBUR ☐ GOLDEN OAK ☐ TIMBER ☐

** NOTE - ALL CRUSADER CONSERVATORIES ARE GLAZED EXTERNALLY.*

EXCALIBUR COLOUR: N\A OUT/WHITE IN.

ROOF COLOUR: WHITE OUT/ WHITE IN.

ROOF MATERIAL: POLYCARBONATE ☐ GLASS ☑ TIMBER ☐ GRP ☐

ROOF MATERIAL COLOUR: CLEAR /SPEC. (GLASS) DOUBLE 'K'

ROOF VENT: YES ☑ NO ☐ QUANTITY: 2 MANUAL ☑ AUTOMATED ☐ RIDGEFLOW: YES ☑ NO ☐

HANDLE COLOUR: SILVER ☐ WHITE ☐ GOLD ☑ TYPE: STRAIGHT ☑ CURVED ☐

DENTIL MOULDING: YES ☐ NO ☑

THRESHOLD: LOW ☐ HIGH ☑ WHEELCHAIR ☐

SPECIAL GLASS TO FRAMES: PILKINGTON 'K' (If required)

OBSCURE GLAZING PATTERN: N\A (If required)

S.G.O.: YES ☐ NO ☑

WINDOW BOARDS: YES ☐ NO ☑ (IF NO, BRANCH ORDER AS DURABOARD)

EXTRA FRAMES: YES ☐ NO ☑ (IF YES, PLEASE SUPPLY INFORMATION)

EXTRA TIMBER: YES ☐ NO ☑ (IF YES, PLEASE SUPPLY TIMBER SHEET)

NUMBER OF DOWNPIPES: 1 POSITION: L/H ☐ R/H ☑ INTERMEDIATE ☐ (AS VIEWED FROM OUTSIDE).

SOAKAWAY REQUIRED YES ☐ NO ☑ Position Left/Right

R.W. LINK TO EXISTING SYSTEM YES ☑ NO ☐

LOCAL COUNCIL ☑ HOUSING ASSOCIATION ☐ BUILDER ☐ OTHERS ☐

ADDRESS - WOKINGHAM D.C.

BRANCH/SURVEY.

☑ Where applicable

WINDOW BOARDS: WHITE ☑ MAHOGANY ☐ GOLDEN OAK ☐ LIGHT OAK ☐ TIMBER ☐ TILED ☐

BRICK TYPE (IF KNOWN): LBC REGENCY.

INTERNAL BASEWALL FINISH: BRICK ☐ PLASTER ☑

SKIRTING BOARD: YES ☑ NO ☐ SPECIFY TYPE: 4" HARDWOOD.

FLOOR FINISH: SCREED ☐ COSEYFLOOR ☑ OTHER (SPECIFY)

RETAINING HOOKS: SILVER ☐ BRASS ☑ NONE ☐

S.G.O. (SPECIFY & QUANTITY): NIL.

HANDLE COLOUR: SILVER ☐ WHITE ☐ GOLD ☑ TYPE: STRAIGHT ☑ CURVED ☐

SITE ACCESS (SPECIFY): SIDE ACCESS

REMOVE SITE OBSTRUCTION (SPECIFY): NO

MATURE TREES (SPECIFY): NO

SKIP DETAIL: ROAD ~~☑~~ DRIVE ☑ COMMENTS: IN PARKING BAY.

RAINWATER ACCESSORIES (SPECIFY): YES - XTRA HOP + BRANCH.

PAVING (REINSTATE OR NEW, SPECIFY): REINSTATE.

ELECTRICS:

PLUMBING: BY CUSTOMER'S SUB-CONTRACTOR.

ANCILLARYS:

** NOTE - IF WORK BY CUSTOMERS OWN CONTRACTOR PLEASE STATE "BY OTHERS"*

SUPERSEDED

Customers Signature	Date		Drawing No.	Description.	Scale..	Drawn.
M R G Davies	1/4/00		099/01242	CHECK SHEET.	N/A	RTL
					Date.. 29/03/00	Surveyor. KATE HENNING

DWG: ENGNTBW	REV: C

SURVEYORS BASE PLAN

(TO ACCOMPANY ACTUAL BASE PLAN PROVIDED BY CONSERVATORY ADMIN.)



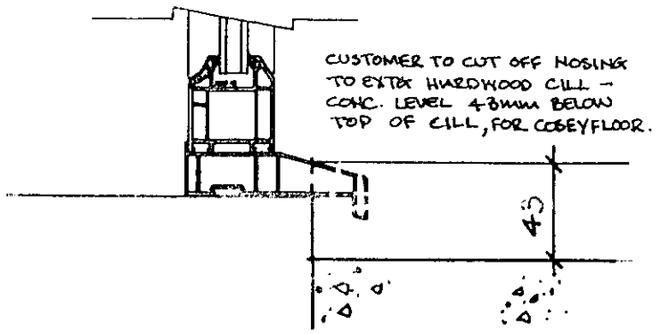

NOTES

1. ALL DIMENSIONS IN MILLIMETRES AND TO BE CHECKED ON SITE PRIOR TO COMMENCEMENT OF WORK.
2. ONLY FIGURED DIMENSIONS TO BE TAKEN FROM THIS DRAWING.
3. DO NOT SCALE OFF DRAWING.
4. ANY EXISTING BRICK VENTS TO BE DUCTED THROUGH PROPOSED BASE.
5. GROUND LEVEL TO BE LOWERED LOCALLY TO GIVE REQUIRED CLEARANCE FOR D.P.C.
6. SURFACE WATER TO BE DISCHARGED VIA NEW 68 DIA. RAINWATER DOWN PIPE ~~AND SHOED INTO GRATING OVER GULLEY AND INTO 100 DIA. UPVC DRAIN BEDDING ON PEA SHINGLE TO FALL 1:40 min INTO NEW SOAKAWAY 5.0 m. MIN. AWAY FROM BUILDINGS, TO BE FILLED WITH HARDCORE, AGGREGATE AND PEA GRAVEL~~ INTO EXTG. SVP. 1/4/00.
7. BUILD NEW 375 mm (5 COURSE) BASE WALL ABOVE D.P.C LEVEL OF UNIT.
   BASE WALL TO BE CONSTRUCTED IN 100 MM THICK BLOCKWORK/BRICKWORK INTERNALLY, 50 MM THICK CAVITY FILLED WITH FIBREGLASS INSULATION BATS, 100 MM THICK BRICKWORK EXTERNALLY, AND TO INCORPORATE D.P.C MIN 150 MM ABOVE GROUND LEVEL AND TO INCLUDE "BUTTERFLY" GALVANISED WIRE TYPE WALL TIES STAGGERED 900 MMM HORIZONTALLY, 450 MM VERTICALLY AND TO BE DOUBLED UP AROUND CORNERS AND REVEALS.
   CLOSE INTERNAL SKIN AT JAMBS AGAINST 150 MM WIDE D.P.C
   CAVITY BELOW GROUND LEVEL TO BE FILLED WITH LEAN MIX CONCRETE TO WITHIN 150 MM OF D.P.C. LEVEL OF UNIT.
   ALL NEW VISIBLE BRICKWORK, INCLUDING BRICKWORK BELOW D.P.C. LEVEL AND ABOVE EXTERNAL GROUND LEVEL TO PERIMETER OF UNIT TO MATCH EXISTING HOUSE BRICKWORK (WHERE POSSIBLE).

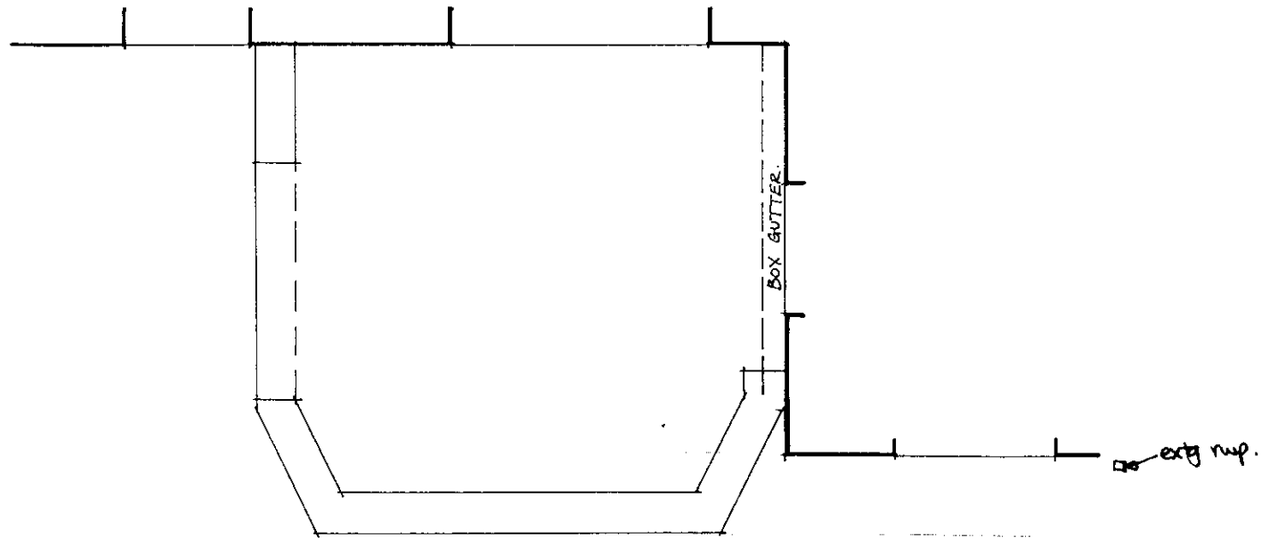

NOTE- BUILDER ENSURE EXISTING WALLS ARE PLUMB PRIOR TO COMMENCEMENT OF BASEWORKS.

Customers Signature	Date		Drawing No.	Unit Elevation.	Scale..	Drawn..
M McDavison	1/4/00		099/01242	BASE LAYOUT.	1:50	RTL
					Date.. 29/03/00	Surveyor. KATE HENNING.