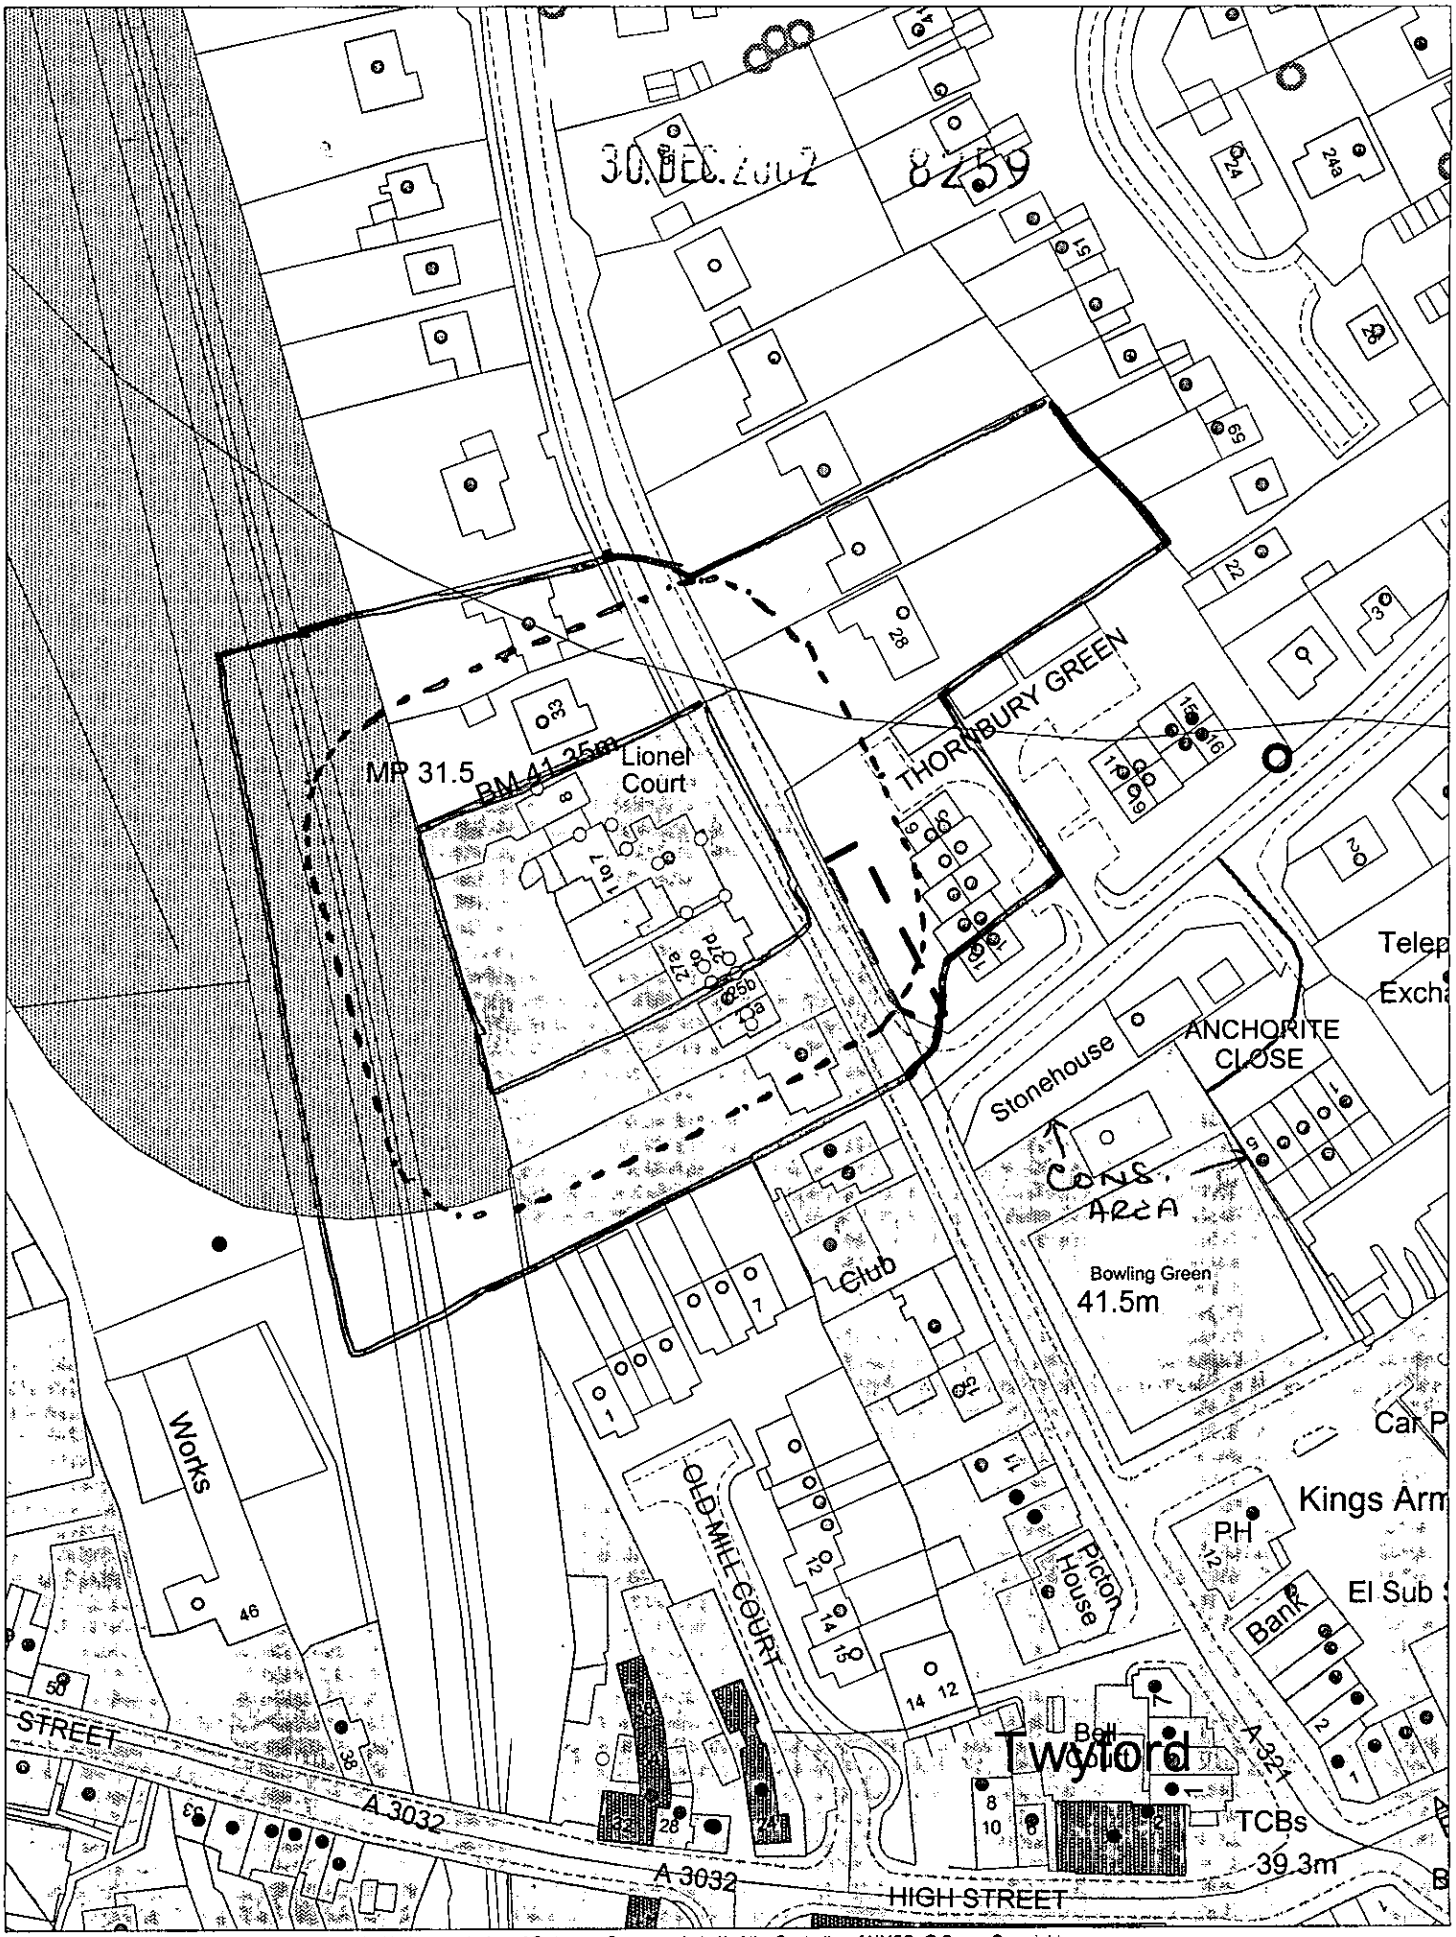


This map is based upon Ordnance Survey material with the permission of Ordnance Survey on behalf of the Controller of HMSO. © Crown Copyright. Unauthorised reproduction infringes Crown Copyright and may lead to prosecution or civil proceedings. Wokingham District Council Licence LA086134

Development Control, Wokingham District Council.

8 January 2003

Scale: 1 : 1250

N W E S

Red line taken to be same as for /67504



Site Plan, Scale: 1 to 2500

This copy has been produced specifically for the map return scheme purposes only. No further copies may be made.


This map is reproduced from Ordnance Survey material with the permission of Ordnance Survey on behalf of the Controller of HMSO Office. © Crown Copyright. Wokingham District Council, Licence No. LA086134

Date: 13 January 2003

N
W E
S

ADDITIONAL PLAN

8259

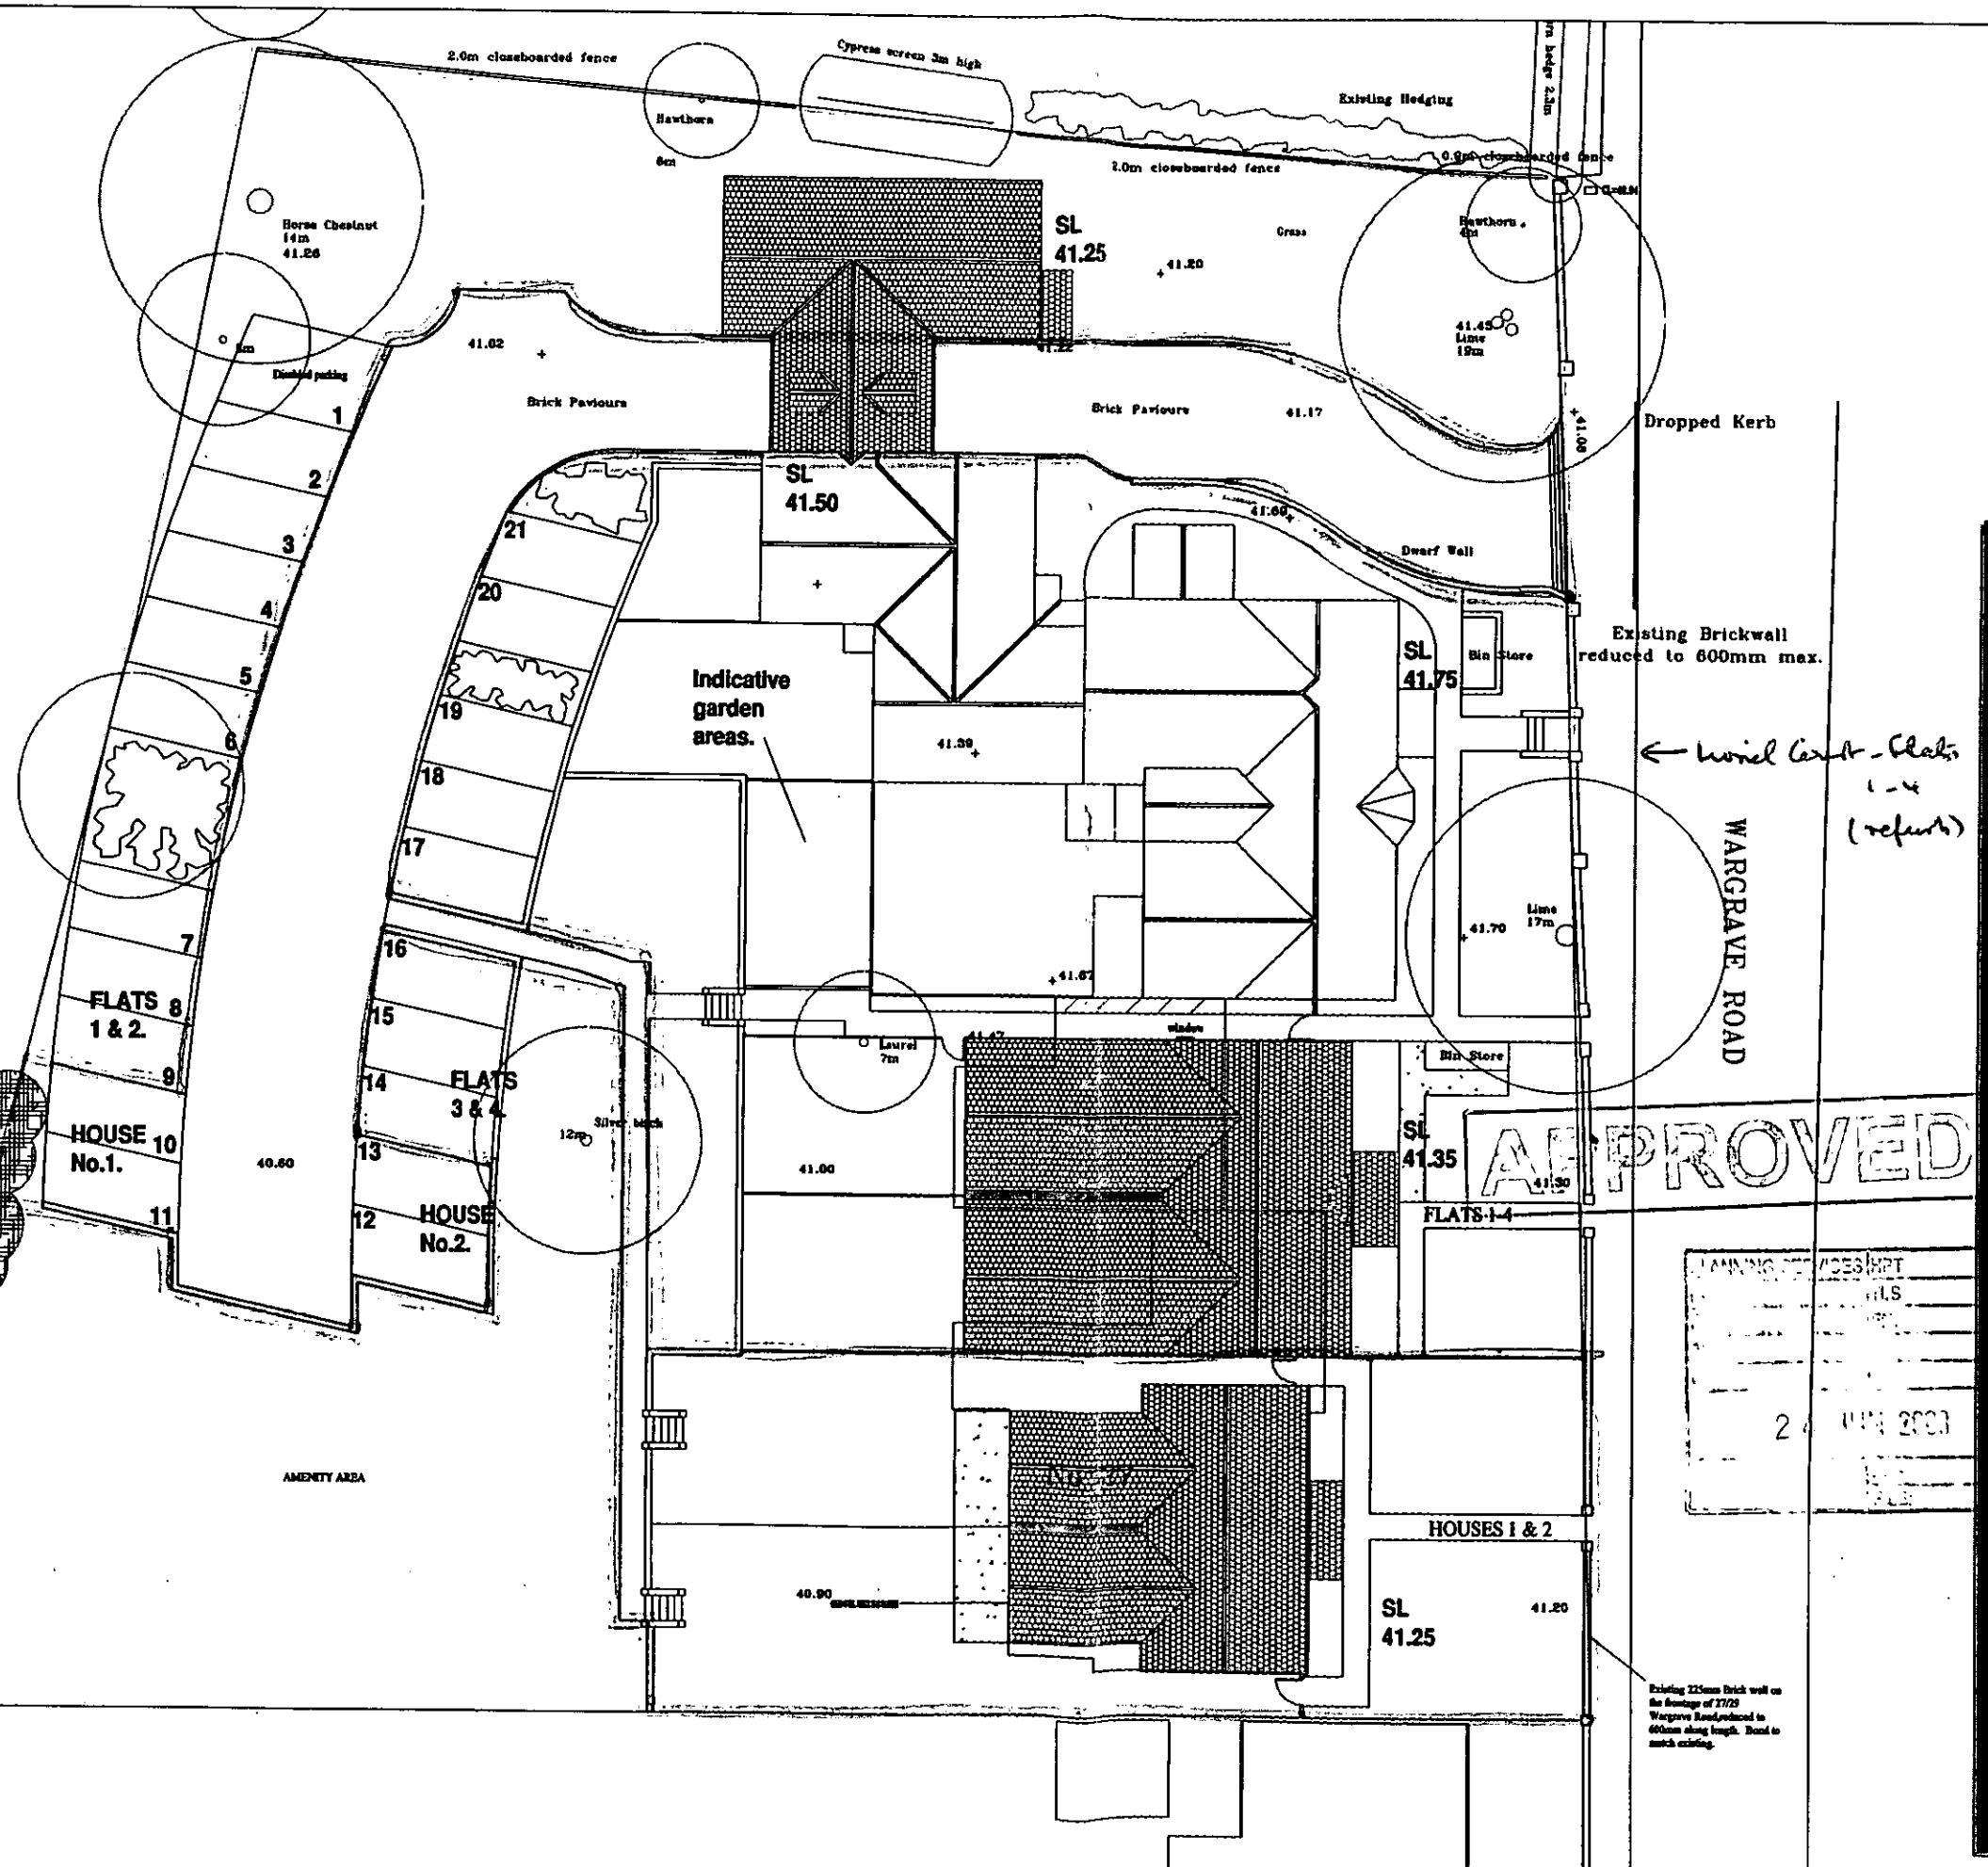

Revision:A	Date:Oct. 99.	Notes:Porch and windows altered, chimney removed.
Revision:B	Date:Oct. 99.	Notes:General alterations.
Revision:C	Date:Oct. 99.	Notes:Amended to L/A comments.
Revision:D	Date:Oct. 99.	Notes:Amended to L/A comments.

HOUSES 1&2 repositioned further back on the site

APPROVED

PLANNING SERVICES DEPT
24 MAR 2000

The KEEN Partnership
Culham House, 122 Castle
Reading, Berks RG1 7RJ

Client:
T.V.H.A.

Job Title:
Proposed development at:
27/29 Wargrave Road,
Twyford,
Berkshire.

Drawing Title:
Site Layout.

Rec'd 23/2/2000

Scale:
1/250. A3

Date:
Oct. 99.

Drawn By:
P.J.M.


Drawing No.:
7011-99-01D

0118 9510855 Fax: 0118 951(
E-mail: keen.partnership@virgin.net

Revision: Date: Notes:

ADDITIONAL PLAN
8259 (1)

Property Schedule
F3- Two-bedroom Flat (71.4m2)
F4 - Two-bedroom Flat (50.1m2)
H7 - See Grd Floor Plan
F8 - Two-bedroon Maisonette (55.2m2)
F9 - See Grd Floor Plan

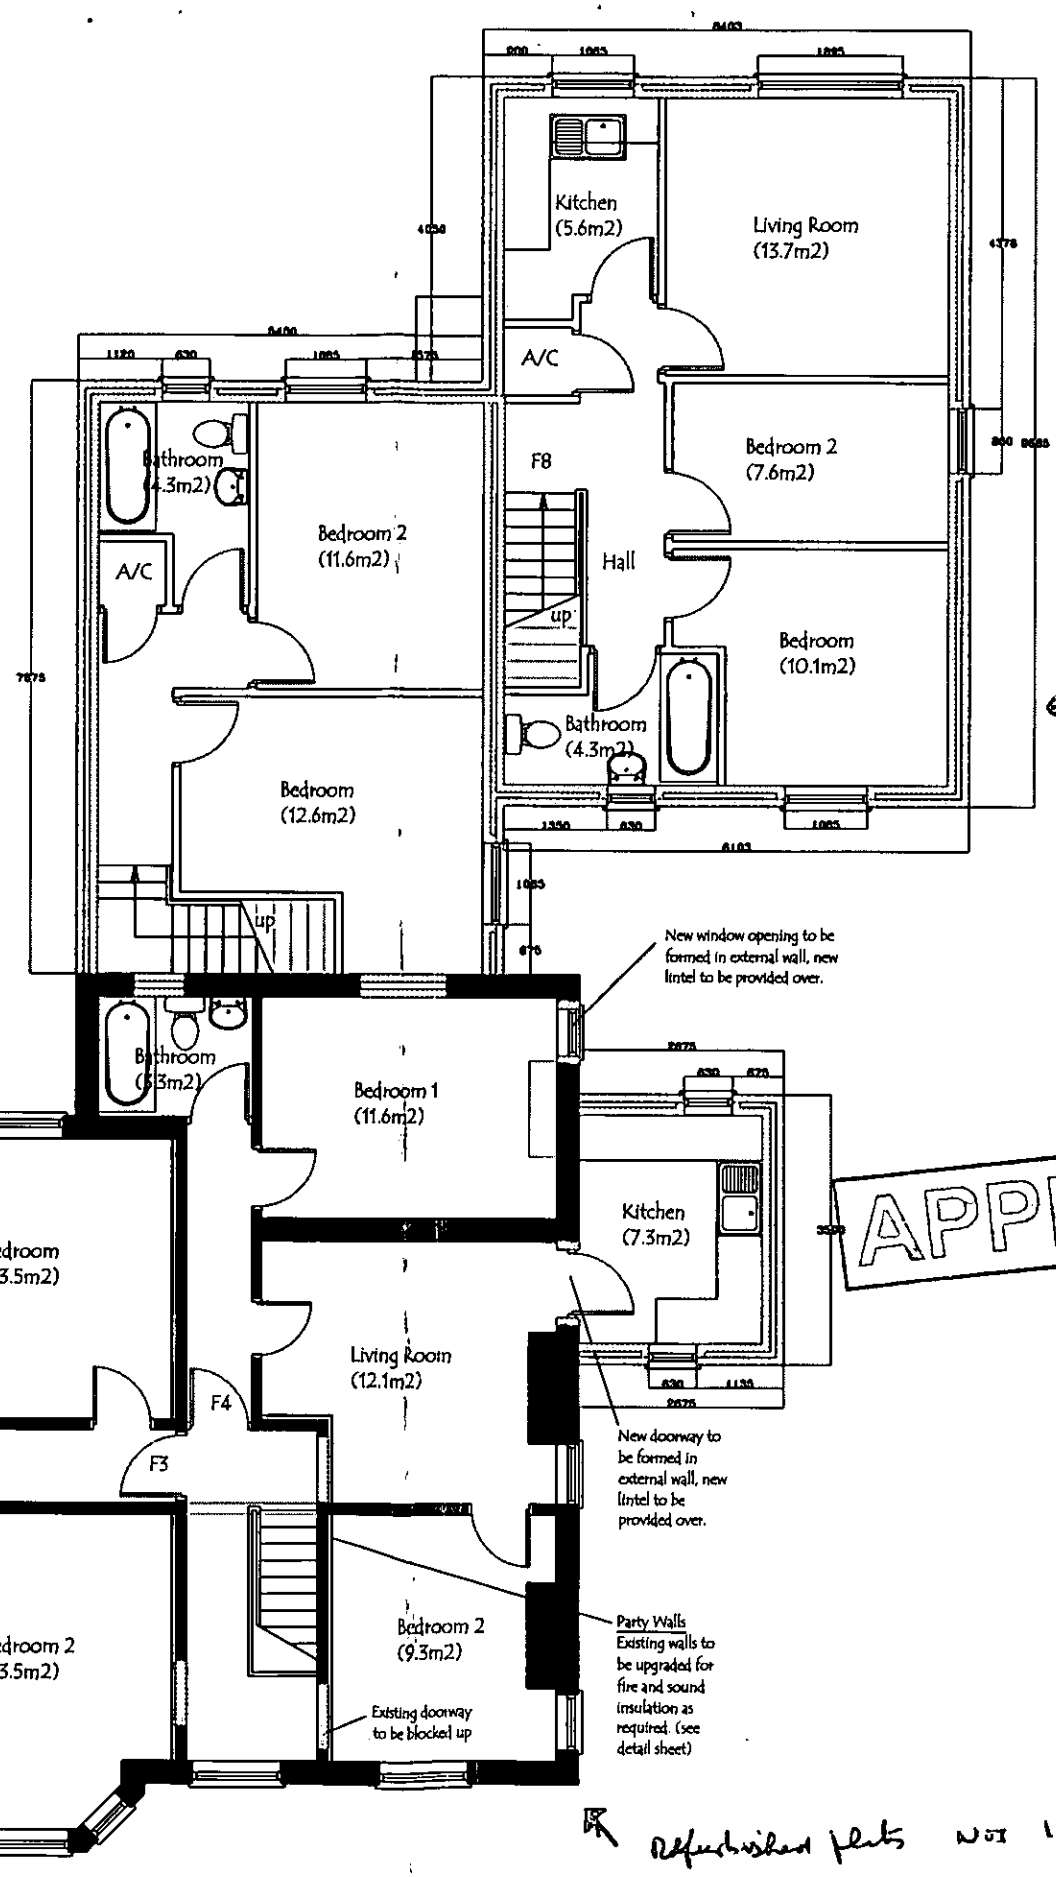

← new build flats at rear

↖ Refurbished flats Nos 1-4 Wood Court.

APPROVED

Recd 25/1/2000.

The KEEN Partnership
Culham House, 122 Castle Street
Reading, Berks RG1 7RJ

Client:
TVHA

Job Title:
29 Wargrave Road
Twyford


Drawing Title:
Proposed First Floor Plan

Scale: 1:100 A3
Date: Jan 2000 Drawn By: NAB
Drawing No.: 7011-00-11

Tel: 0118 9510855 Fax:0118 9510866
E-mail: info@keenpartnership.co.uk

Revision: Date: Notes:

Property Schedule
F1- Two-bedroom Flat (71.4m2)
F2 - Two-bedroom Flat (51.2m2)
H7 - Two-bedroom House (75.8m2)
- F8 - see First Floor Plan
- F9 - Two-bedroom Flat (50.1m2)

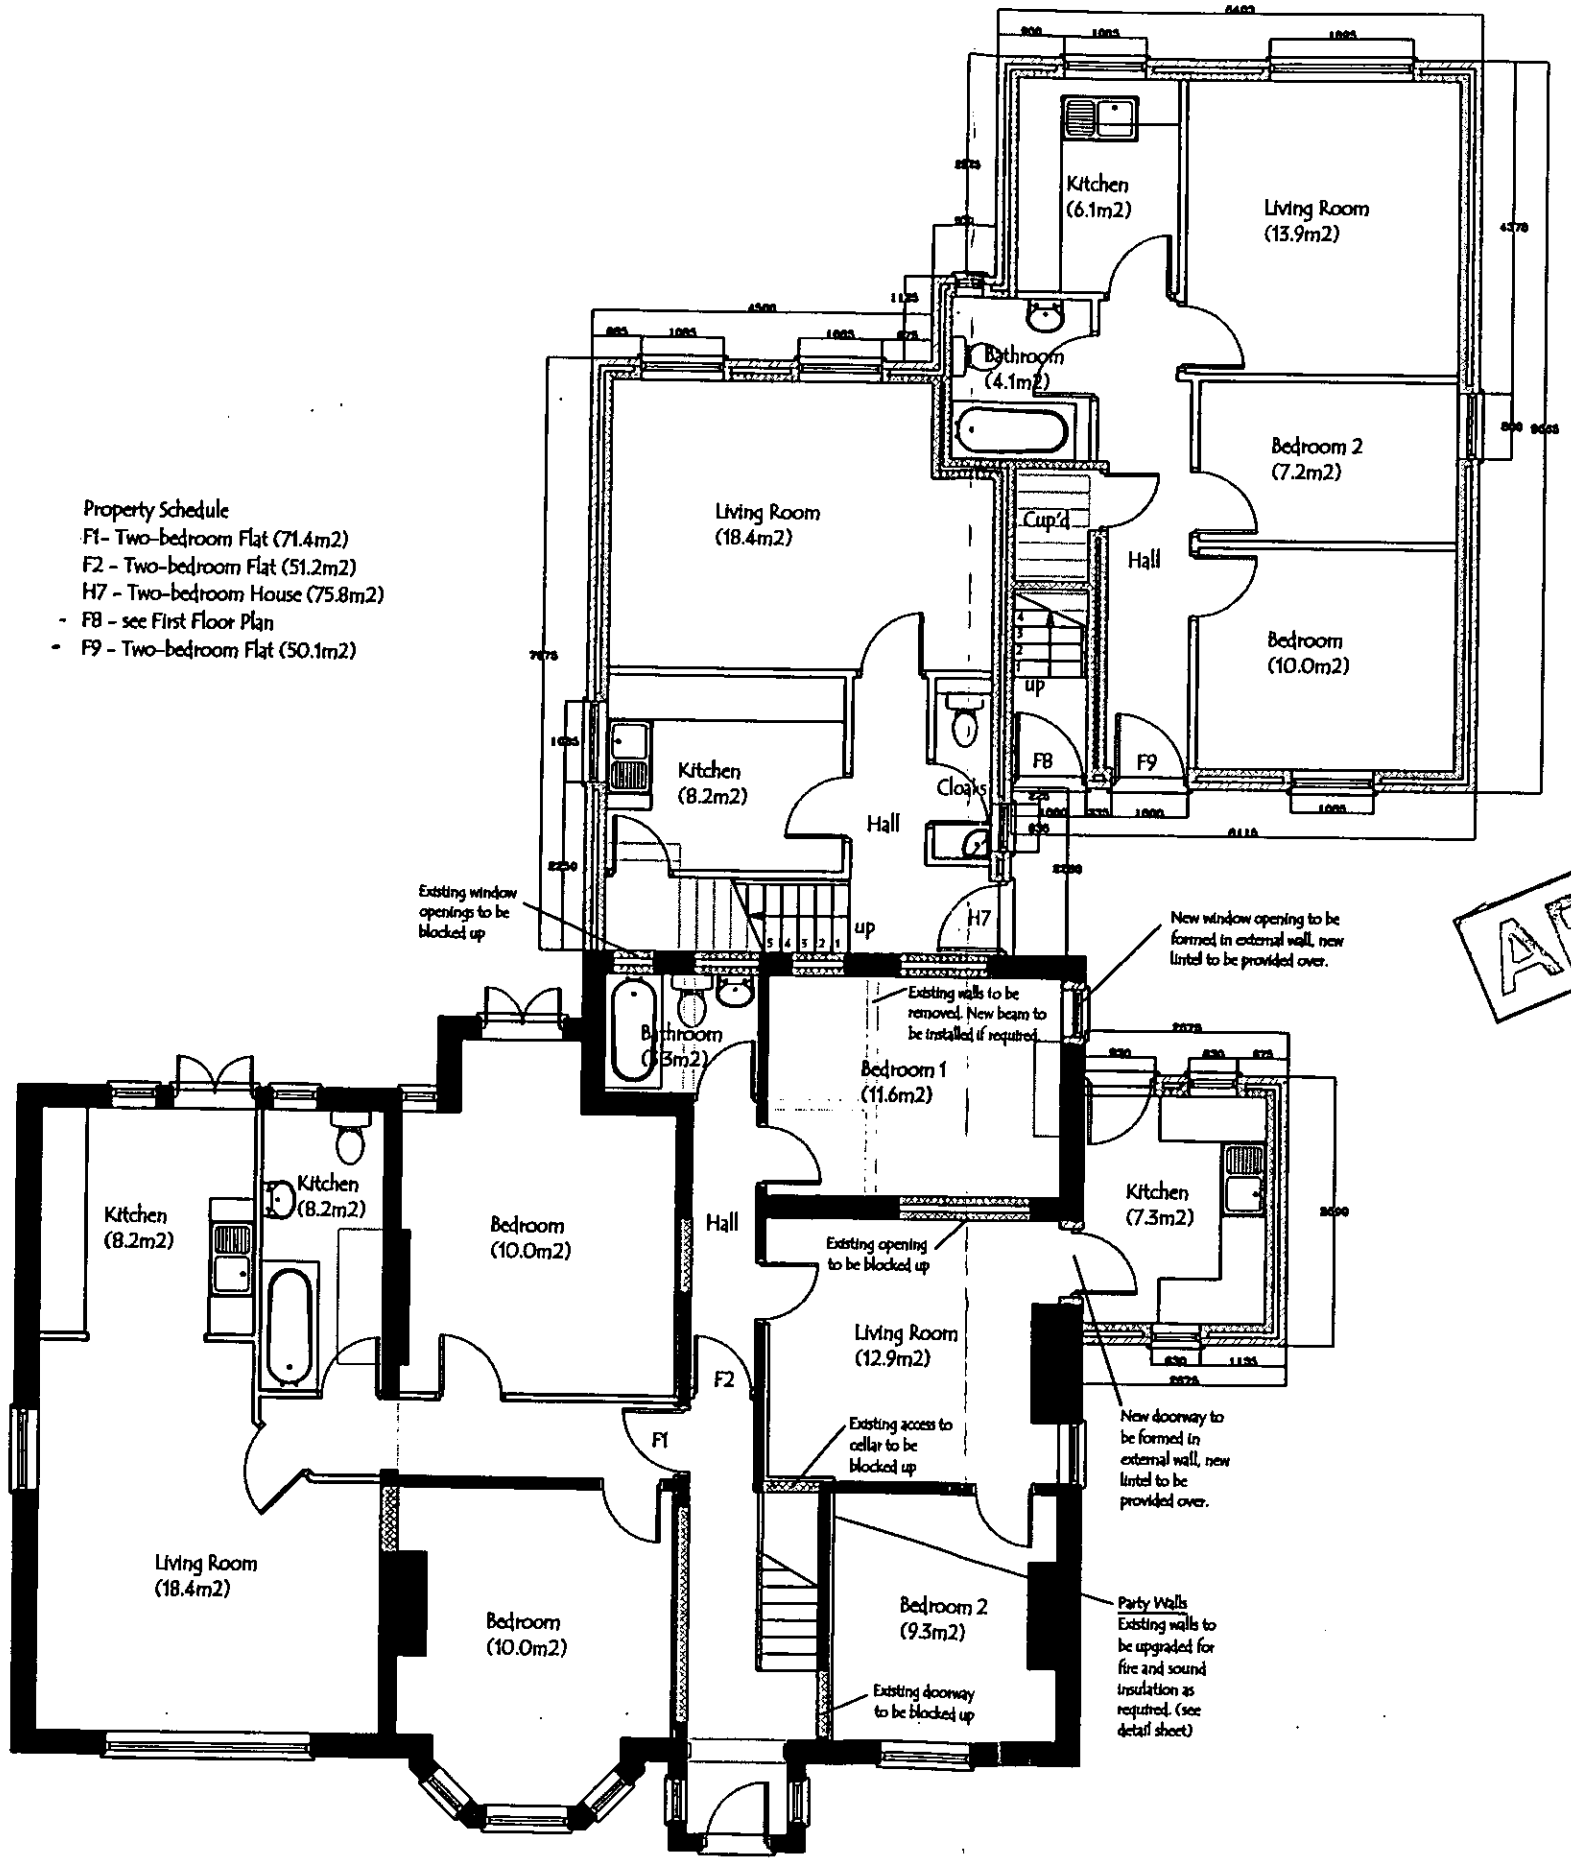

ADDITIONAL PLAN

8259 [illegible]

APPROVED

Revd 25/1/2000

PLANNING
POL

C.C. Zenith
this

The KEEN Partnership
Culham House, 122 Castle Street
Reading, Berks RG1 7RJ

Client:
TVHA

Job Title:
29 Wargrave Road
Twyford

Drawing Title:
Proposed Ground Floor Plan

Scale: 1:100 A3
Date: Jan 2000 Drawn By: NAB
Drawing No.: 7011-00-10

Tel: 0118 9510855 Fax:0118 9510866
E-mail: info@keenpartnership.co.uk