NOTES
All dimensions must be checked on site and not Scaled from this drawing.




Front Elevation


Side Elevation

Rear Elevation


Side Elevation

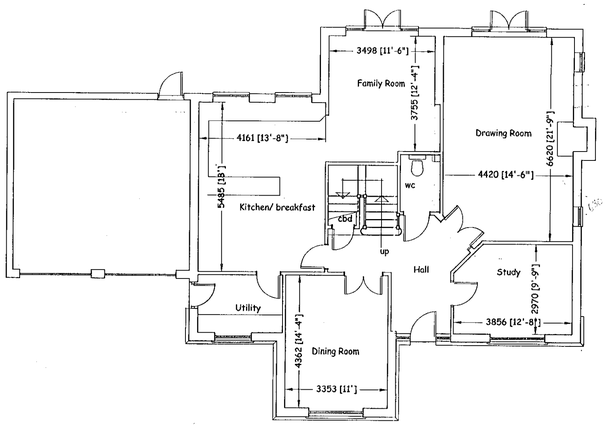


Ground Floor Plan

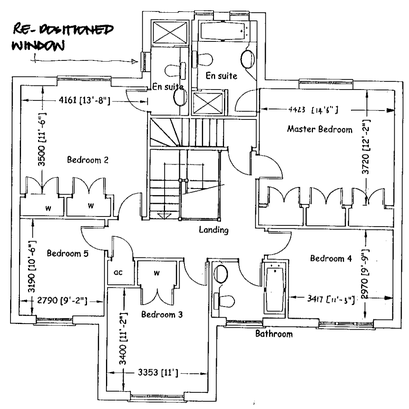


First Floor Plan

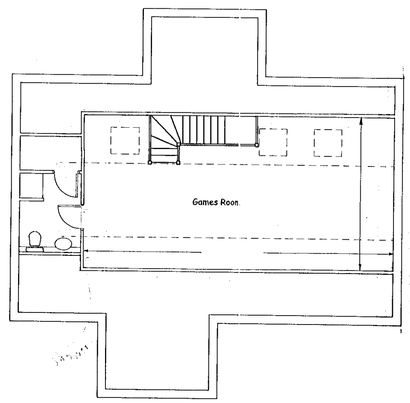


Second Floor Plan

| | | |
|---|---|---|
| B | 29·2·2000 | Pre-plan 1 amendments |
| A | 7·2·2000 | House type amended |
| | Date | Revisions |

06.FEB.2001* 3538

Client
Englemere Homes

Job Title
~~Heatherclene Ave~~
~~Ravenswood Ave~~
Crowthorne

Drawing Title
Floor Plans and Elevations
Plot 1

APPROVED

Scale
1/100

Date
January 2000

Drawn by
DJW

Drg. No.
PD03

Rev.
B

RAVENSWOOD AVENUE

25

23A

23

21

New Tree Planting

1.8m closeboarded fence

demolish garage

1.8m closeboarded fence

New Tree Planting

HOUSE 3

HOUSE 2

HOUSE 1

14.80

15.80

18.00

3.80

2.10

1.8m high brick wall

demolish building

New Shrub Planting

Block Pavior Drive

1.8m close boarded fence

Existing privett hedge

New Shrub Planting

Block Pavior Drive

1.8m closeboarded fence

upgrade drive & finish with tarmac

Electric Gates

New Tree Planting

5 Bar Gate

5 Bar Gate

1.80 closeboarded fence

FIR TREES

BEECH CORNER

HEATHERDENE AVENUE

78

09 FEB 2001 * 3538

17

Rev A House Types 1 & 2 substituted 7.2.200

rev description initl check

JOB TITLE

18 22 Heatherdene Avenue

15 Cr Crosthorne

DRAWING T

Planning Layout

APPROVED

SCALE 1:200 DATE 30.11.99

LAYOUT AS CONSENT 99.70281.F.
WITH NEW HOUSETYPES FOR PLOTS 1 & 2.

TREES TO BE REMOVED AS EXISTING APPROVED LAYOUT 99.41.002 A.

TREE CANOPIES AS PER APPROVED TREE SURVEY BY AF TECHNICAL SERVICES dated 2nd July 1999.

| DRAWN BY | PRELIMINARY | FINAL |
|---|---|---|
| CHECKED BY | | |
| CENTRAL MASTERED | DEVELOPMENT MASTERED | |

| SITE | McCOSKER | VAR | MOD | DRG No. | REV | PLOT |
|---|---|---|---|---|---|---|
| | | | | PD01 | A | |