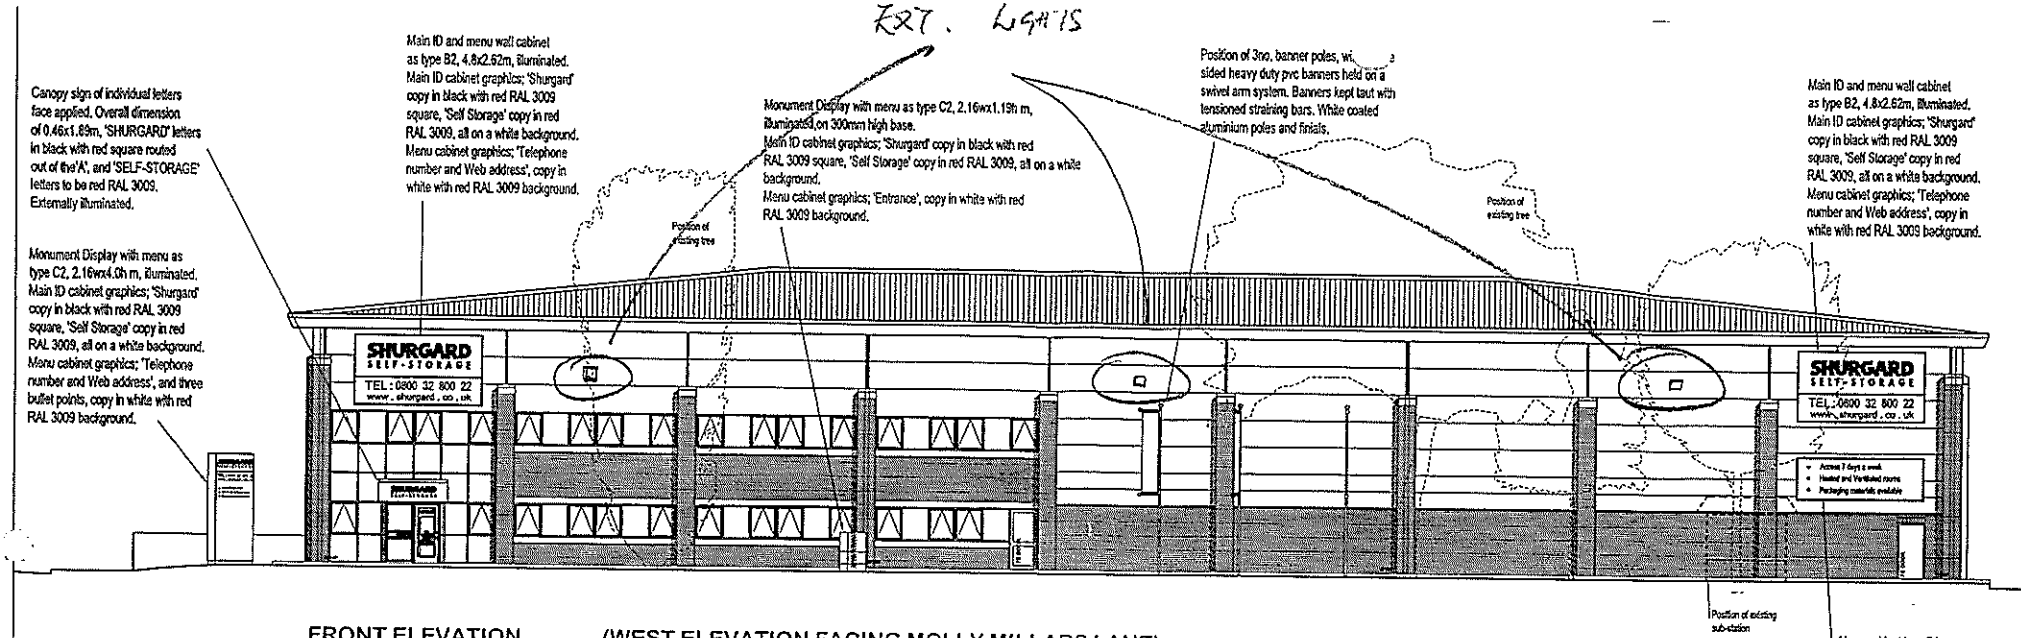

FRONT ELEVATION (WEST ELEVATION FACING MOLLY MILLARS LANE)

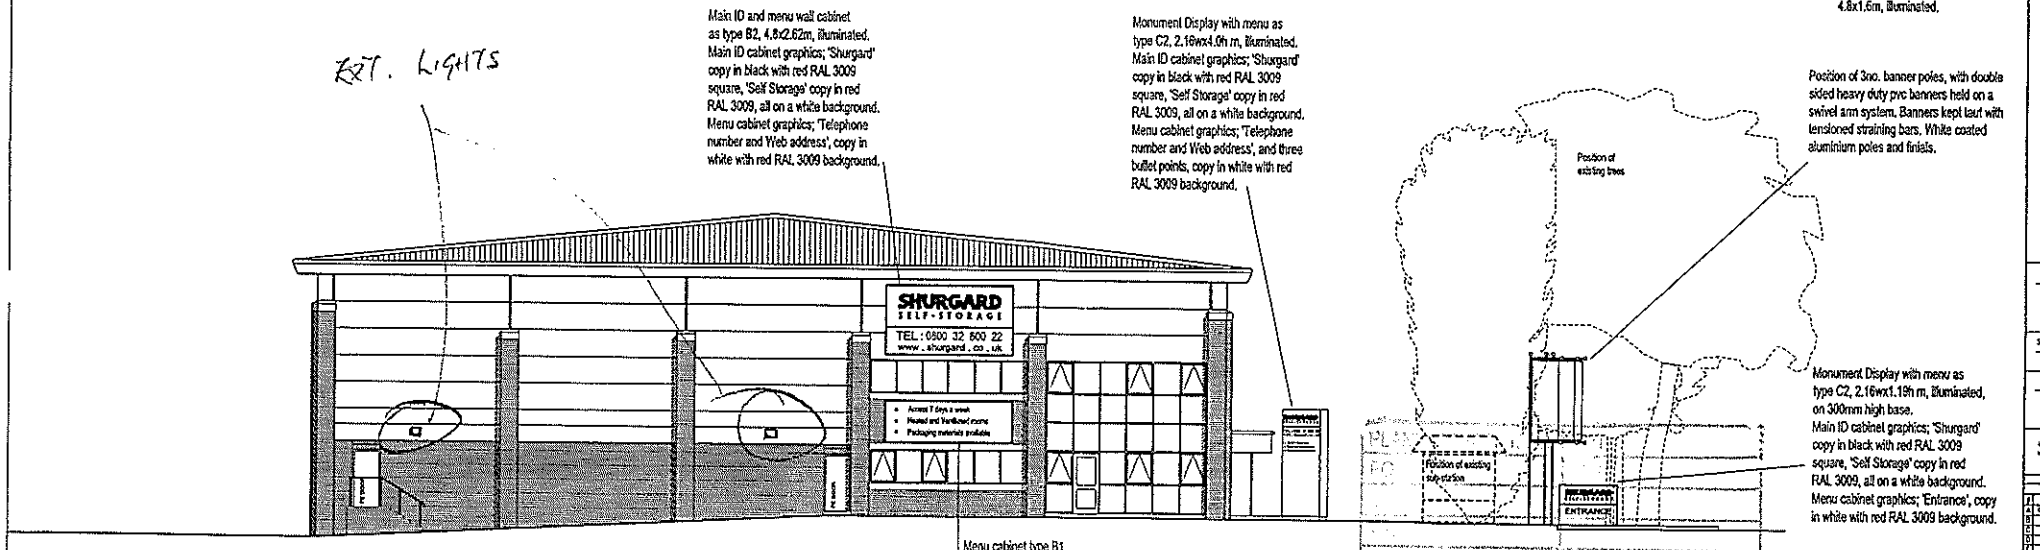

SIDE ELEVATION (NORTH ELEVATION FACING BARKHAM ROAD)

MOLLY MILLARS LANE WOKINGHAM

SHURGARD SELF-STORAGE
UNITED KINGDOM
14 St. Marys Road, Long Ditton
Surbiton Surrey KT6 5EY
Tel: +44 20 8339 2700
Fax: +44 20 8339 2800

SITE LOCATION:
UK- WOKINGHAM LOCATION

SHURGARD PROJECT NUMBER:
DC-0206

DRAWING PACKAGE:
FOR INFORMATION

These documents are intended as guidelines for use in preparation of Site Specific Construction Documents

ISSUE: 27/09/02
CREATED BY DC

REVISION:	DATE:
Gen/Alt per revised	14.10.02

SIGNAGE
WOKINGHAM
SCALE: 1/200@A3

UNIT1-MM3
MOLLY MILLARS LANE
BERKS, RG41 2RT

DRAWING TYPE: | DRAWING NUMBER:
A3 02A

26 FEB 2003
COPIES TO

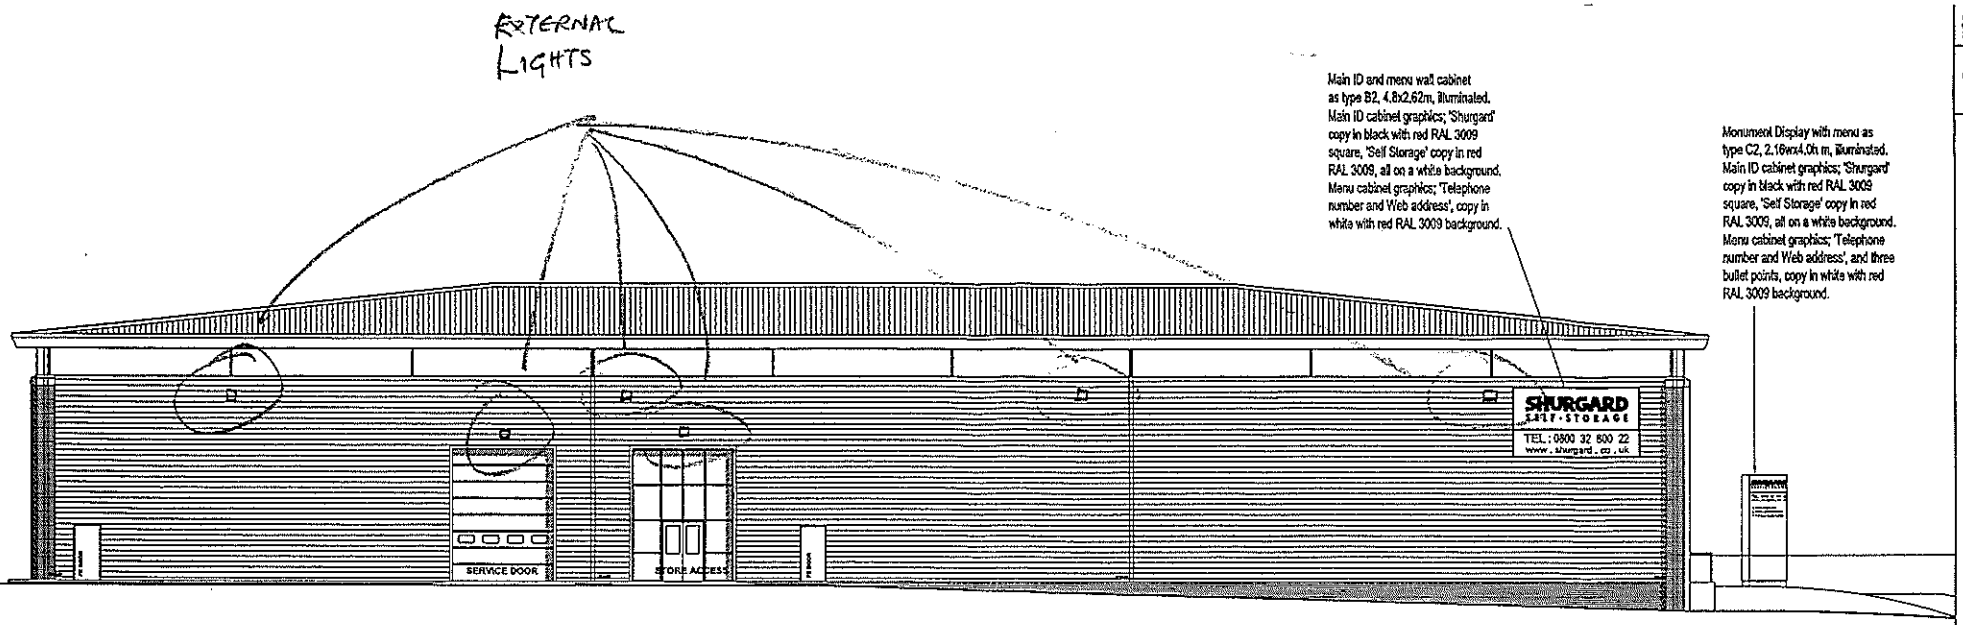

REAR ELEVATION (EAST ELEVATION FACING SERVICE AREA)

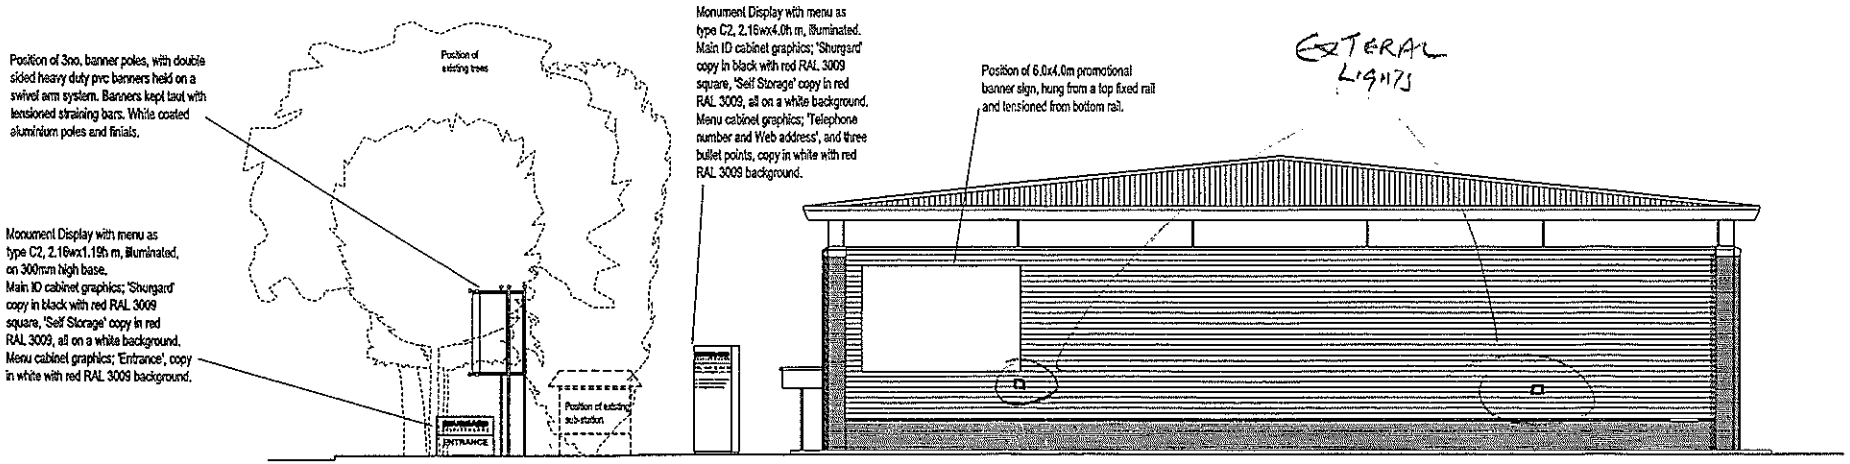

SIDE ELEVATION (SOUTH ELEVATION FACING ACCESS ROAD)

MOLLY MILLARS LANE WOKINGHAM

SHURGARD SELF-STORAGE
UNITED KINGDOM
14 St. Marys Road, Long Ditton
Surbiton Surrey KT6 5EY
Tel: +44 20 8339 2700
Fax: +44 20 8339 2900

SITE LOCATION:
UK- WOKINGHAM LOCATION

SHURGARD PROJECT NUMBER:
DC-0206

DRAWING PACKAGE:
FOR INFORMATION

These documents are intended as guidelines for use in preparation of Site Specific Construction Documents

CREATED BY DC

J	REVISION:	DATE:
A	Gen/Alt sign removed	14.10.02
B		
C		
D		
E		
F		
G		
H		
J		
K		
L		
M		
N		
O		
P		

SIGNAGE
WOKINGHAM

SCALE: 1/200@A3

UNIT1-MM3
MOLLY MILLARS LANE
BERKS, RG41 2RT

DRAWING TYPE: | DRAWING NUMBER:

A3 03A

EXT. LIGHTS

Canopy sign of individual letters face applied. Overall dimension of 0.46x1.89m, 'SHURGARD' letters in black with red square routed out of the'A', and 'SELF-STORAGE' letters to be red RAL 3009. Externally illuminated.

Monument Display with menu as type C2, 2.16wx4.0h m, illuminated. Main ID cabinet graphics; 'Shurgard' copy in black with red RAL 3009 square, 'Self Storage' copy in red RAL 3009, all on a white background. Menu cabinet graphics; 'Telephone number and Web address', and three bullet points, copy in white with red RAL 3009 background.

Main ID and menu wall cabinet as type B2, 4.8x2.62m, illuminated. Main ID cabinet graphics; 'Shurgard' copy in black with red RAL 3009 square, 'Self Storage' copy in red RAL 3009, all on a white background. Menu cabinet graphics; 'Telephone number and Web address', copy in white with red RAL 3009 background.

Monument Display with menu as type C2, 2.16wx1.19h m, illuminated, on 300mm high base. Main ID cabinet graphics; 'Shurgard' copy in black with red RAL 3009 square, 'Self Storage' copy in red RAL 3009, all on a white background. Menu cabinet graphics; 'Entrance', copy in white with red RAL 3009 background.

Position of 3no. banner poles, wi[illegible] sided heavy duty pvc banners held on a swivel arm system. Banners kept taut with tensioned straining bars. White coated aluminium poles and finials.

Main ID and menu wall cabinet as type B2, 4.8x2.62m, illuminated. Main ID cabinet graphics; 'Shurgard' copy in black with red RAL 3009 square, 'Self Storage' copy in red RAL 3009, all on a white background. Menu cabinet graphics; 'Telephone number and Web address', copy in white with red RAL 3009 background.

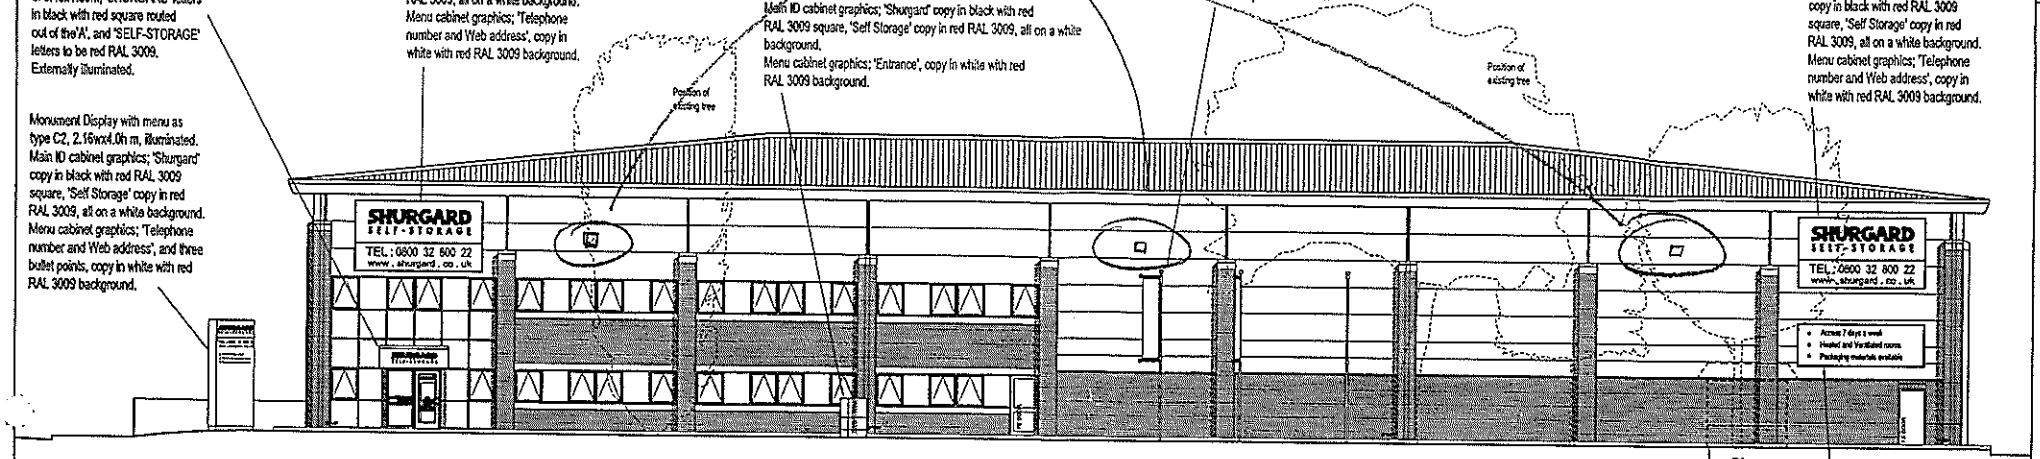

Menu cabinet type B1 white copy on red RAL 3009 background, 4.8x1.6m, illuminated.

FRONT ELEVATION (WEST ELEVATION FACING MOLLY MILLARS LANE)

EXT. LIGHTS

Main ID and menu wall cabinet as type B2, 4.8x2.62m, illuminated. Main ID cabinet graphics; 'Shurgard' copy in black with red RAL 3009 square, 'Self Storage' copy in red RAL 3009, all on a white background. Menu cabinet graphics; 'Telephone number and Web address', copy in white with red RAL 3009 background.

Monument Display with menu as type C2, 2.16wx4.0h m, illuminated. Main ID cabinet graphics; 'Shurgard' copy in black with red RAL 3009 square, 'Self Storage' copy in red RAL 3009, all on a white background. Menu cabinet graphics; 'Telephone number and Web address', and three bullet points, copy in white with red RAL 3009 background.

Position of 3no. banner poles, with double sided heavy duty pvc banners held on a swivel arm system. Banners kept taut with tensioned straining bars. White coated aluminium poles and finials.

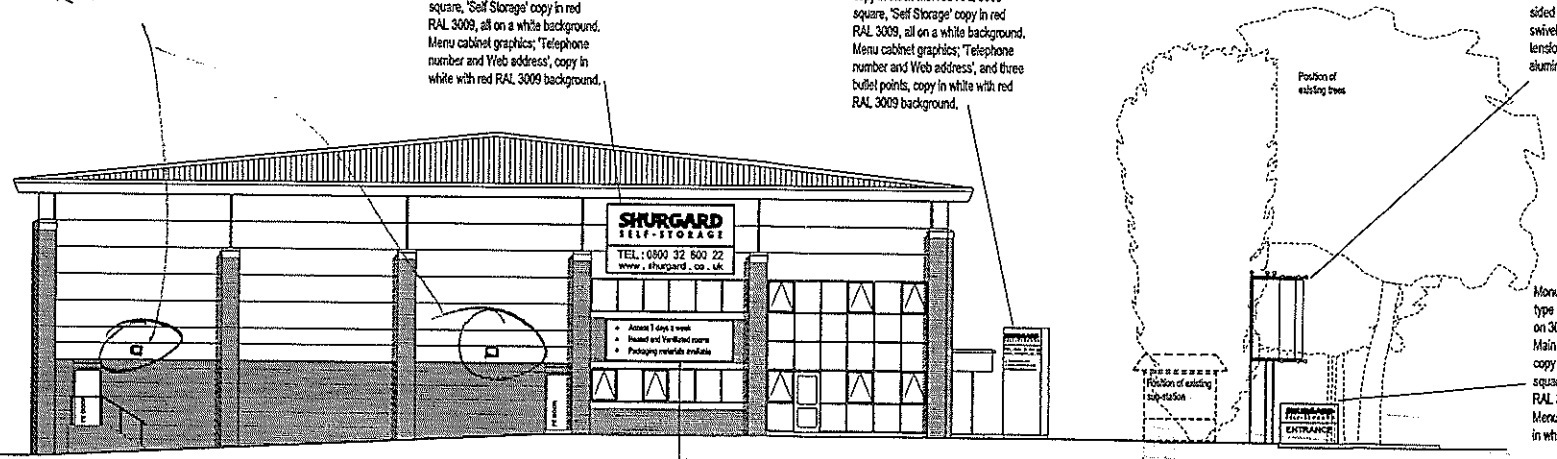

Monument Display with menu as type C2, 2.16wx1.19h m, illuminated, on 300mm high base. Main ID cabinet graphics; 'Shurgard' copy in black with red RAL 3009 square, 'Self Storage' copy in red RAL 3009, all on a white background. Menu cabinet graphics; 'Entrance', copy in white with red RAL 3009 background.

Menu cabinet type B1 white copy on red RAL 3009 background, 4.8x1.6m, illuminated.

SIDE ELEVATION (NORTH ELEVATION FACING BARKHAM ROAD)

MOLLY MILLARS LANE WOKINGHAM

26 FEB 2003

COPIES TO

ACK:

FILE:

SHURGARD SELF-STORAGE

UNITED KINGDOM

14 St. MARYS ROAD, LONG ASTON SUNSTON SURREY KN6 5EY
Tel. +44 20 8339 2700
Fax: +44 20 8339 2800

SITE LOCATION:

UK- WOKINGHAM LOCATION

SHURGARD PROJECT NUMBER:

DC-0206

DRAWING PACKAGE:

FOR INFORMATION

These documents are intended as guidelines for use in preparation of Site Specific Construction Documents

ISSUE: 27/09/02
CREATED BY: DC

REVISION:	DATE:
A Con/Ant sign removed	14.10.02
B	
C	
D	
E	
F	
G	
H	
J	
K	
L	
M	
N	
O	
P	

SIGNAGE

WOKINGHAM

SCALE: 1/200@A3

UNIT1-MM3
MOLLY MILLARS LANE
BERKS, RG41 2RT

DRAWING TYPE: | DRAWING NUMBER:

A3 02A

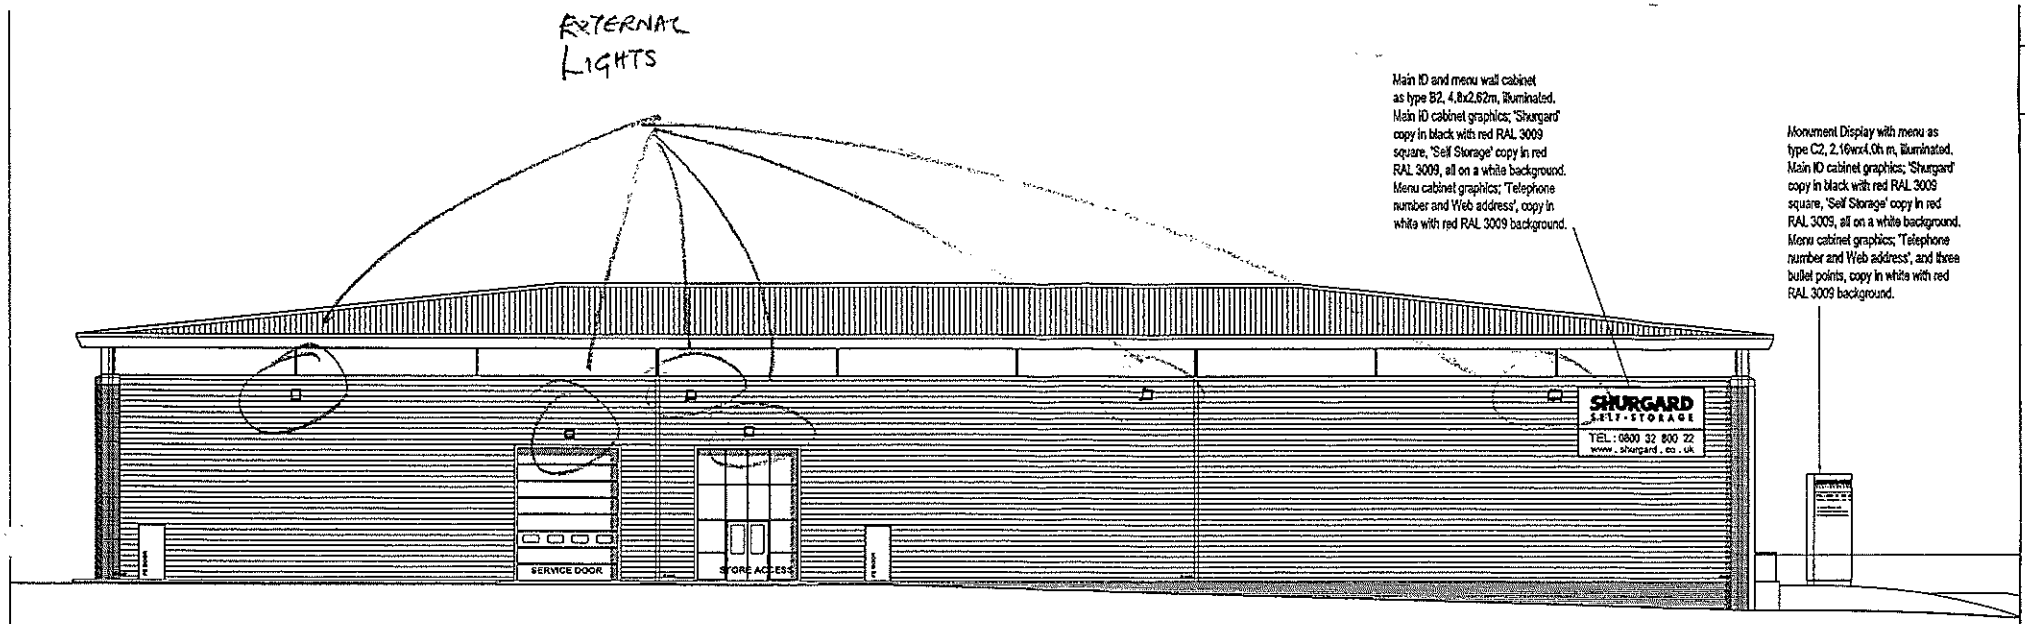

REAR ELEVATION (EAST ELEVATION FACING SERVICE AREA)

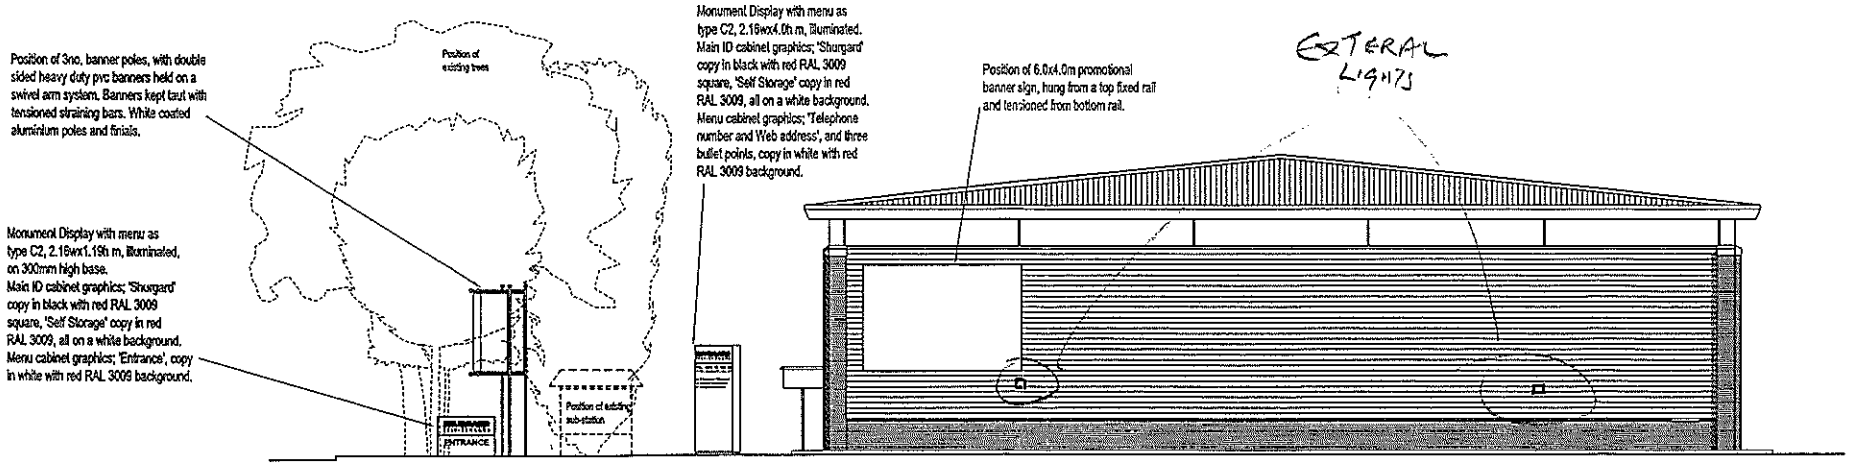

SIDE ELEVATION (SOUTH ELEVATION FACING ACCESS ROAD)

MOLLY MILLARS LANE WOKINGHAM

SHURGARD SELF-STORAGE

LIMITED KINGDOM

SITE LOCATION:
UK- WOKINGHAM LOCATION

SHURGARD PROJECT NUMBER:
DC-0206

DRAWING PACKAGE:
FOR INFORMATION

These documents are intended as guidelines for use in preparation of Site Specific Construction Documents

ISSUE: 27/09/02
CREATED BY DC

	REVISION:	DATE:
A	CANOPY sign removed	14.10.02

SIGNAGE
WOKINGHAM

SCALE: 1/200@A3

UNIT1-MK3
MOLLY MILLARS LANE
BERKS, RG41 2RT

DRAWING TYPE: A3 | DRAWING NUMBER: 03A

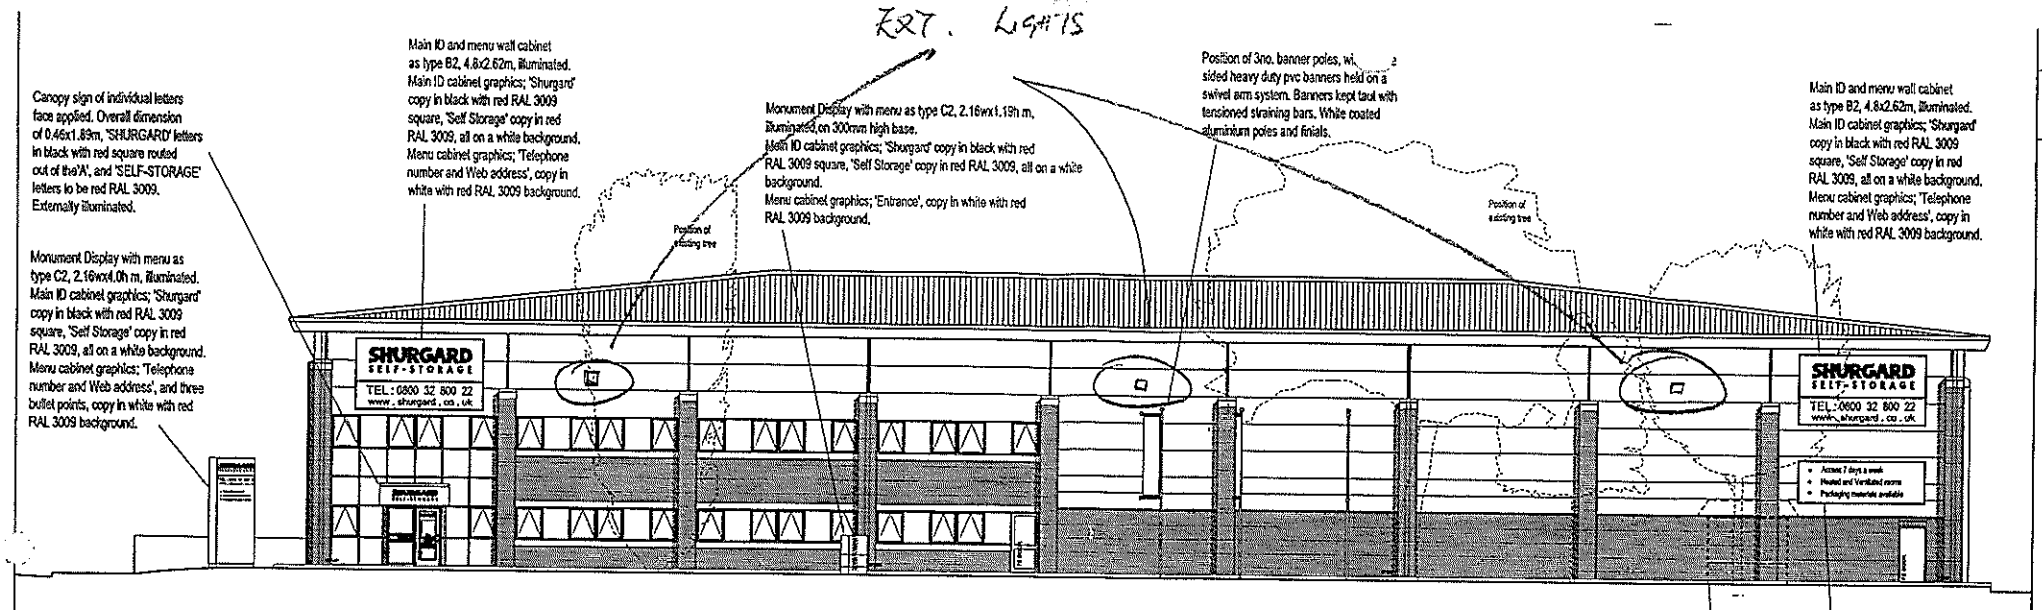

FRONT ELEVATION (WEST ELEVATION FACING MOLLY MILLARS LANE)

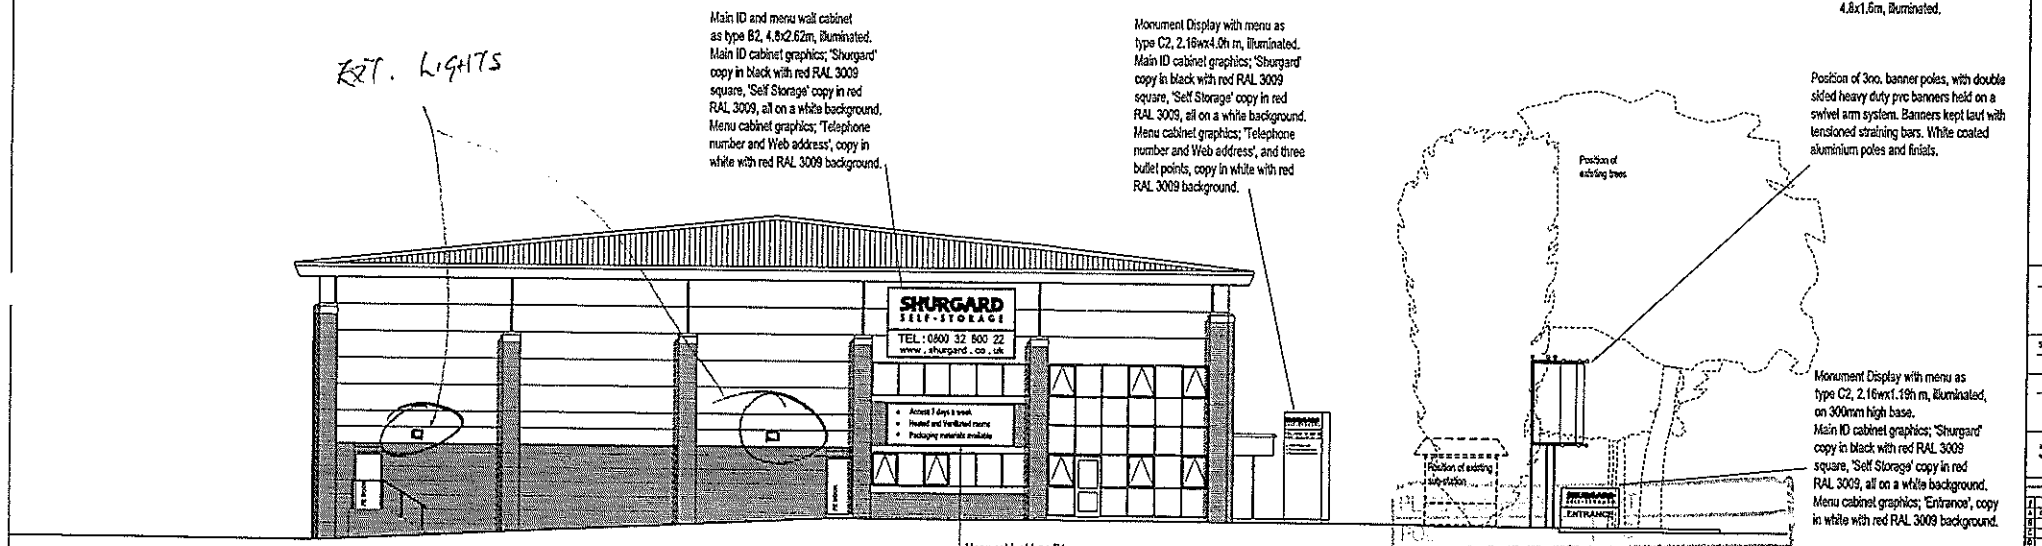

SIDE ELEVATION (NORTH ELEVATION FACING BARKHAM ROAD)

MOLLY MILLARS LANE WOKINGHAM

SHURGARD SELF-STORAGE
UNITED KINGDOM
14 St. MARYS ROAD, LONG DITCH SURBITON SURREY KT6 5EY
Tel: +44 20 8339 2700
Fax: +44 20 8339 2800

SITE LOCATION:
UK- WOKINGHAM LOCATION

SHURGARD PROJECT NUMBER:
DC-0206

DRAWING PACKAGE:
FOR INFORMATION

These documents are intended as guidelines for use in preparation of Site Specific Construction Documents

DATE: 27/08/02
CREATED BY DC

	REVISION	DATE
A	Cont/Add app. reviewed	14.10.02
B		
C		
D		
E		
F		
G		
H		
J		
K		
L		
M		
N		
O		
P		

SIGNAGE
WOKINGHAM

SCALE: 1/200@A3

UNIT1-MM3
MOLLY MILLARS LANE
BERKS, RG41 2RT

DRAWING TYPE: | DRAWING NUMBER:

A3 02A

23 FEB 2003
COPIES

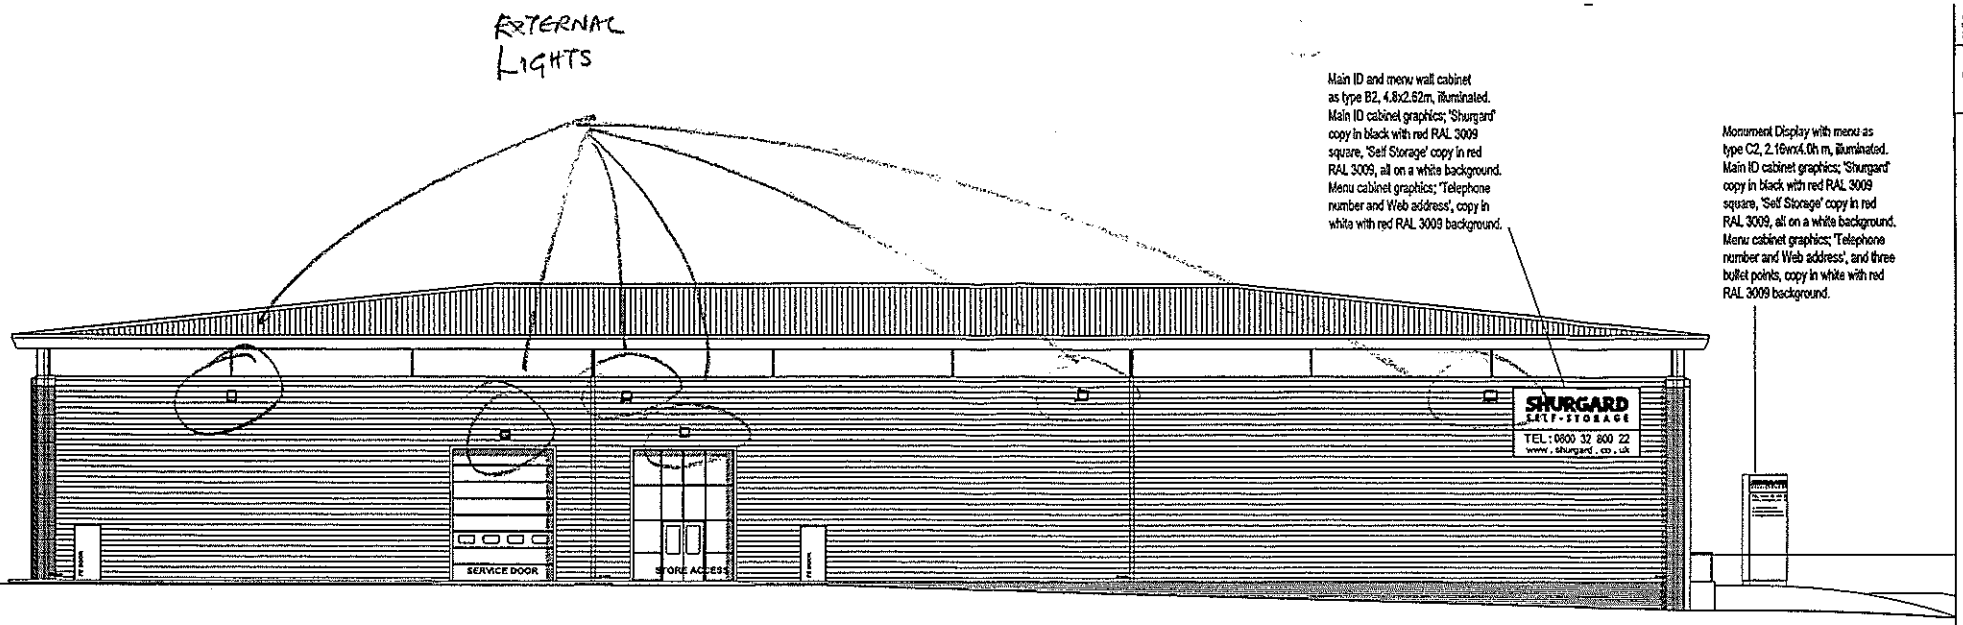

REAR ELEVATION (EAST ELEVATION FACING SERVICE AREA)

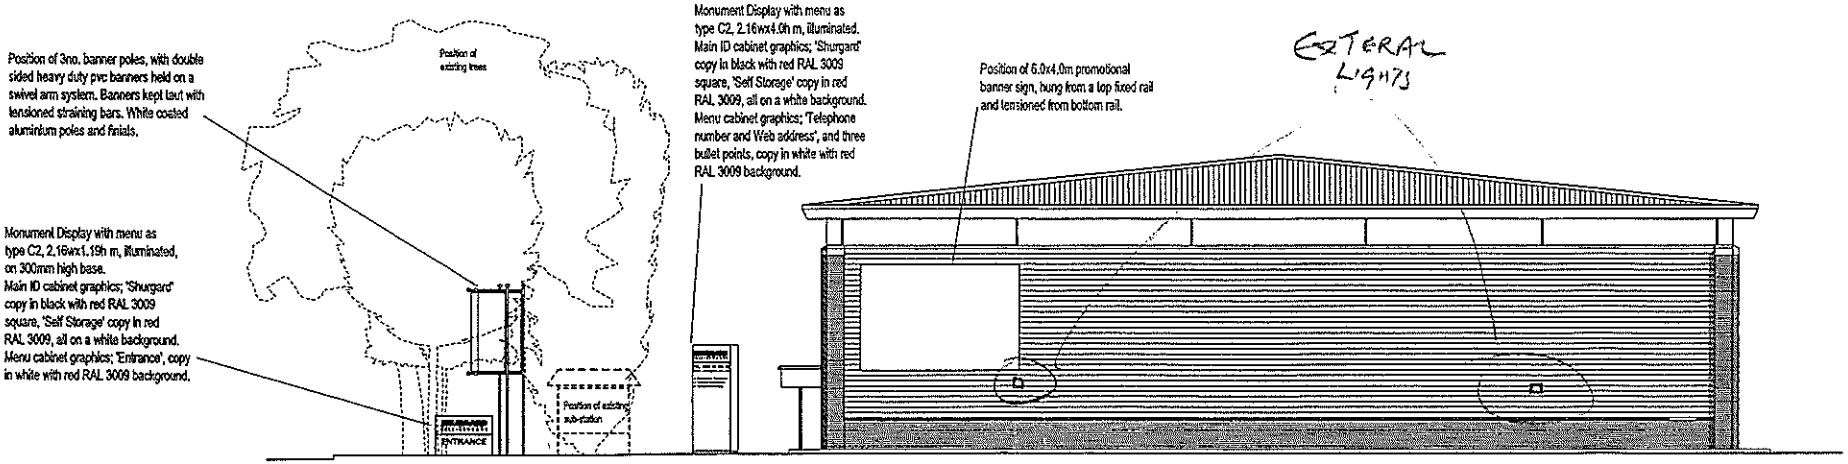

SIDE ELEVATION (SOUTH ELEVATION FACING ACCESS ROAD)

MOLLY MILLARS LANE WOKINGHAM

SHURGARD SELF-STORAGE
UNITED KINGDOM
14 St. Marys Road, Long Ditton
Surbiton Surrey KT6 5EY
Tel: +44 20 8339 2700
Fax: +44 20 8339 2800

SITE LOCATION:
UK- WOKINGHAM LOCATION

SHURGARD PROJECT NUMBER:
DC-0206

DRAWING PACKAGE:
FOR INFORMATION

These documents are intended as guidelines for use in preparation of Site Specific Construction Documents

CREATED BY DC

	REVISION:	DATE:
A	Comment plan reviewed	14.10.02
B		
C		
D		
E		
F		
G		
H		
J		
K		
L		
M		
N		
O		
P		

SIGNAGE
WOKINGHAM

SCALE: 1/200@A3

UNIT1-MM3
MOLLY MILLARS LANE
BERKS, RG41 2RT

DRAWING TYPE: | DRAWING NUMBER:
A3 03A

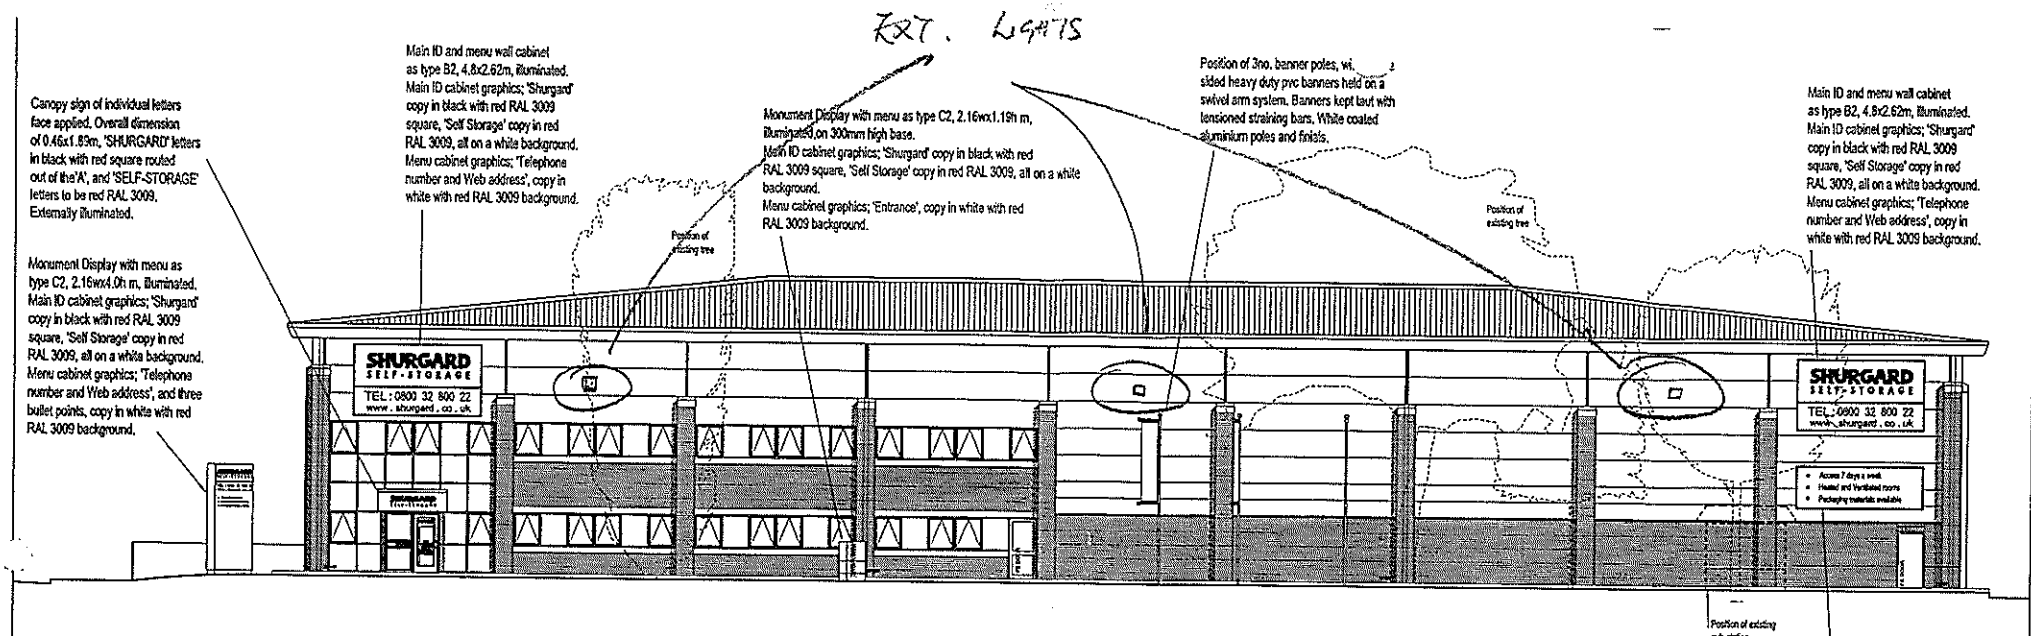

FRONT ELEVATION (WEST ELEVATION FACING MOLLY MILLARS LANE)

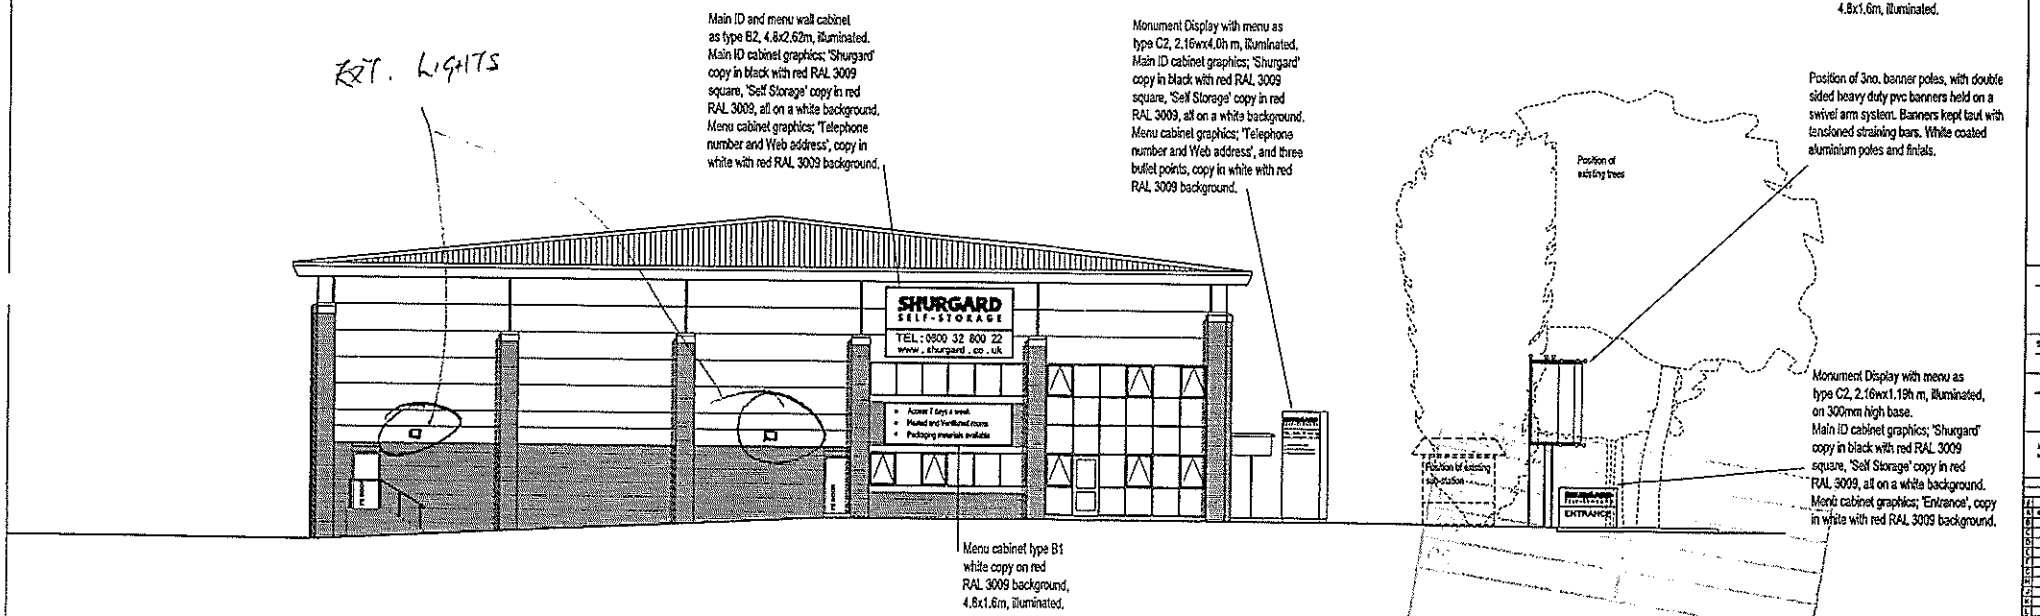

SIDE ELEVATION (NORTH ELEVATION FACING BARKHAM ROAD)

MOLLY MILLARS LANE WOKINGHAM

26 FEB 2003
COPIES TO
FILE

SHURGARD SELF-STORAGE
UNITED KINGDOM
14 St. Marys Road, Long Ditton
Surbiton Surrey K16 5EY
Tel: +44 20 8339 2700
Fax: +44 20 8339 2800

SITE LOCATION:
UK- WOKINGHAM LOCATION

SHURGARD PROJECT NUMBER:
DC-0206

DRAWING PACKAGE:
FOR INFORMATION

These documents are intended as guidelines for use in preparation of Site Specific Construction Documents

ISSUE: 27/09/02
CREATED BY DC

	REVISION	DATE
A	Gen/Mil dgn revised	14.10.02
B		
C		
D		
E		
F		
G		
H		
J		
K		
L		
M		
N		
O		
P		

SIGNAGE
WOKINGHAM

SCALE: 1/200@A3

UNIT1-MM3
MOLLY MILLARS LANE
BERKS, RG41 2RT

DRAWING TYPE | DRAWING NUMBER

A3 02A

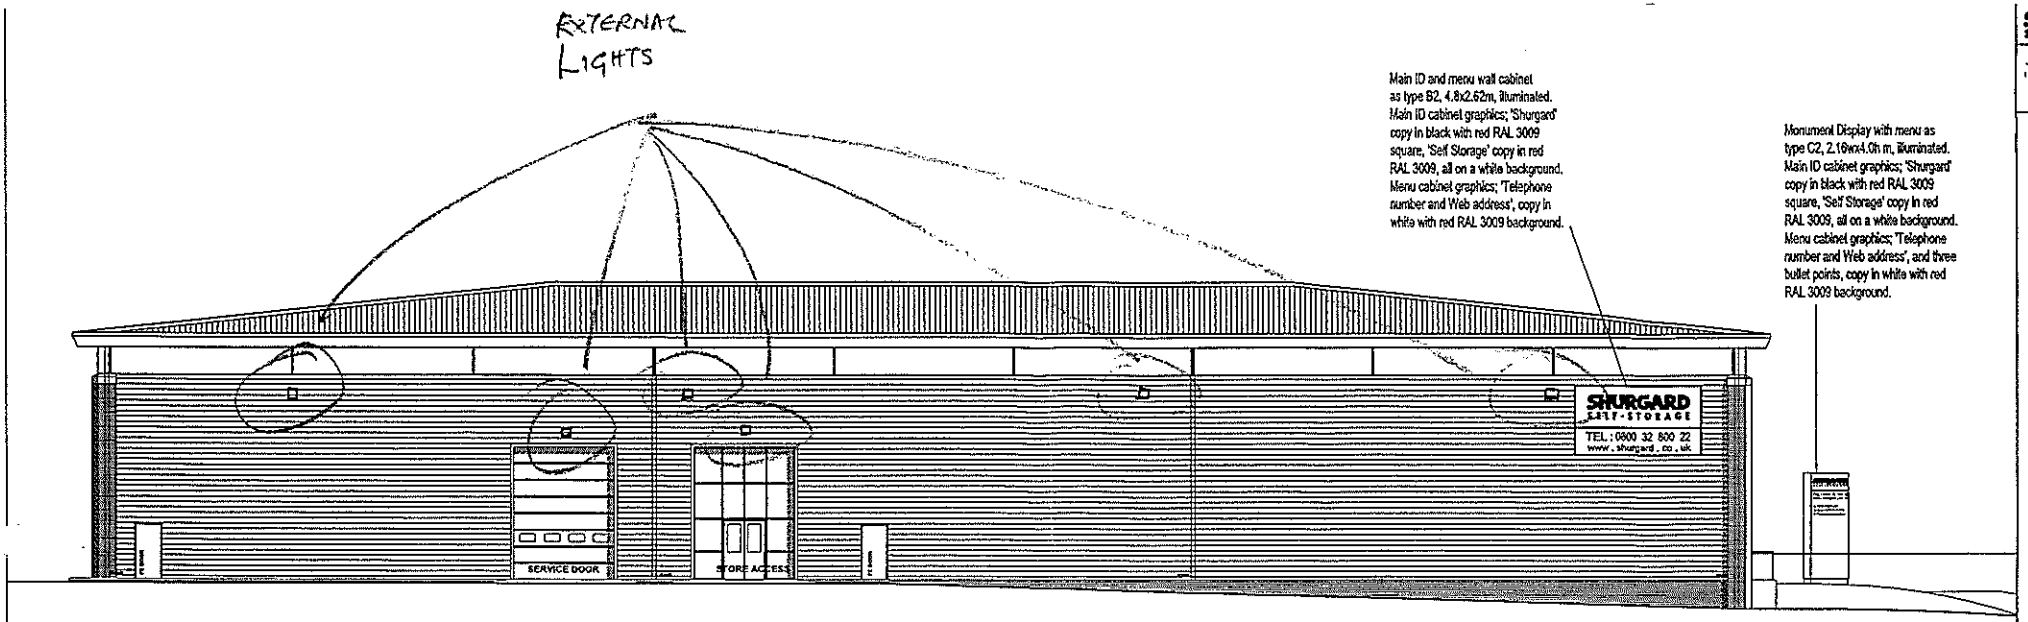

REAR ELEVATION (EAST ELEVATION FACING SERVICE AREA)

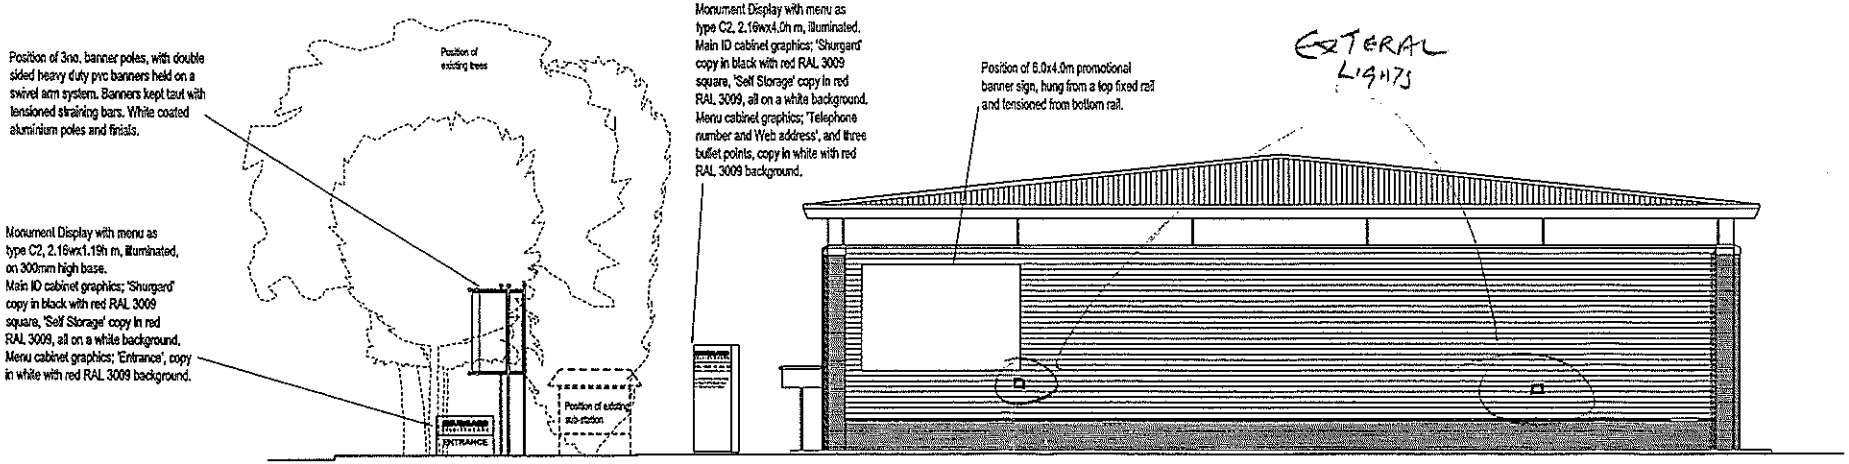

SIDE ELEVATION (SOUTH ELEVATION FACING ACCESS ROAD)

MOLLY MILLARS LANE WOKINGHAM

SHURGARD SELF-STORAGE
UNITED KINGDOM
11 St. Marys Road, Long Ditton
Surbiton Surrey KT6 5EY
Tel: +44 20 8339 2700
Fax: +44 20 8339 2900

SITE LOCATION:
UK- WOKINGHAM LOCATION

SHURGARD PROJECT NUMBER:
DC-0206

DRAWING PACKAGE:
FOR INFORMATION

These documents are intended as guidelines for use in preparation of Site Specific Construction Documents

ISSUE: 27/09/02
CREATED BY DC

	REVISION	DATE
A	Gantry dwg removed	14.10.02
B		
C		
D		
E		
F		
G		
H		
J		
K		
L		
M		
N		
O		
P		

SIGNAGE
WOKINGHAM

SCALE: 1/200@A3

UNIT1-MM3
MOLLY MILLARS LANE
BERKS, RG41 2RT

DRAWING TYPE: A3
DRAWING NUMBER: 03A

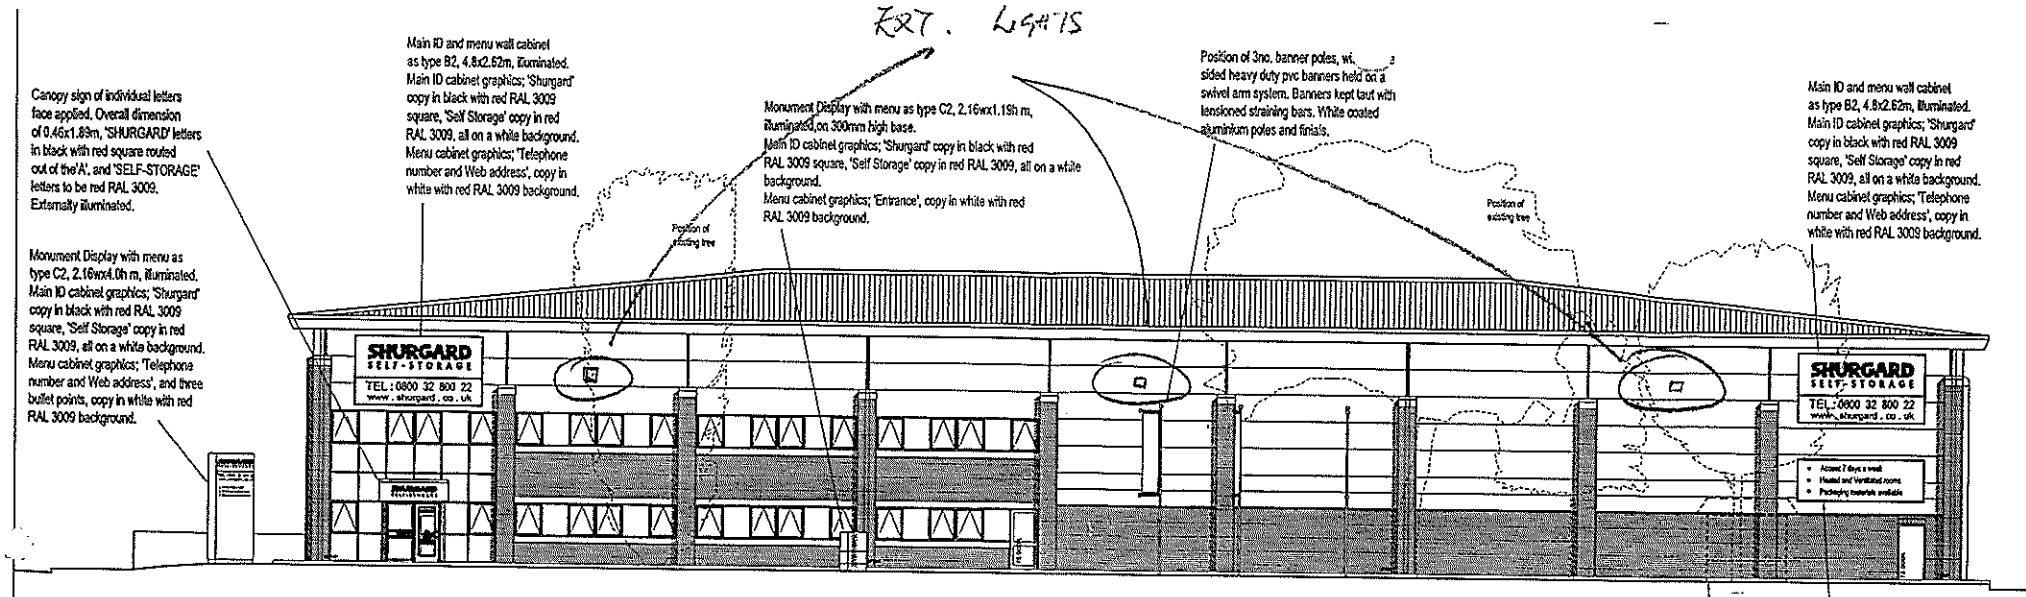

FRONT ELEVATION (WEST ELEVATION FACING MOLLY MILLARS LANE)

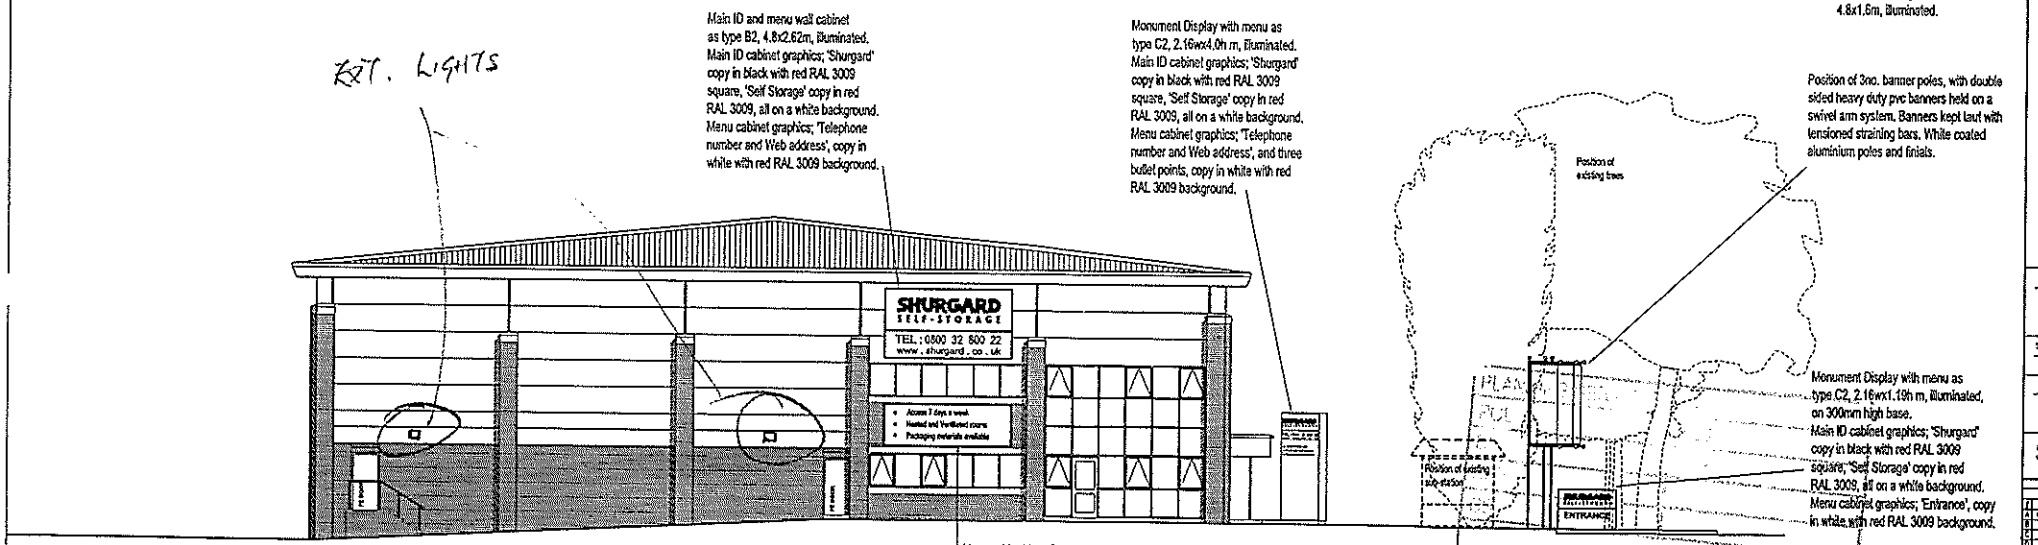

SIDE ELEVATION (NORTH ELEVATION FACING BARKHAM ROAD)

MOLLY MILLARS LANE WOKINGHAM

26 FEB 2003

COPIES TO | ACK: | FILE:

SHURGARD SELF-STORAGE
UNITED KINGDOM
11 St. Marys Road, Long Ditton
Surbiton Surrey KT6 5CY
Tel. +44 20 8339 2700
Fax +44 20 8339 2800

SITE LOCATION: UK- WOKINGHAM LOCATION

SHURGARD PROJECT NUMBER: DC-0206

DRAWING PACKAGE: FOR INFORMATION

These documents are intended as guidelines for use in preparation of Site Specific Construction Documents

ISSUE: 27/09/02
DRAWN BY: DC

REVISION:	DATE:
Con/sgn sign removed	14.10.02

SIGNAGE
WOKINGHAM

SCALE: 1/200@A3

UNIT1-NM3
MOLLY MILLARS LANE
BERKS, RG41 2RT

DRAWING TYPE: | DRAWING NUMBER:

A3 02A

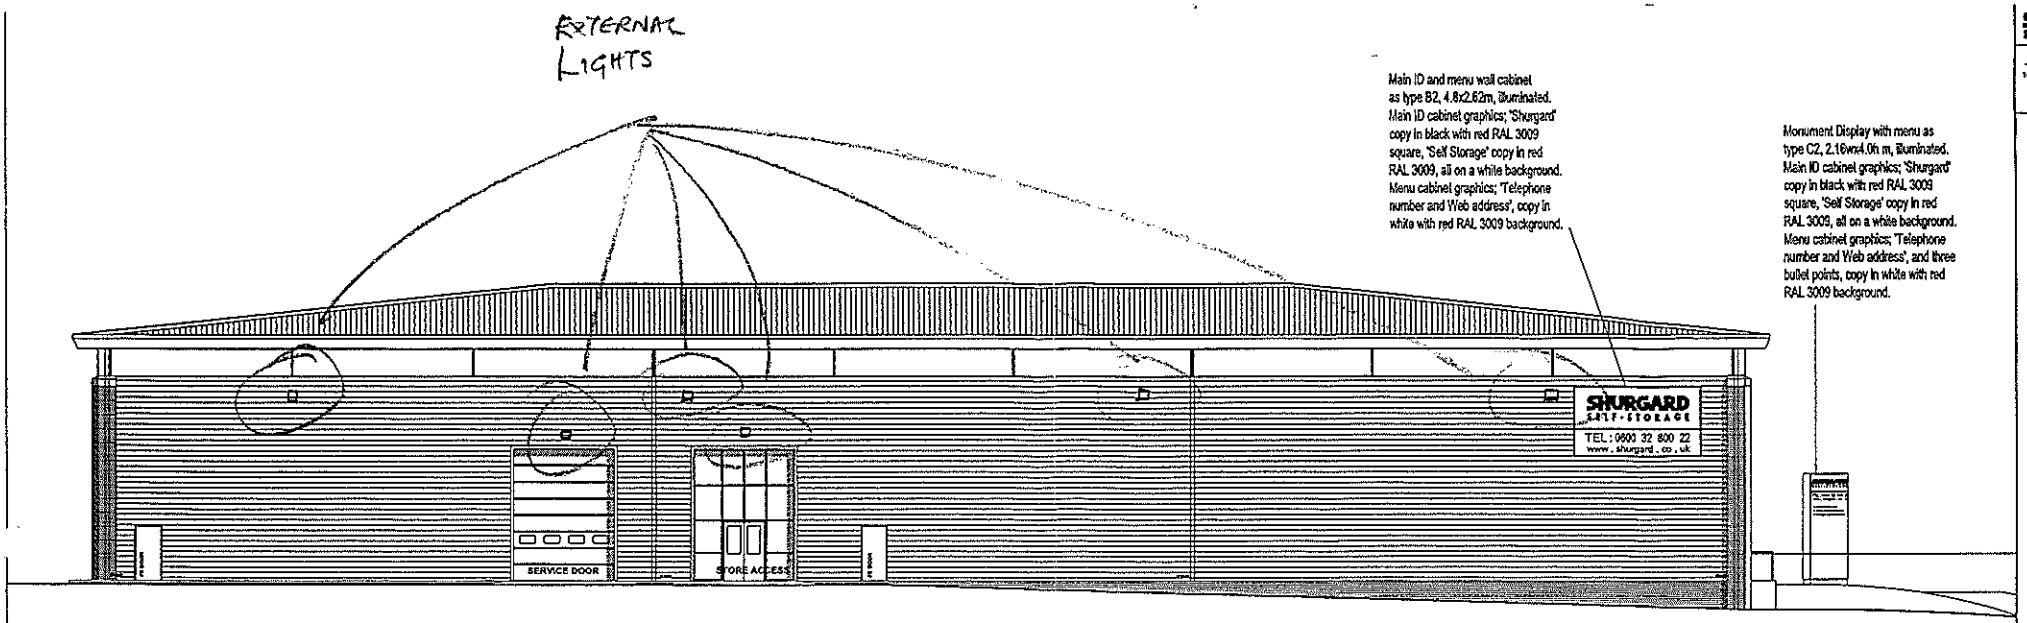

REAR ELEVATION (EAST ELEVATION FACING SERVICE AREA)

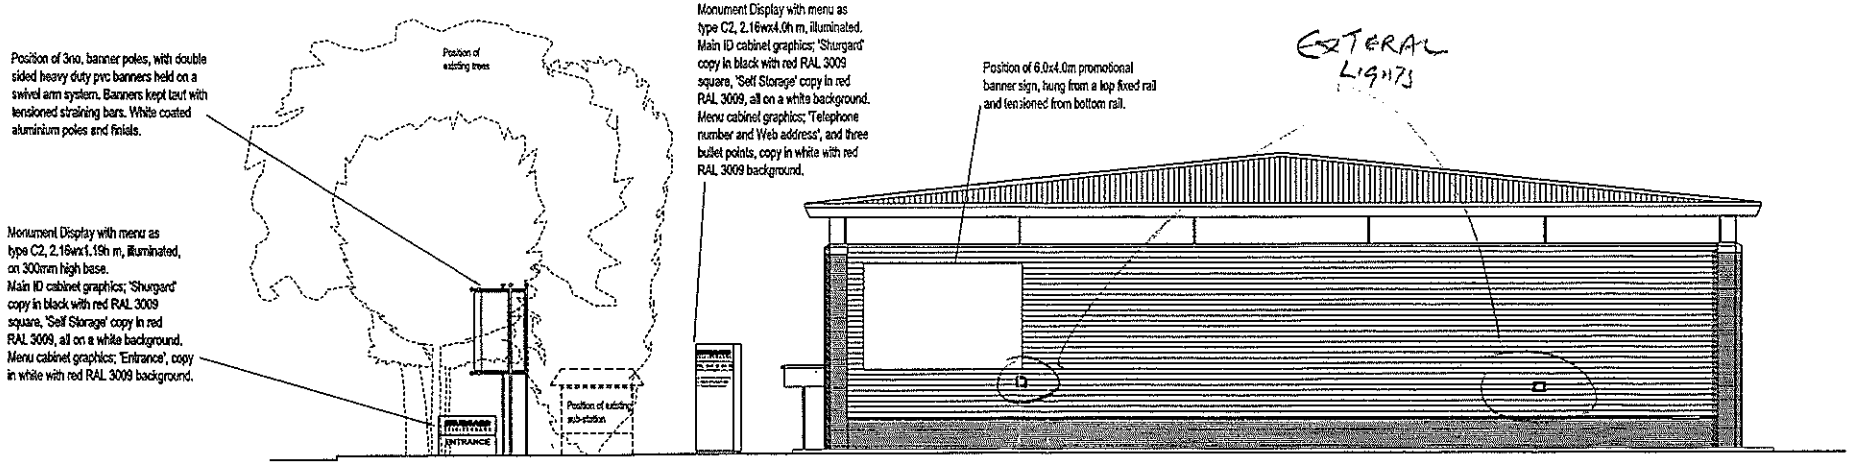

SIDE ELEVATION (SOUTH ELEVATION FACING ACCESS ROAD)

MOLLY MILLARS LANE WOKINGHAM

SHURGARD SELF-STORAGE
UNITED KINGDOM
14 St. Marys Road, Long Ditton
Surbiton Surrey KT6 5EY
Tel: +44 20 8339 2700
Fax: +44 20 8339 2800

SITE LOCATION:
UK- WOKINGHAM LOCATION

SHURGARD PROJECT NUMBER:
DC-0206

DRAWING PACKAGE:
FOR INFORMATION

These documents are intended as guidelines for use in preparation of Site Specific Construction Documents

ISSUE: 27/09/02
CREATED BY DC

	REVISION:	DATE:
A	Comment sign removed	14.10.02
B		
C		
D		
E		
F		
G		
H		
J		
K		
L		
M		
N		
O		
P		

SIGNAGE
WOKINGHAM

SCALE: 1/200@A3

UNIT1-MM3
MOLLY MILLARS LANE
BERKS, RG41 2RT

DRAWING TYPE: A3
DRAWING NUMBER: 03A