


Temporary site for 2-5 years, all materials used to last the life span of the project.

PLATFORM

A detailed site plan of the building complex. The plan shows the building footprint with various rooms and courtyards. A large parking area is located to the left of the building. A road or driveway runs along the bottom of the site. The plan includes landscaping elements like trees and shrubs. A red line outlines the property boundary. A north arrow is located in the bottom right corner of the plan.

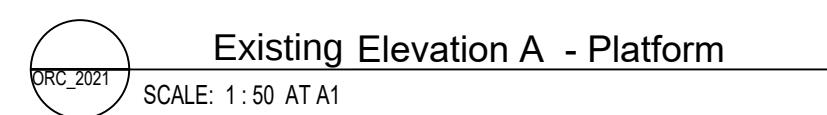

Date	Description	Drawn By
------	-------------	----------

Project: RG6 1RA

Reading Innovation Lab

ARCADIS House, 34 York Way, London, N1 9AB www.arcadis.com

awn	NM	First Issue:	Date 29.06.2021
ale:	1:100@A1	Designer	NM



Drawing Title: FOR PLANNING: Existing Platform Elevations 01

Drawing Number:	Revision:
10047578-ARC-B22-XX-DR-AR-00023	D


Copyright reserved

NOTES:


PLATFORM

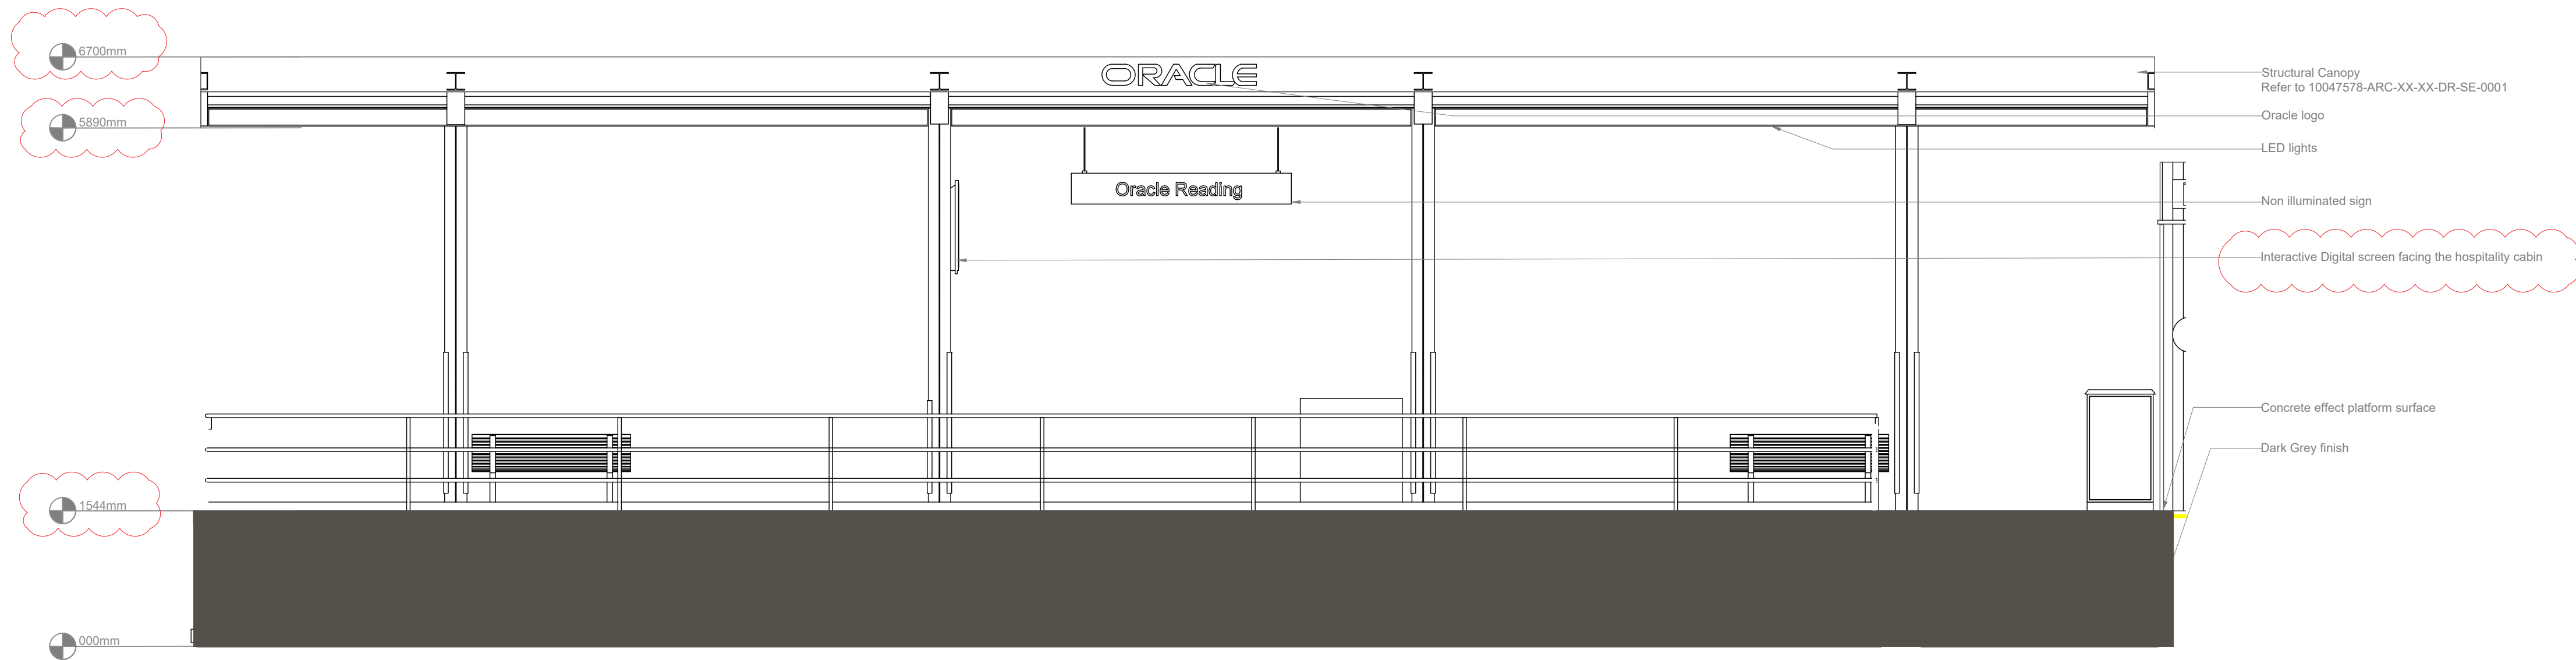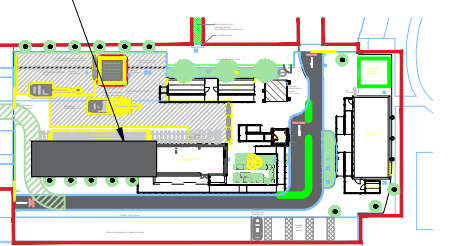

Existing Elevation B - Platform
SCALE: 1: 50 AT A1

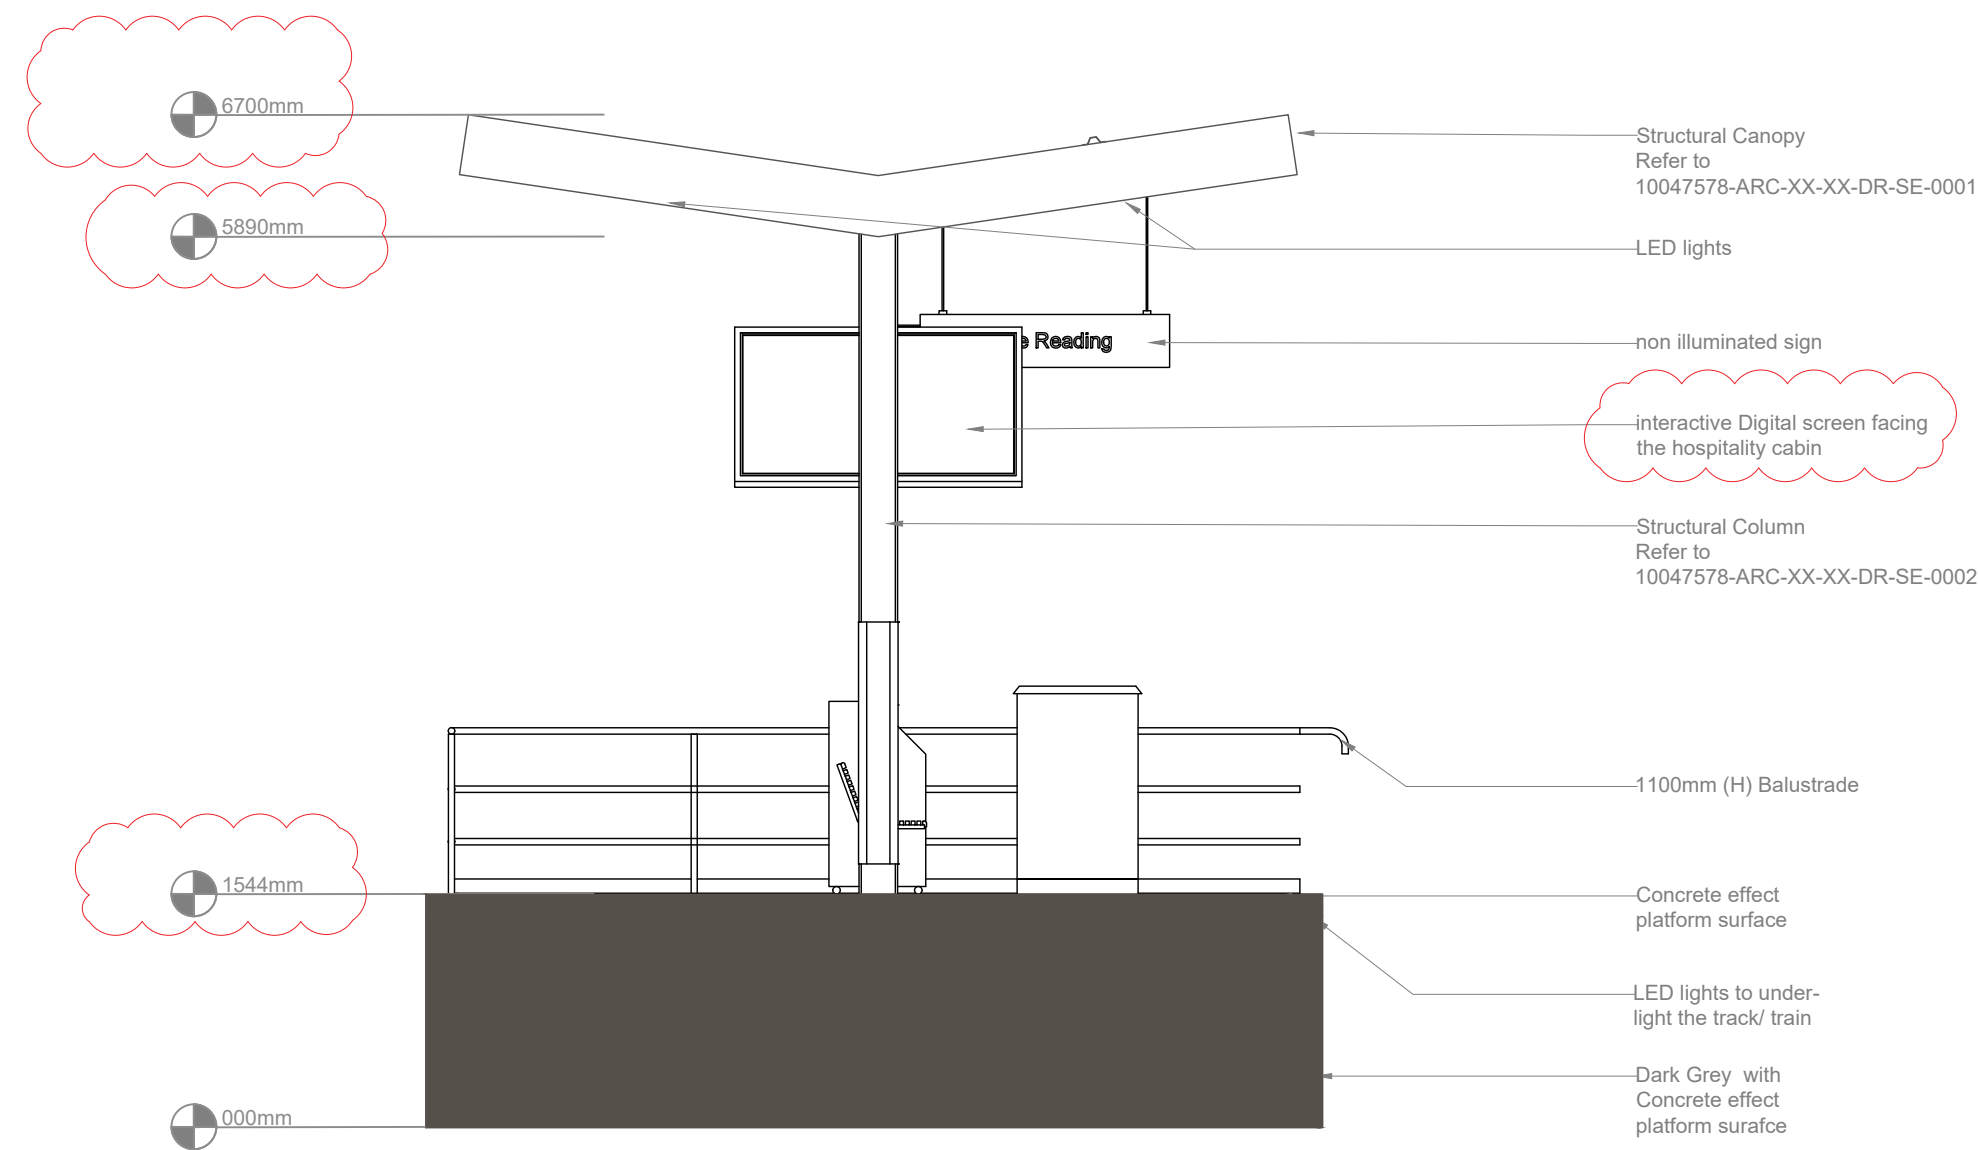

Existing Elevation C - Platform
SCALE: 1: 50 AT A1

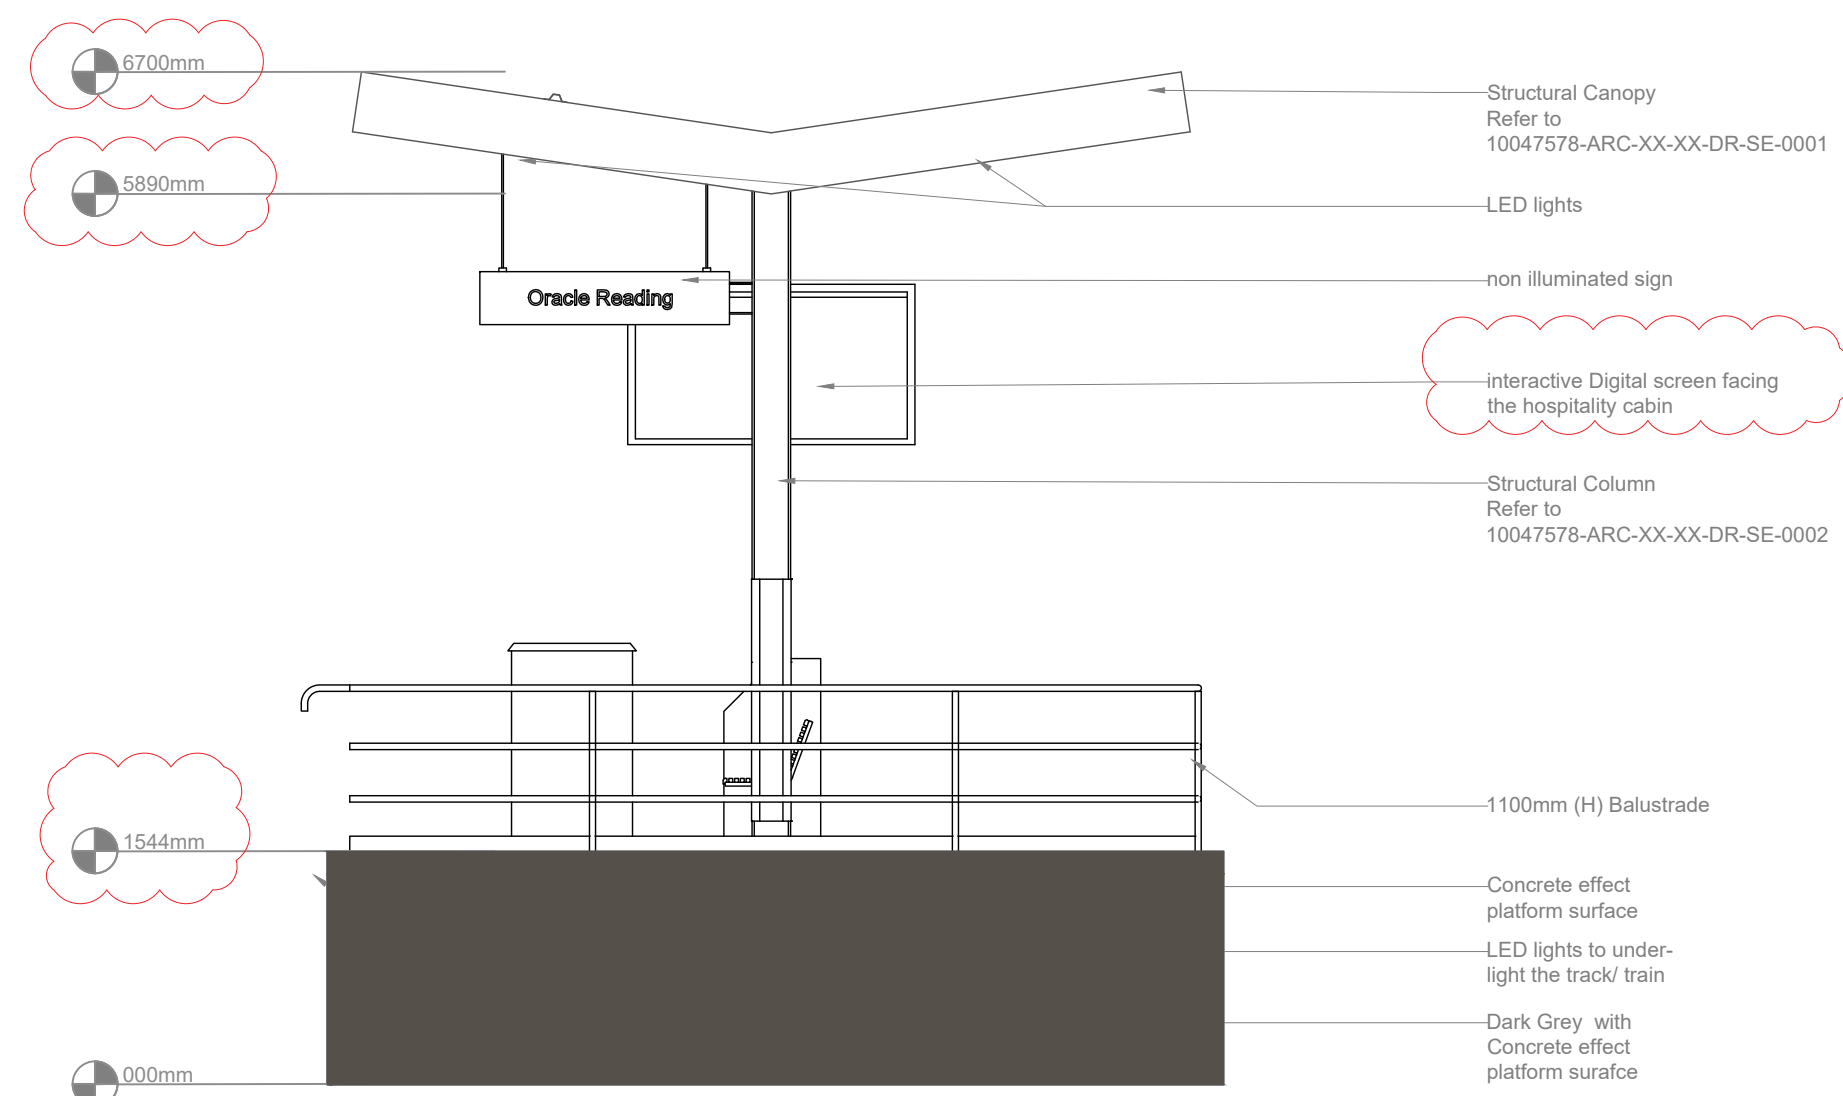

Existing Elevation D - Platform
SCALE: 1: 50 AT A1

Rev	Date	Description	Drawn By
D	19.08.22	Revision to Planning	CL
C	13.10.21	Updated Elevation Height	RS
B	13.10.21	Updated drawings from RIBA's	RS
A	26.08.21	Correct scale shown in titleblock	CS

Oracle Corporation Oracle Parkway Thames Valley Park Reading Berkshire RG6 1BA	Project: Reading Innovation Lab
---	------------------------------------

ARCADIS	ARCADIS
---------	---------

ARCADIS House, 34 York Way, London, N1 9AB	www.arcadis.com
--	-----------------

Drawn: NM	First Issue: 29.08.2021
Scale: 1:100@A1	Designer: NM

Drawing Title: Existing FOR PLANNING: Platform Elevations 02	Drawing Number: 10047578-ARC-B23-XX-DR-AR-00024	Revision: D
--	--	----------------

100mm on Original

Print Date: 07/10/2022 2:37:26 PM

C:\Users\clm1834\ARCADIS\10047578 - Reading Innovation Centre - Proposed\ARC_ORA_10047578_00_Innovations Lab rev G_For Planning.dwg

© Copyright reserved