F/2000/0380

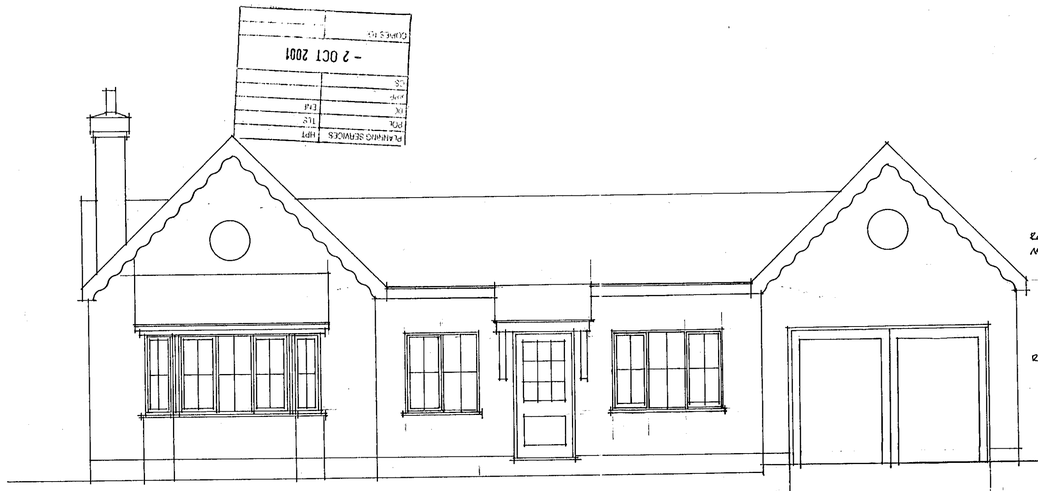

FRONT ELEVATION

ROOF TILES TO MATCH EXISTING.

RENDERED WALLS.

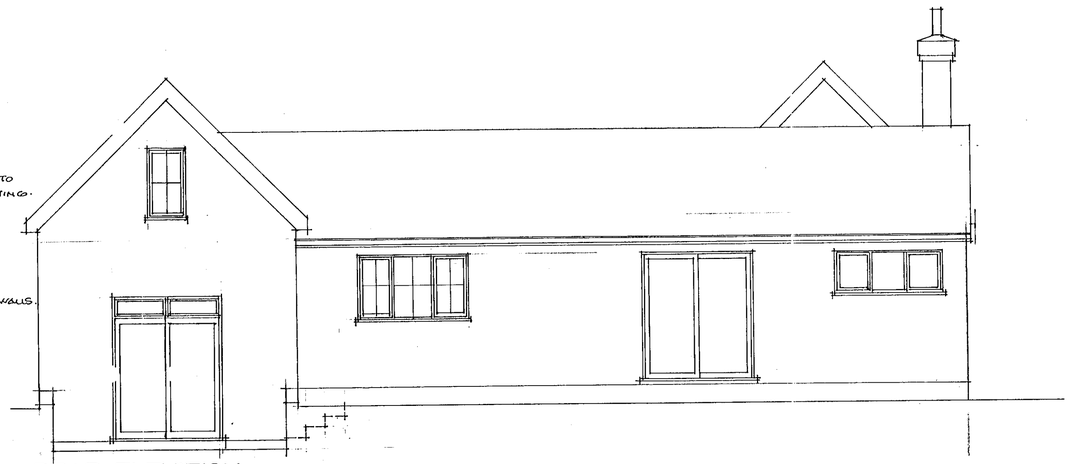

REAR ELEVATION

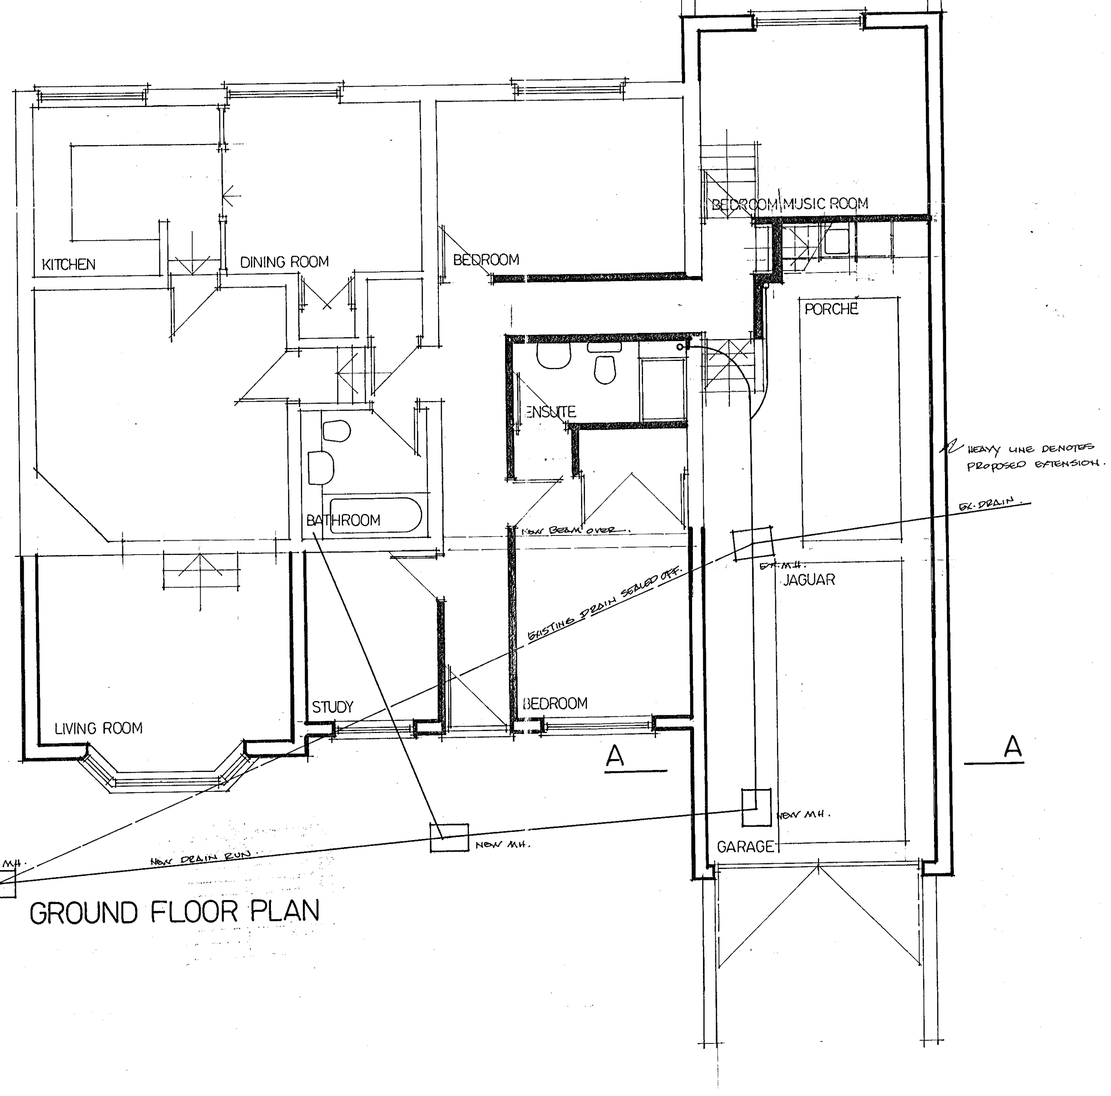

GROUND FLOOR PLAN

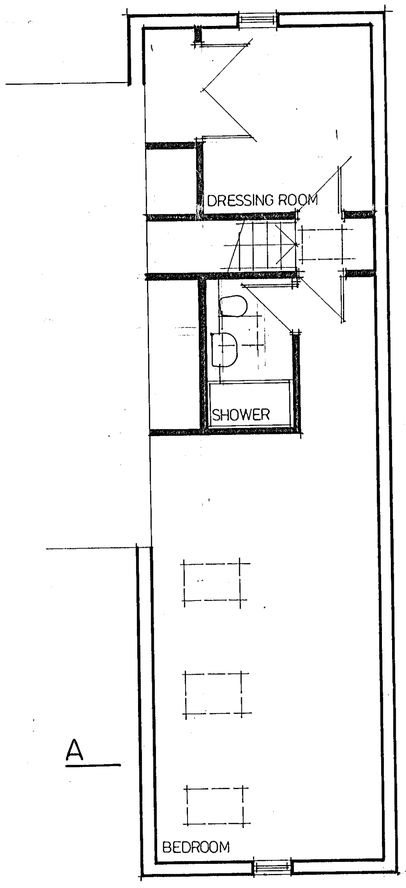

FIRST FLOOR PLAN

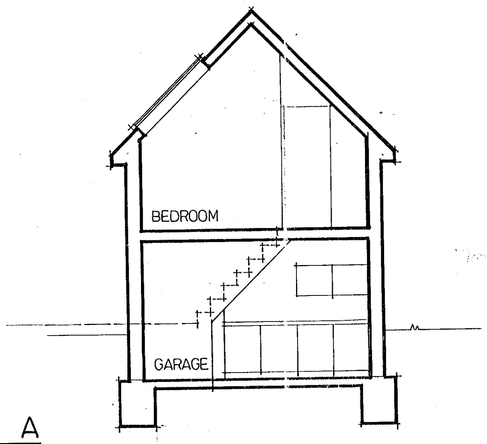

SECTION A.A

Minor amendment - see letter dated 22/11/01

PLANNING SERVICES	INIT
POL	TLS
DC	ENF
APP	
CS	
- 2 OCT 2001	
COPIES TO:	GR:
	FILE:

This drawing should not be scaled. All dimensions to be checked on site.
The information contained on this drawing is the copyright of Harrall Design Associates.

REVISIONS

B. 11.7.01. REVISED FLOOR PLAN.
C. 21.8.01 REVISION TO SECTION (FLOOR LEVELS)
D. 27.9.01 MINOR CHANGES.

Harrall Design Associates
Architectural : Interior : Shopfitting : Landscape
14 Tomlinson Drive Wokingham Berkshire RG40 3NZ Tel/Fax: 0118 973 3069

CLIENT
MR. P. DUTT

PROJECT
PROPOSED EXTENSION TO
BRAMLEY COTTAGE
107 KILN RIDE
WOKINGHAM

TITLE
ALTERNATIVE PROPOSAL

SCALE	DATE
1.50	MARCH 2000

DRAWING NO.	REVISION
9910. P.3	D

1PR 156

RED LINE DENOTES LINE OF APPROVED RIDGE

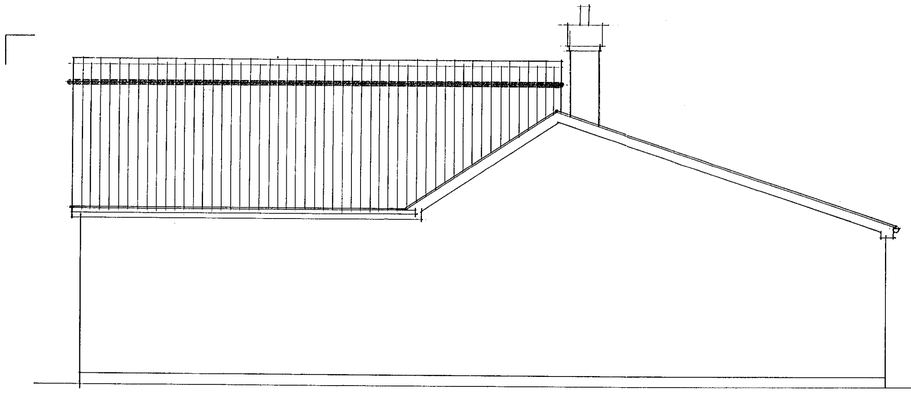

SIDE ELEVATION

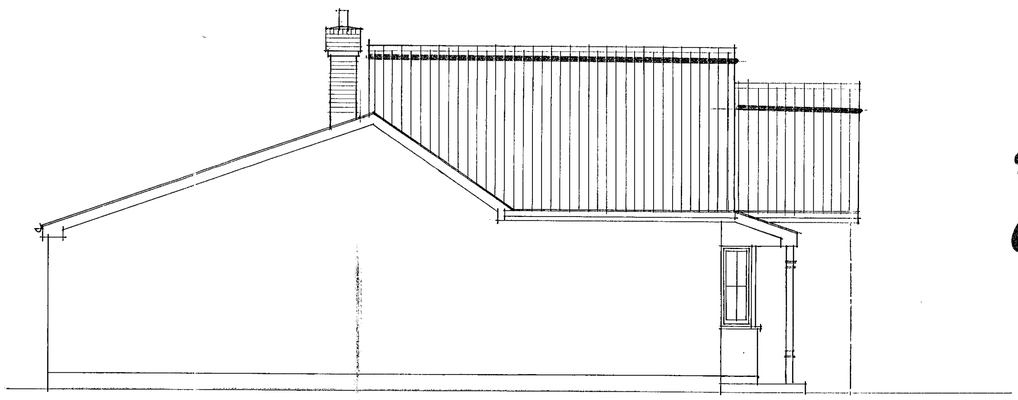

SIDE ELEVATION



FRONT ELEVATION

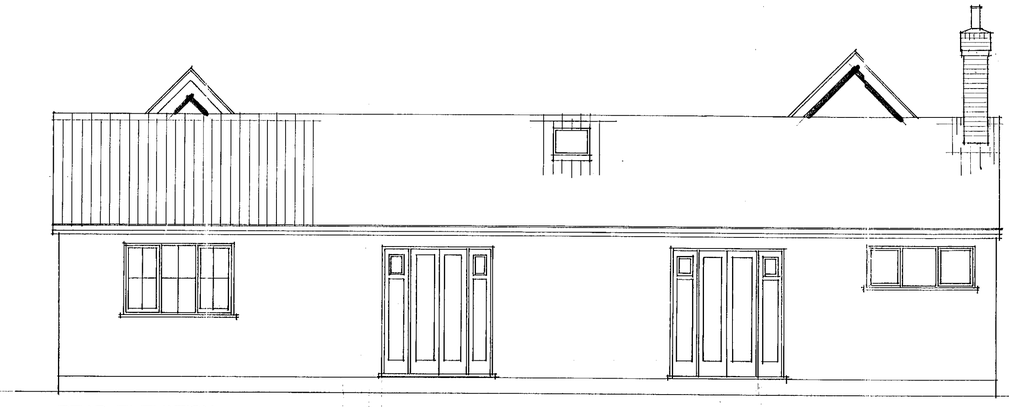

REAR ELEVATION

EXTERNAL MATERIALS | FINISHES

ROOF. CONCRETE TILES TO MATCH EXISTING
CHIMNEY. RED BRICK

DECORATIVE BARGE BOARDS TO NEW FRONT ELEVATION

LEAN TO | VERANDA
CONCRETE TILES AS MAIN ROOF
PATENT GLAZING
TURNED TIMBER SUPPORTS . PAINTED

WINDOWS | DOORS
SOFTWOOD . STAINED

WALLS
RENDERED AS EXISTING . PAINTED

PAINTED PLINTH

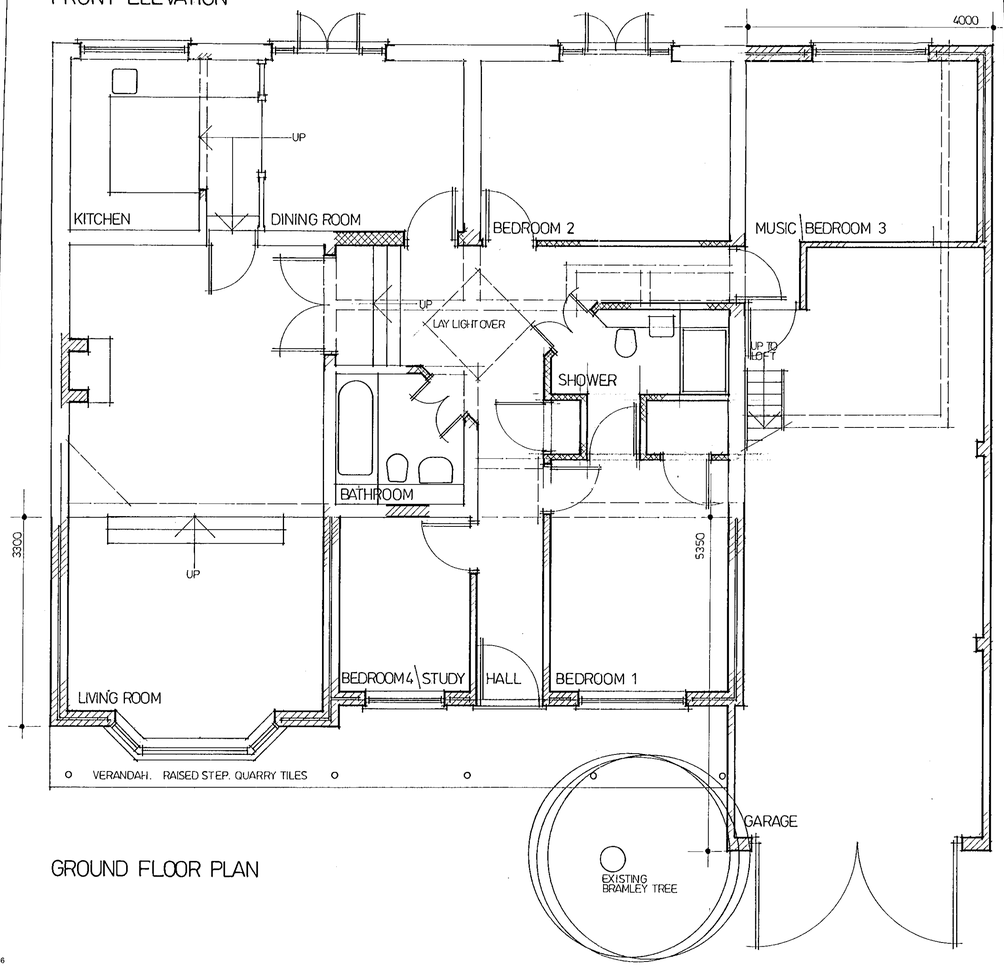

GROUND FLOOR PLAN

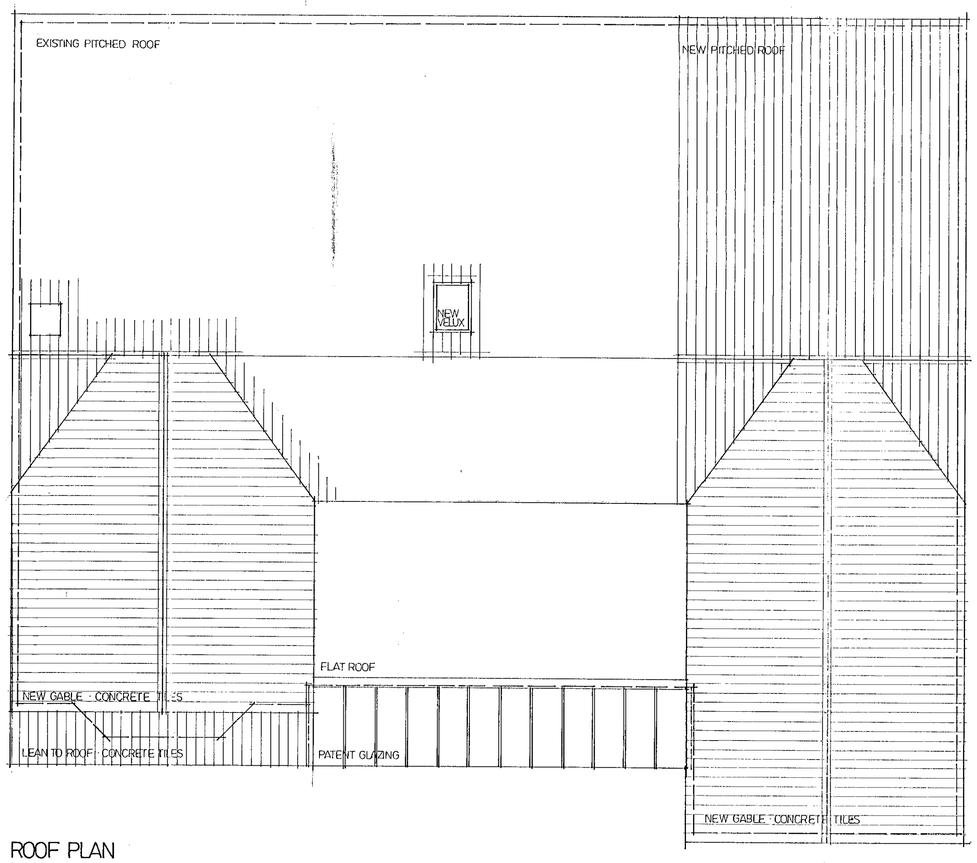

ROOF PLAN

This drawing should not be scaled. All dimensions to be checked on site.
The information contained on this drawing is the copyright of Harrall Design Associates.

REVISIONS
A 17.12.99 MINOR ALTERATIONS TO RIDGE LINES AND FASCIAS
CHIMNEY STACK RELOCATED

16 JAN 2000* 0580

APPROVED

Harrall Design Associates
Architectural : Interior : Shopfitting : Landscape

14 Tomlinson Drive Wokingham Berkshire RG40 3NZ Tel/Fax: 0118 973 3089

CLIENT
MR. P DUTT

PROJECT
PROPOSED EXTENSION TO
BRAMLEY COTTAGE
107 KILN RIDE
WOKINGHAM

TITLE
PROPOSED PLANS + ELEVATIONS

SCALE 1.50
DATE AUG 99

DRAWING NO. 9910.2
REVISION A

09/16/3/00

TPR 156



FRONT ELEVATION

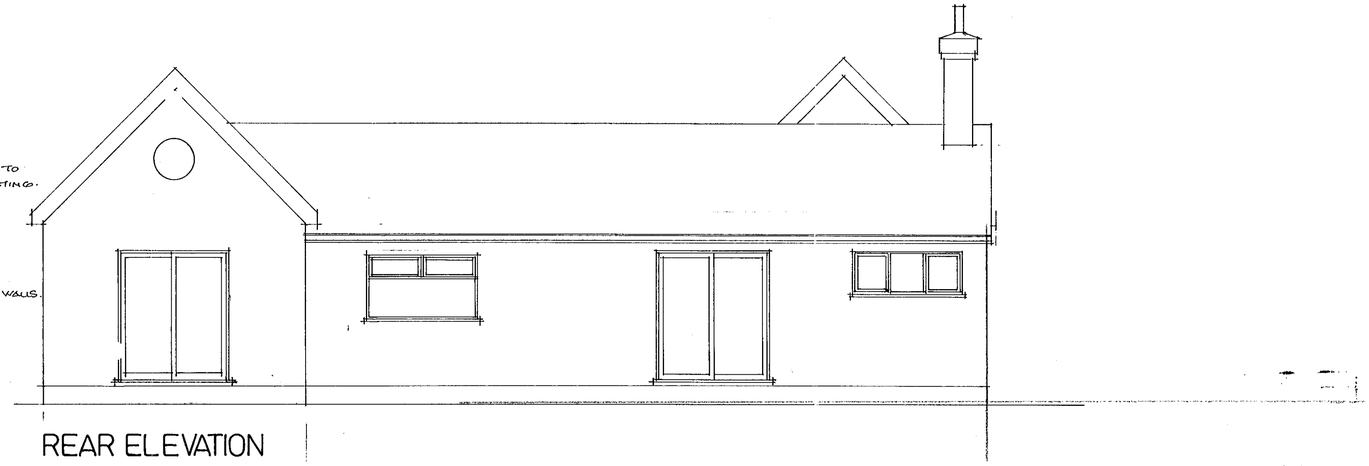

REAR ELEVATION

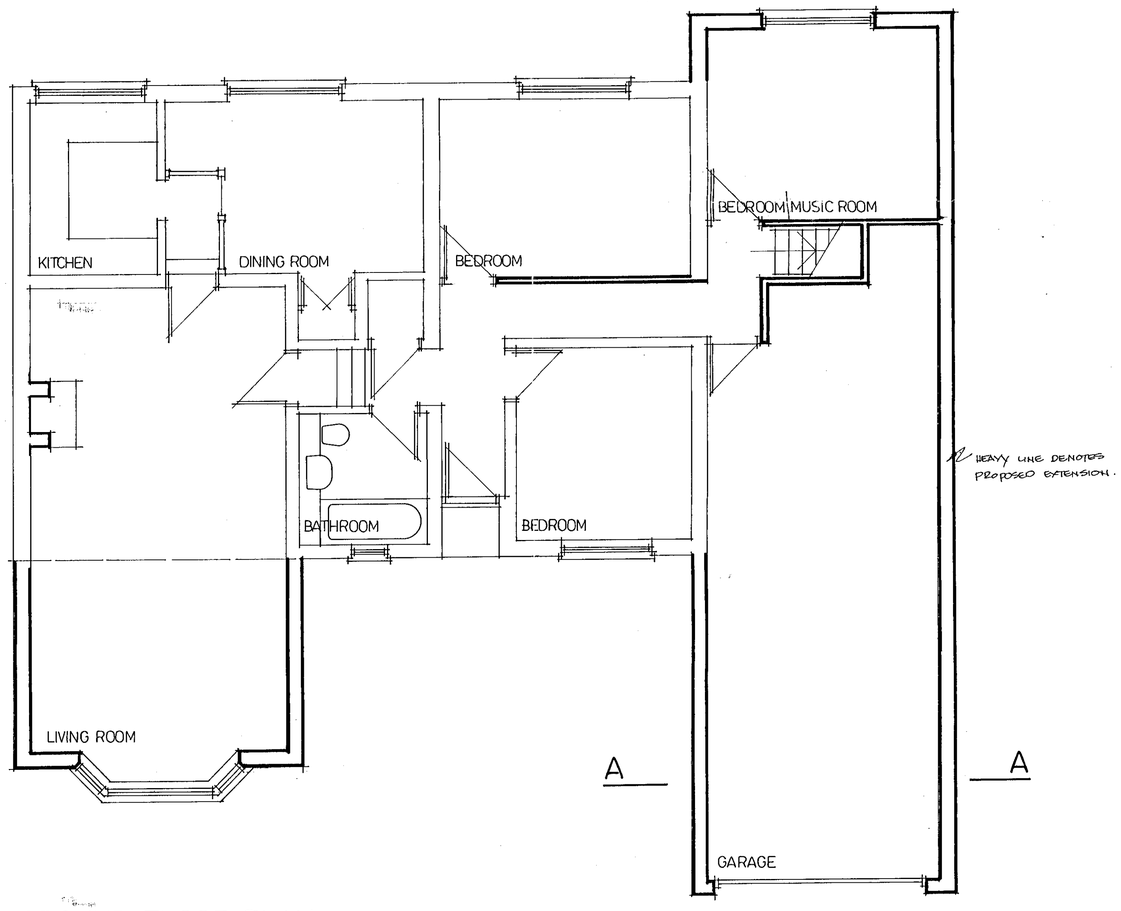

GROUND FLOOR PLAN

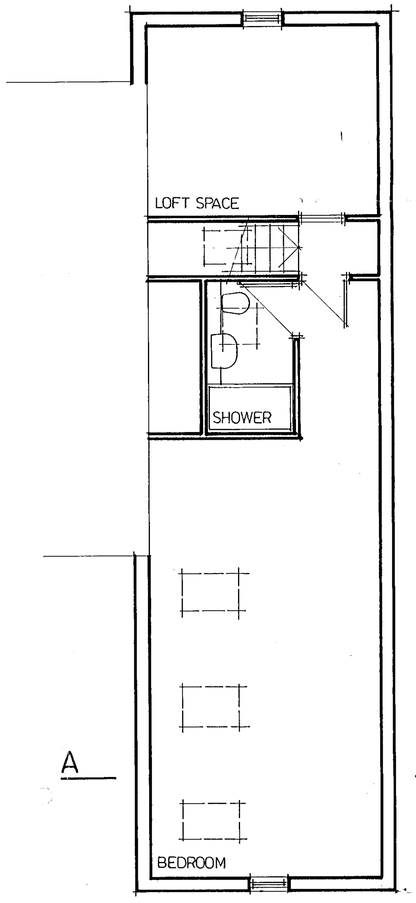

FIRST FLOOR PLAN

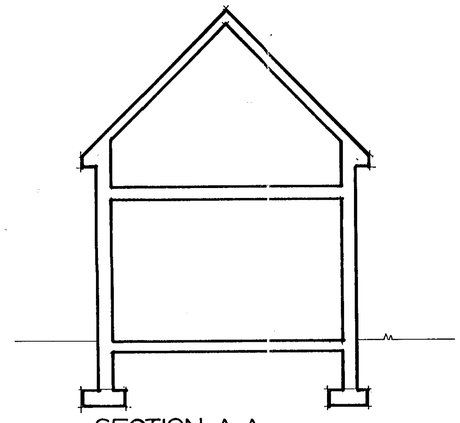

SECTION A.A

This drawing should not be scaled. All dimensions to be checked on site.
The information contained on this drawing is the copyright of Harrall Design Associates.

REVISIONS

PLANNING SERVICES	HPT
POL	TLS
DC	ENF
APP	
CS	
14 MAR 2000	
COPIES TO:	ADK:
	FILE:

Harrall Design Associates
Architectural : Interior : Shopfitting : Landscape

14 Tomlinson Drive Wokingham Berkshire RG40 3NZ Tel/Fax: 0118 973 3069

CLIENT
MR. P. DUTT

PROJECT
PROPOSED EXTENSION TO
BRAMLEY COTTAGE
107 KILN RIDE
WOKINGHAM

TITLE
ALTERNATIVE PROPOSAL

SCALE
1.50

DATE
MARCH 2000

DRAWING NO.
9910. P.3

REVISION
A