


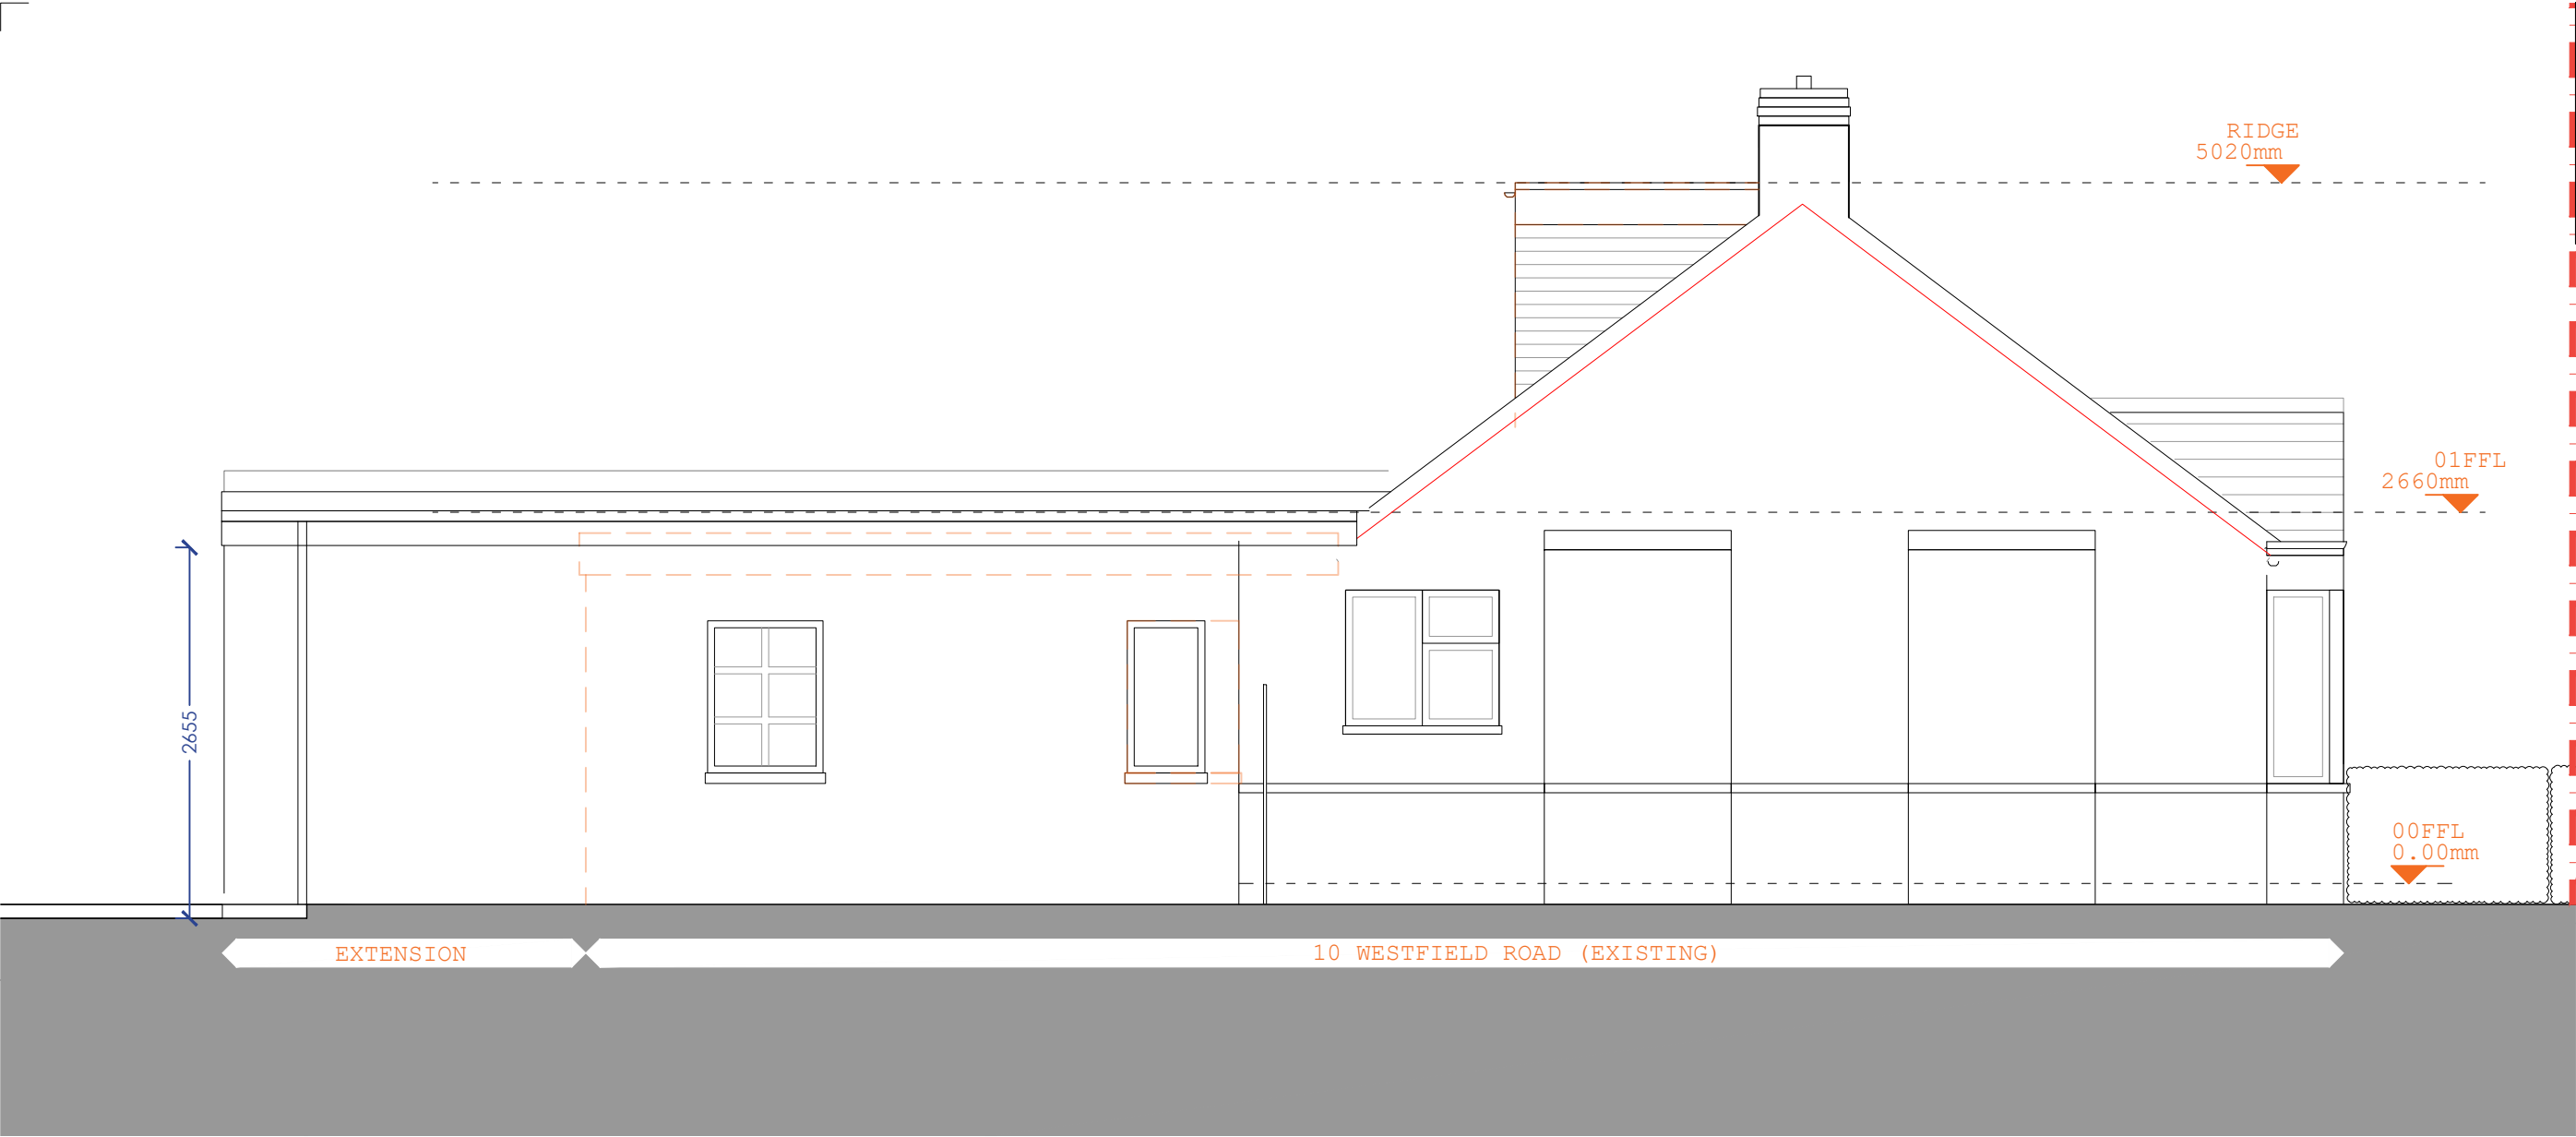

- KEY
- Site Boundary
 - As Agreed App No 242277
 - Proposed Additional Area

BUILDING REGS ISSUE

subject to: Regs approval. Building Control Plan Check.
Drainage Runs & invert level confirmation & Structural
Engineers input.

all drawings remain the copyright of colony and cannot be reproduced on whole or part without our approval this drawing is for planning purposes only and not a construction issue documents & drawings are not to be altered without the consent of colony dimensional accuracy only applies to the written notation drawings issued by colony are to be cross-referenced where necessary with other relevant consultants' information if any contradiction is found in the drawing set, or if you are in any doubt, ask the architect				Project: 10 Westfield Road Wokingham RG41 5ER						
	Collaborating with: Shakeel Khan			Drawing Name: Proposed Elevations Side			Colony Architects Ltd. The Wine Store, Brewery Court, Theale, Reading, RG7 5AJ +44 (0)118 380 0328 hello@colonyarchitects.com colonyarchitects.com			
	Job: 1036	Drawing: 05-11	Revision: -	Date: 02.2025	Status: Planning	Drawn By: IP	Checked By: EM			
	NOTES			1:50	01	02	03	04	05	06