1463

1465

REVISED PLAN

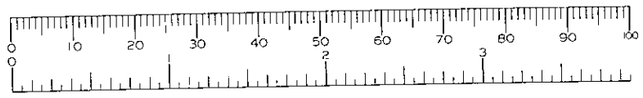

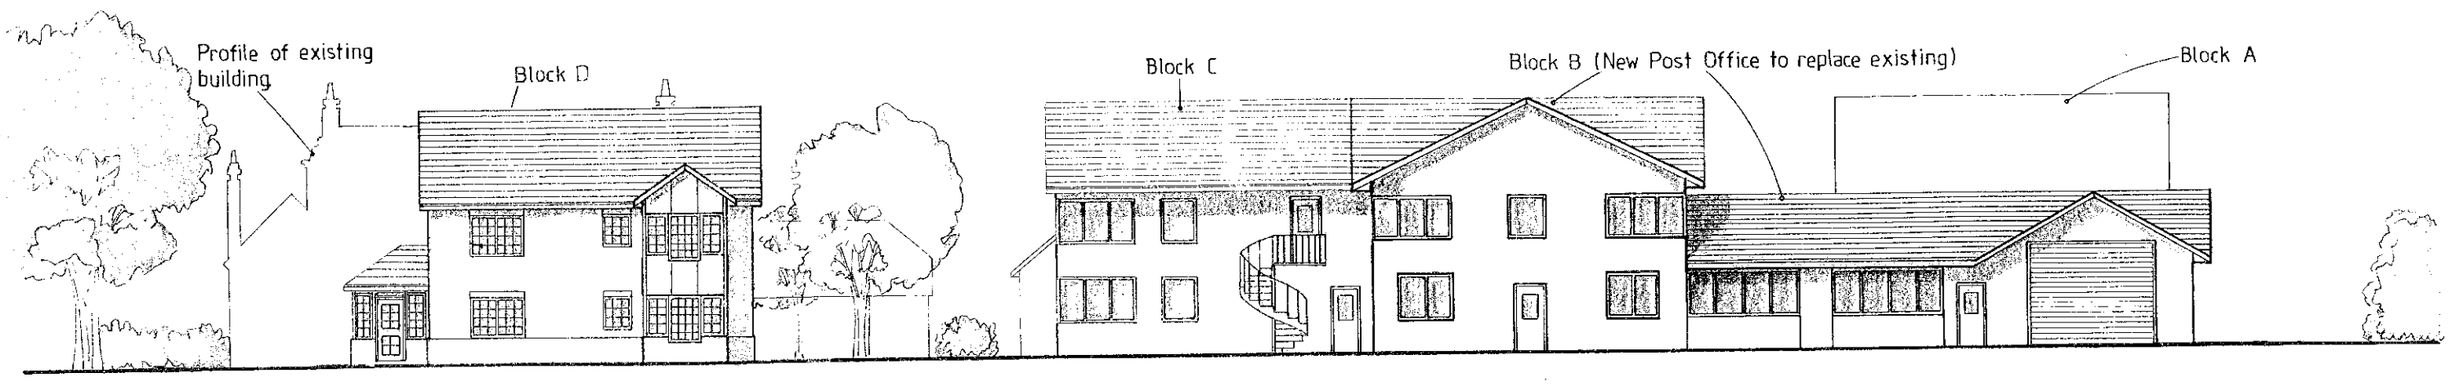

NORTH ELEVATION

EAST ELEVATION

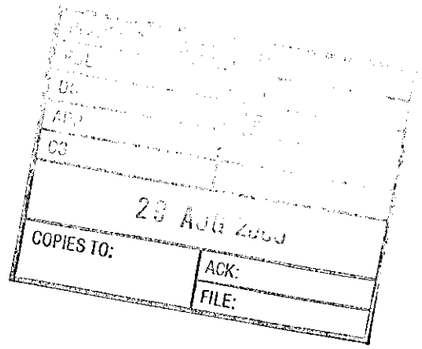

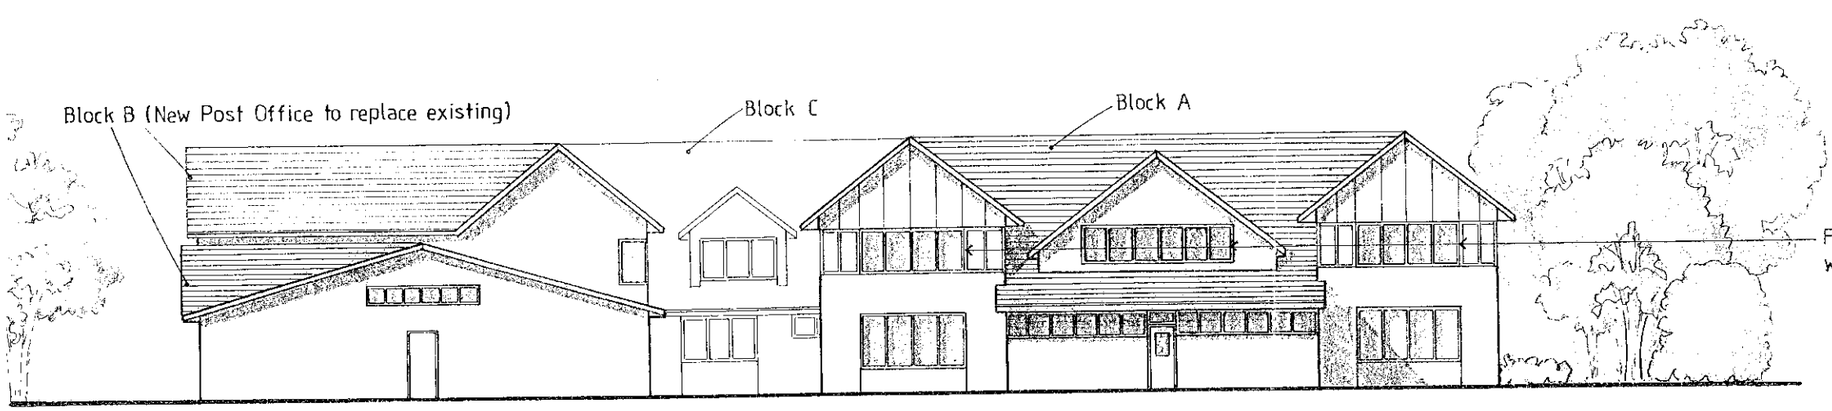

NORTH ELEVATION

APPROVED

E	25/08/00	Drawing Update
D	9/8/00	North Elevation Altered
C	9/5/00	Drawing Update
B	2/5/00	Drawing Update
A	6/4/00	Drawing Update

BLOCK D ELEVATIONS

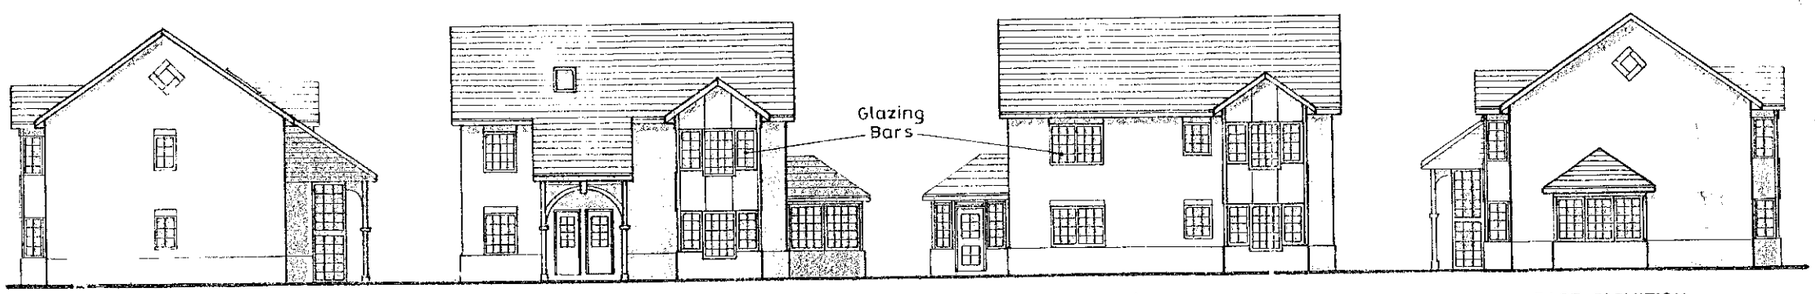

~~WEST~~ ELEVATION
NORTH
SIDE

~~SOUTH~~ ELEVATION
WEST
FRONT

~~NORTH~~ ELEVATION
EAST
REAR

~~EAST~~ ELEVATION
SOUTH
SIDE

Former Riseley Stores
Riseley
Berkshire

Reading Chair & Desk

Elevations

1:200

1477-12^E

March 00 ATSR

D 28/2/01

Block D

PLANNING SERVICES
HPT
TLS
ENF
POL
DC
APP
CS
11 AUG 2000
COPIES TO:

REVISED PLAN

F/2000/1838

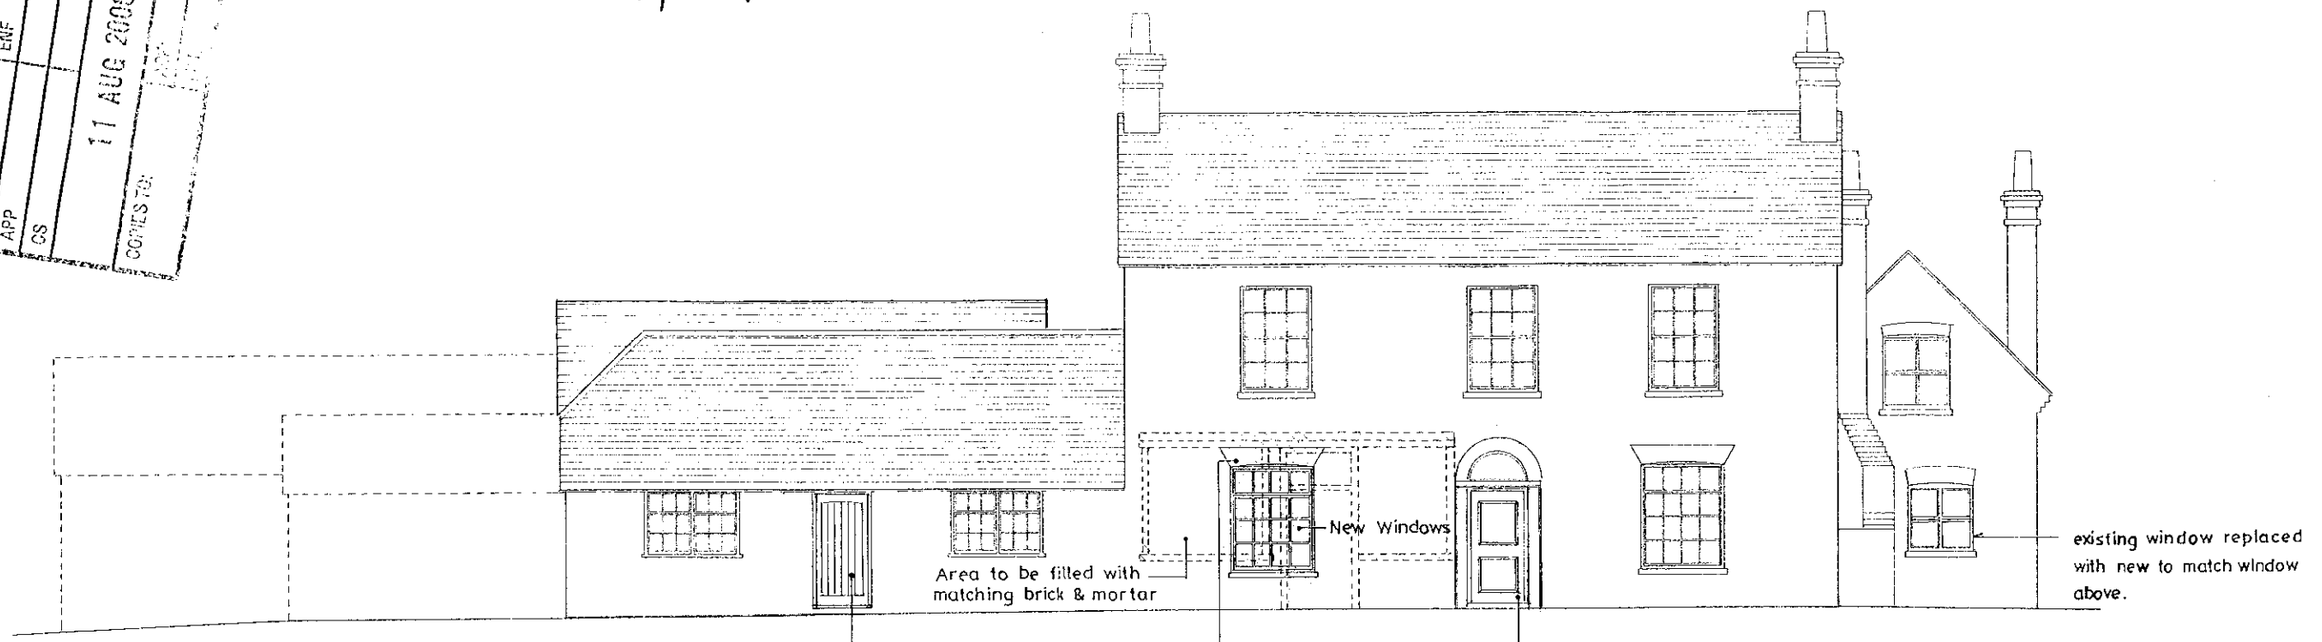

West Elevation

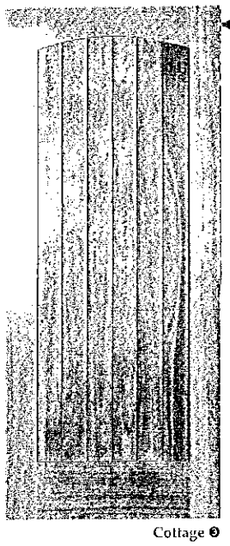

Solid vertical boarded external door by:

LPD Ltd. or similar

Cottage ❸

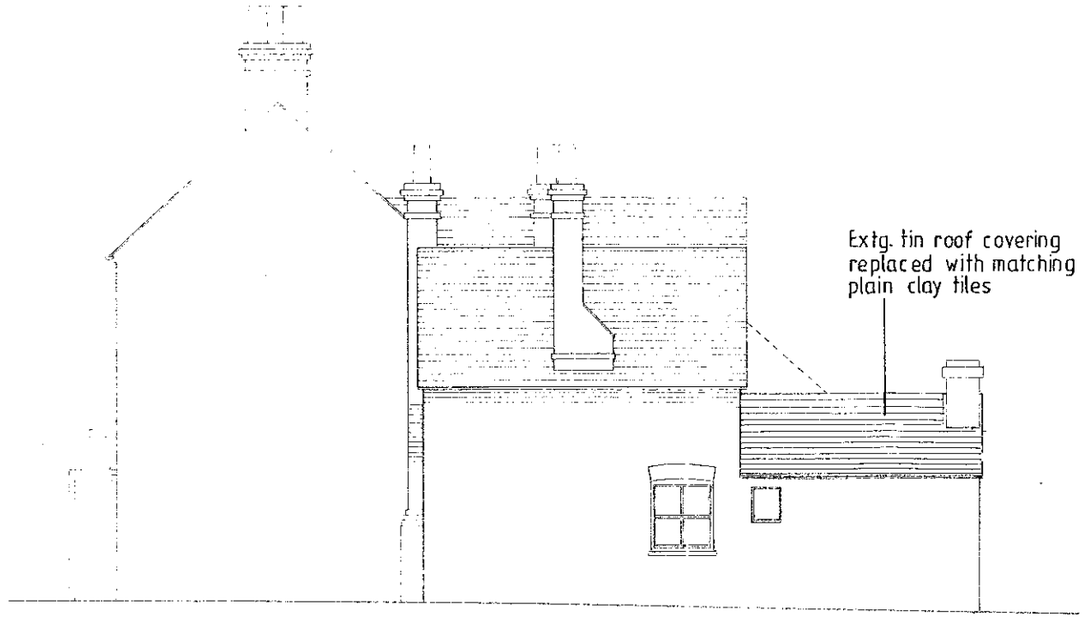

South Elevation

APPROVED

C	08/8/00	Drawing Update
B	29/6/00	Drawing Update
A	Jun 2000	DRAWING UPDATE

Former Riseley Stores
Riseley
Berkshire

Reading Chair and Desk

Proposed Elevations (S & W)
Block "E"

1:100

MAY 00 | AMG

1477/19 C

THE STUDIO, LONDON ROAD, READING, BERKSHIRE
CHARTERED ARCHITECTS
KALIK ASSOCIATES
ANDREWS

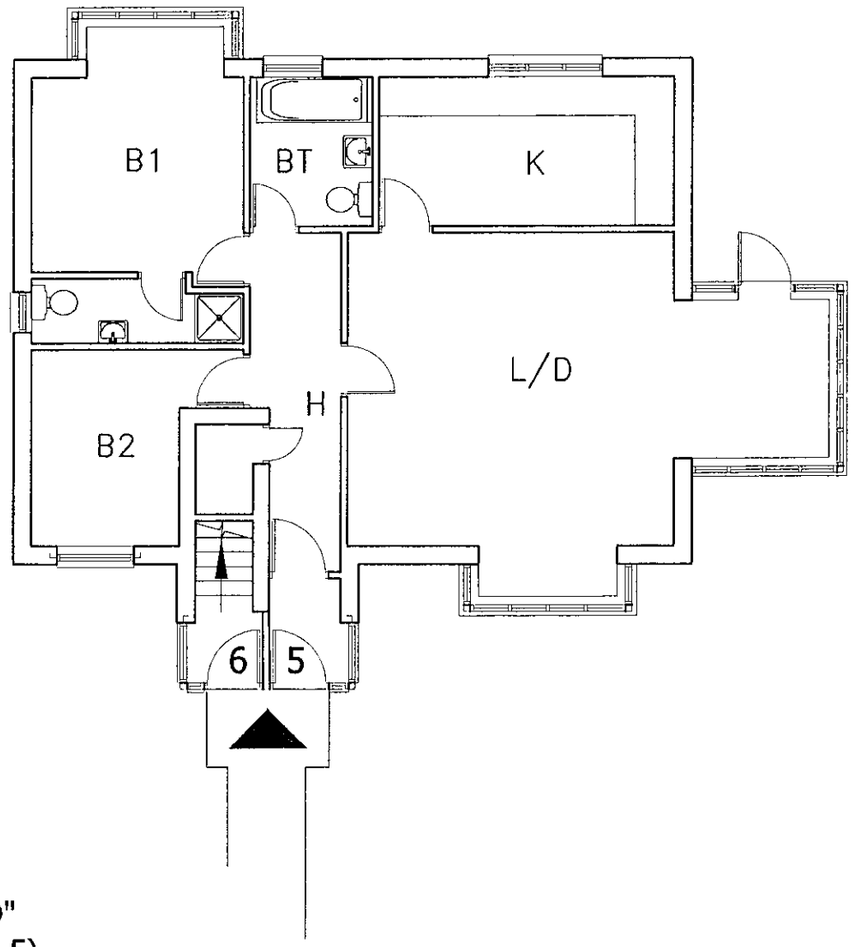

BLOCK "D"
(Flats No. 5)

GROUND FLOOR PLAN

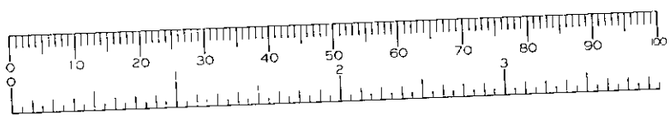

1:100/2000/1838

REVISED PLAN

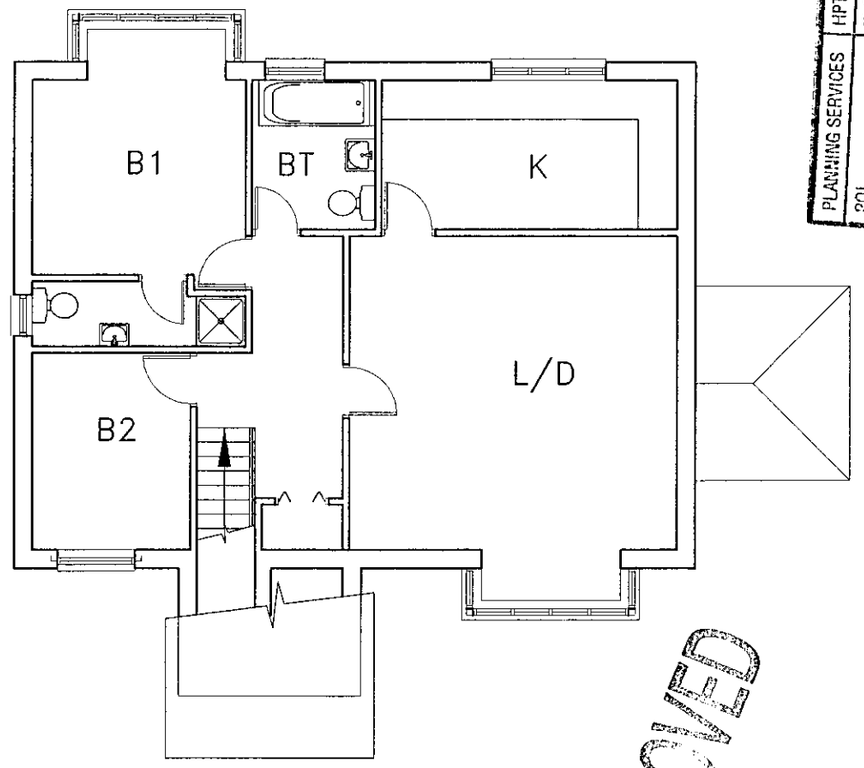

BLOCK "D"
(Flats No. 6)

FIRST FLOOR PLAN

PLANNING SERVICES
HPT
TLS
ENF
POL
DC
APP
CS
11 AUG 2000
COPIES TO:

APPROVED

letter	date	revision
B	09/8/00	BINS STORE REMOVED
A	23/5/00	DRAWING UPDATE

job
FORMER RISELEY STORES
RISELEY
BERKSHIRE

client
READING CHAIR & DESK

drawing
FLOOR PLANS
BLOCK "D"

scale 1:100
date MAY 2000
drawn by A.N.
1477-24B

(0118) 9507100
THE STUDIO
101 LONDON ROAD
READING
BERKSHIRE
CHARTERED ARCHITECTS
ANDREWS KALIK ASSOC.

28/11/01

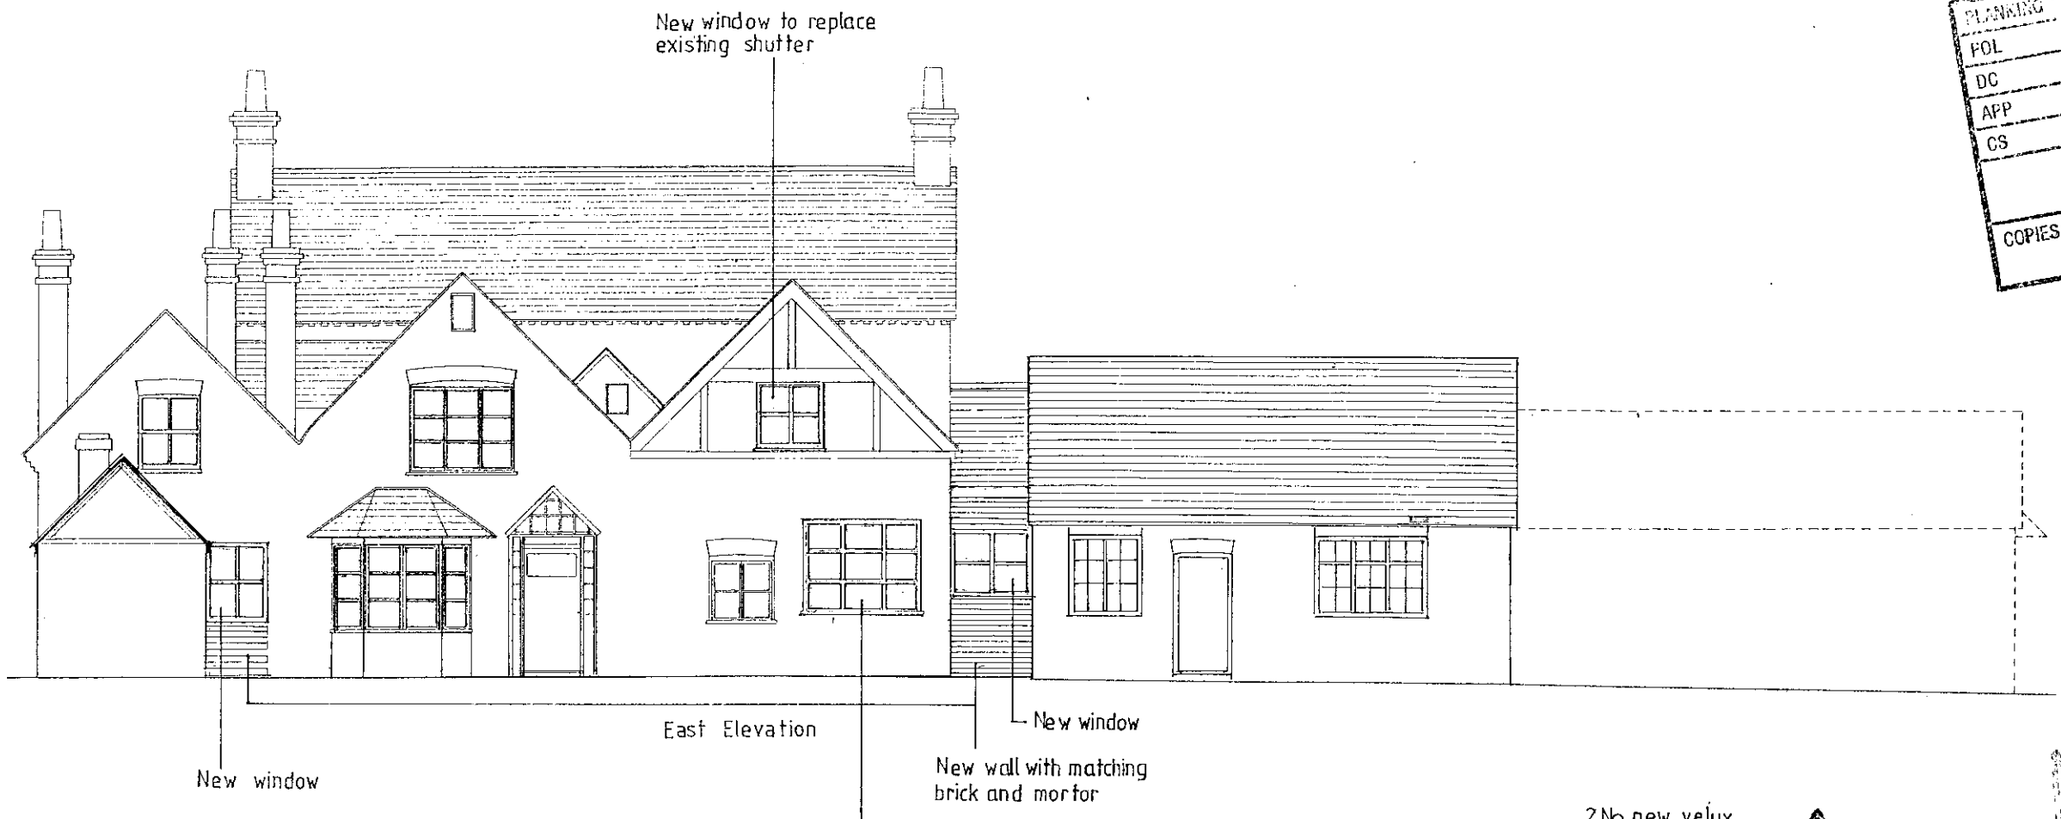

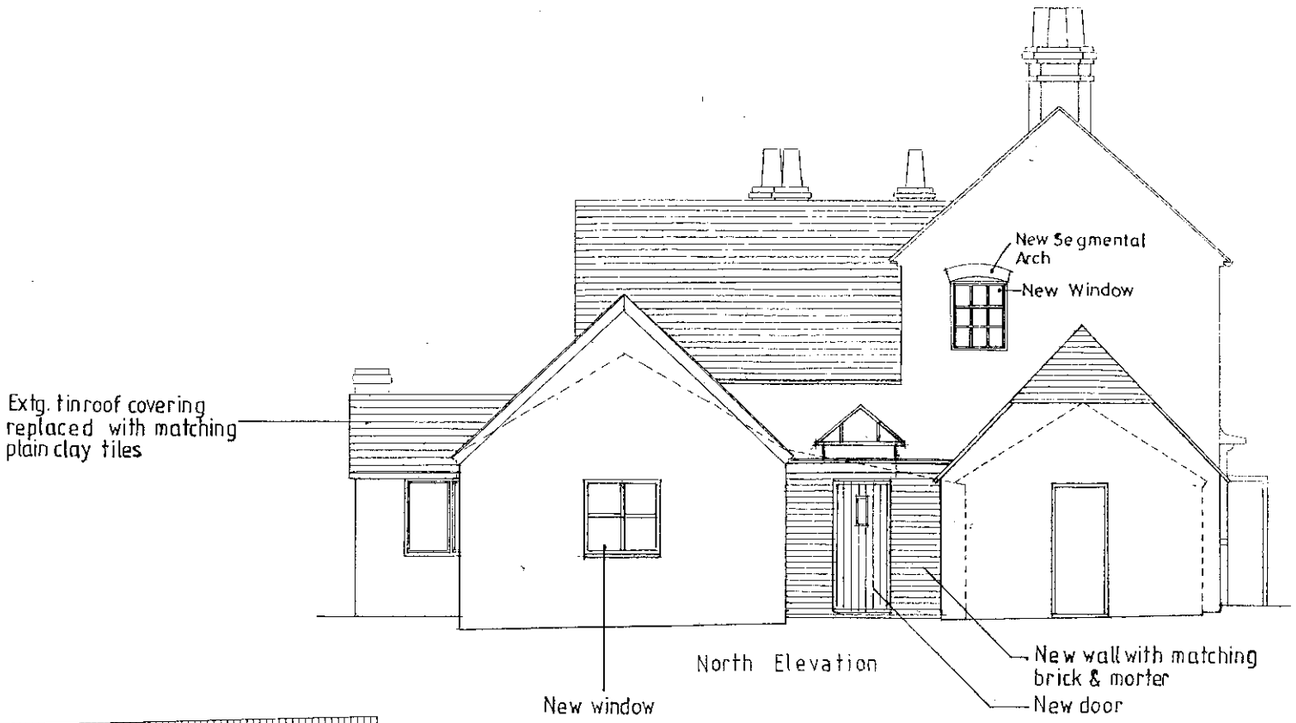

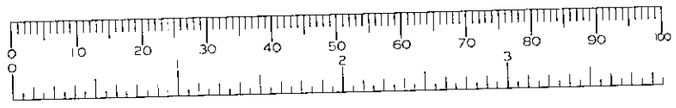

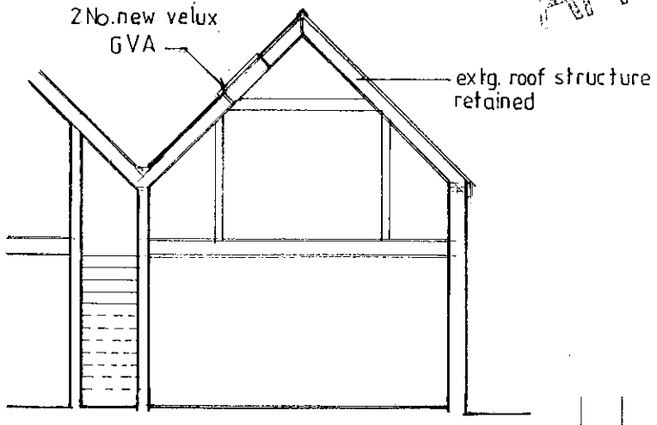

SECTION A-A

C	AUG 2000	DRAWING UPDATE
B	AUG 2000	DRAWING UPDATE
A	JUN 2000	DRAWING UPDATE
letter	date	revision

PLANNING ... | FOL | DC | APP | CS | TL | ENF
29 AUG 2000
COPIES TO: | ACK: | FILE:

1463
1465

REVISED PLAN

APPROVED

Former Riseley Stores
Riseley
Berkshire

Client: Reading Chair and Desk

Drawing: Proposed Elevations (E & N) Block "E"

Scale: 1:100
Date: MAY 00
Drawn by: AMG
1477/ 20B

(01 8) 9507700
THE STUDIO
LONDON ROAD
BERKSHIRE
READING
CHARTERED ARCHITECTS
ANDREWS KALIK ASSOCIATES

NOTES:

RETAIN ALL CHIMNEY BREASTS.

ALL PARTITIONS INCLUDING SECTIONS ABOVE DOORS TO BE BUILT OF TIMBER STUD WORK FACED WITH PLASTERBOARD AND FINISHED WITH SKIM PLASTER.

ALL EXTERNAL MATERIALS TO BE RECLAIMED IF POSSIBLE.

ALL INTERNAL JOINERY TO BE REUSED WHERE POSSIBLE.

ALL ROOF LIGHTS TO BE VELUX "GVA-HERITAGE"457x608 RECOMMENDED FOR CONSEVATION AREAS.

ALL MATERIALS, INTERNALLY AND EXTERNALLY TO BE APPROVED BY MR. SANDERS.

BLOCK "E"

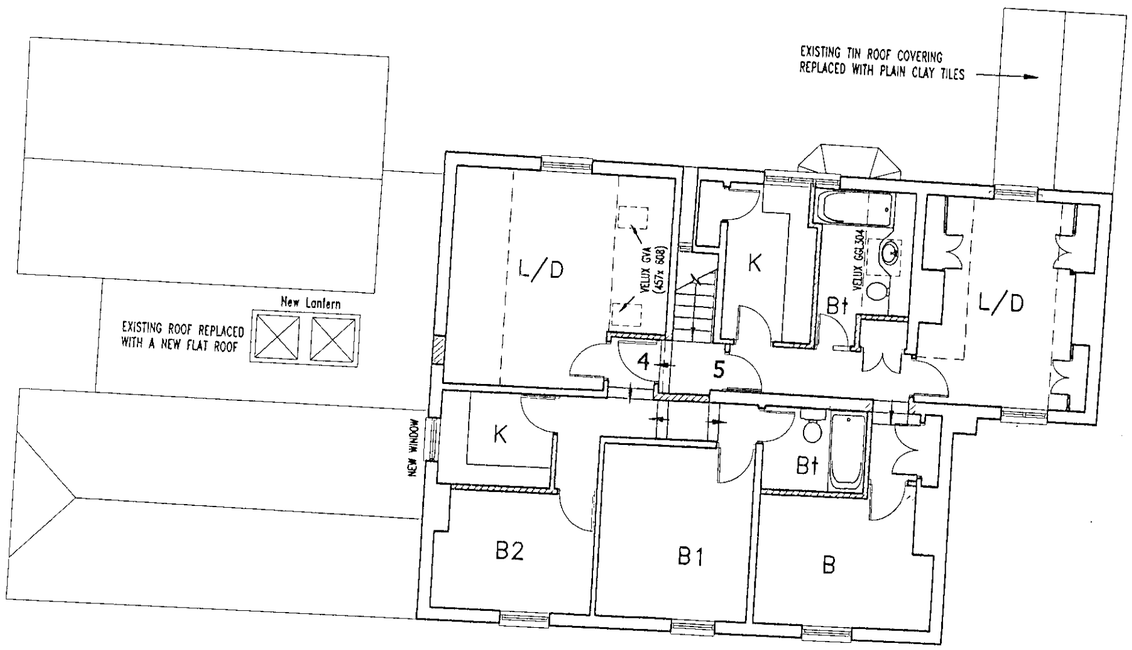

FIRST FLOOR PLAN

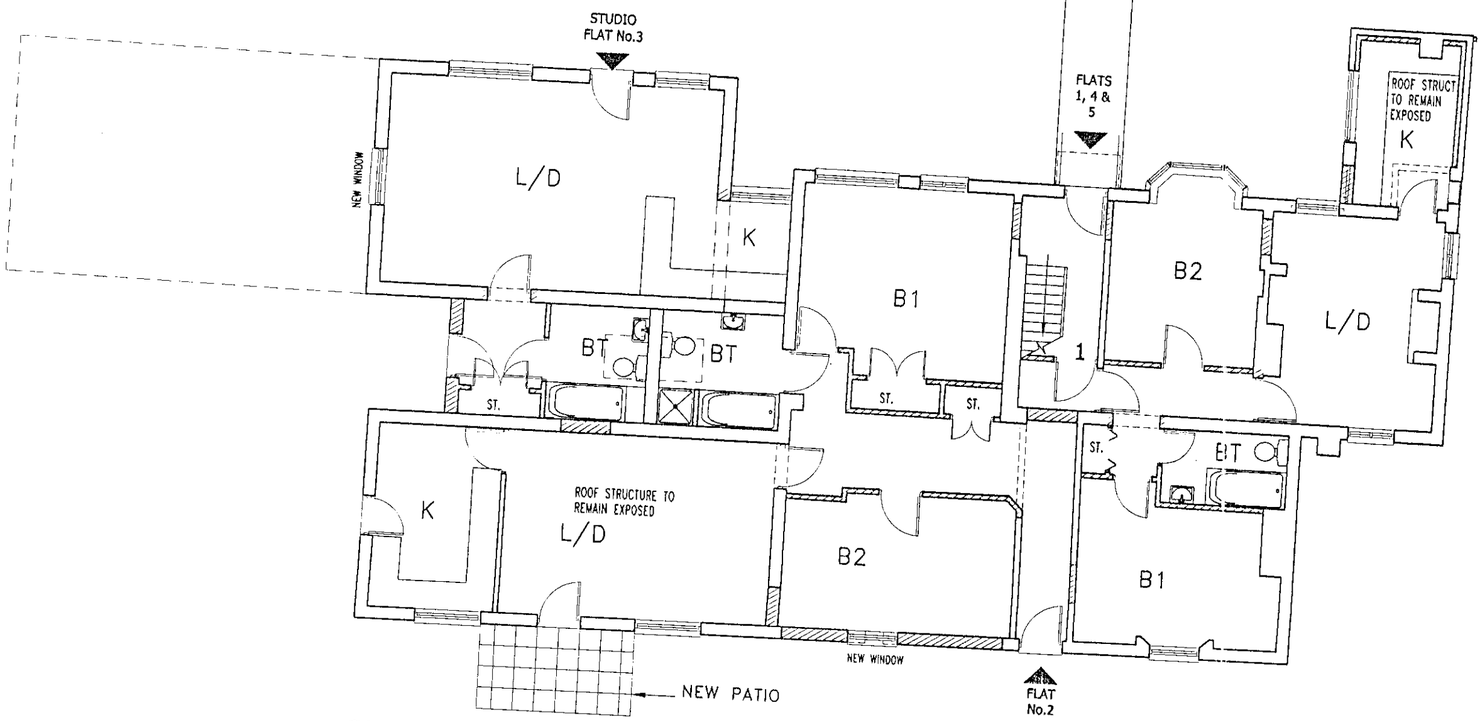

GROUND FLOOR PLAN



APPROVED

REVISED PLAN

1463

1465



letter	date	revision
C	25-08-00	DRAWING UPDATE
B	08-08-00	DRAWING UPDATE
A	29-06-00	DRAWING UPDATE

job FORMER RISELEY STORES
RISELEY
BERKSHIRE

client READING CHAIR & DESK

drawing FLOOR PLANS BLOCK "E"
CONVERSION OF EXISTING TO FLATS

scale 1:100

date JUNE 2000

drawn by A.N.

1477-26C

ANDREWS KALIK ASSOCIATES
CHARTERED ARCHITECTS
READING BERKSHIRE
101 LONDON ROAD
THE STUDIO
(0118) 9507100

Existing Ground
Floor Plan

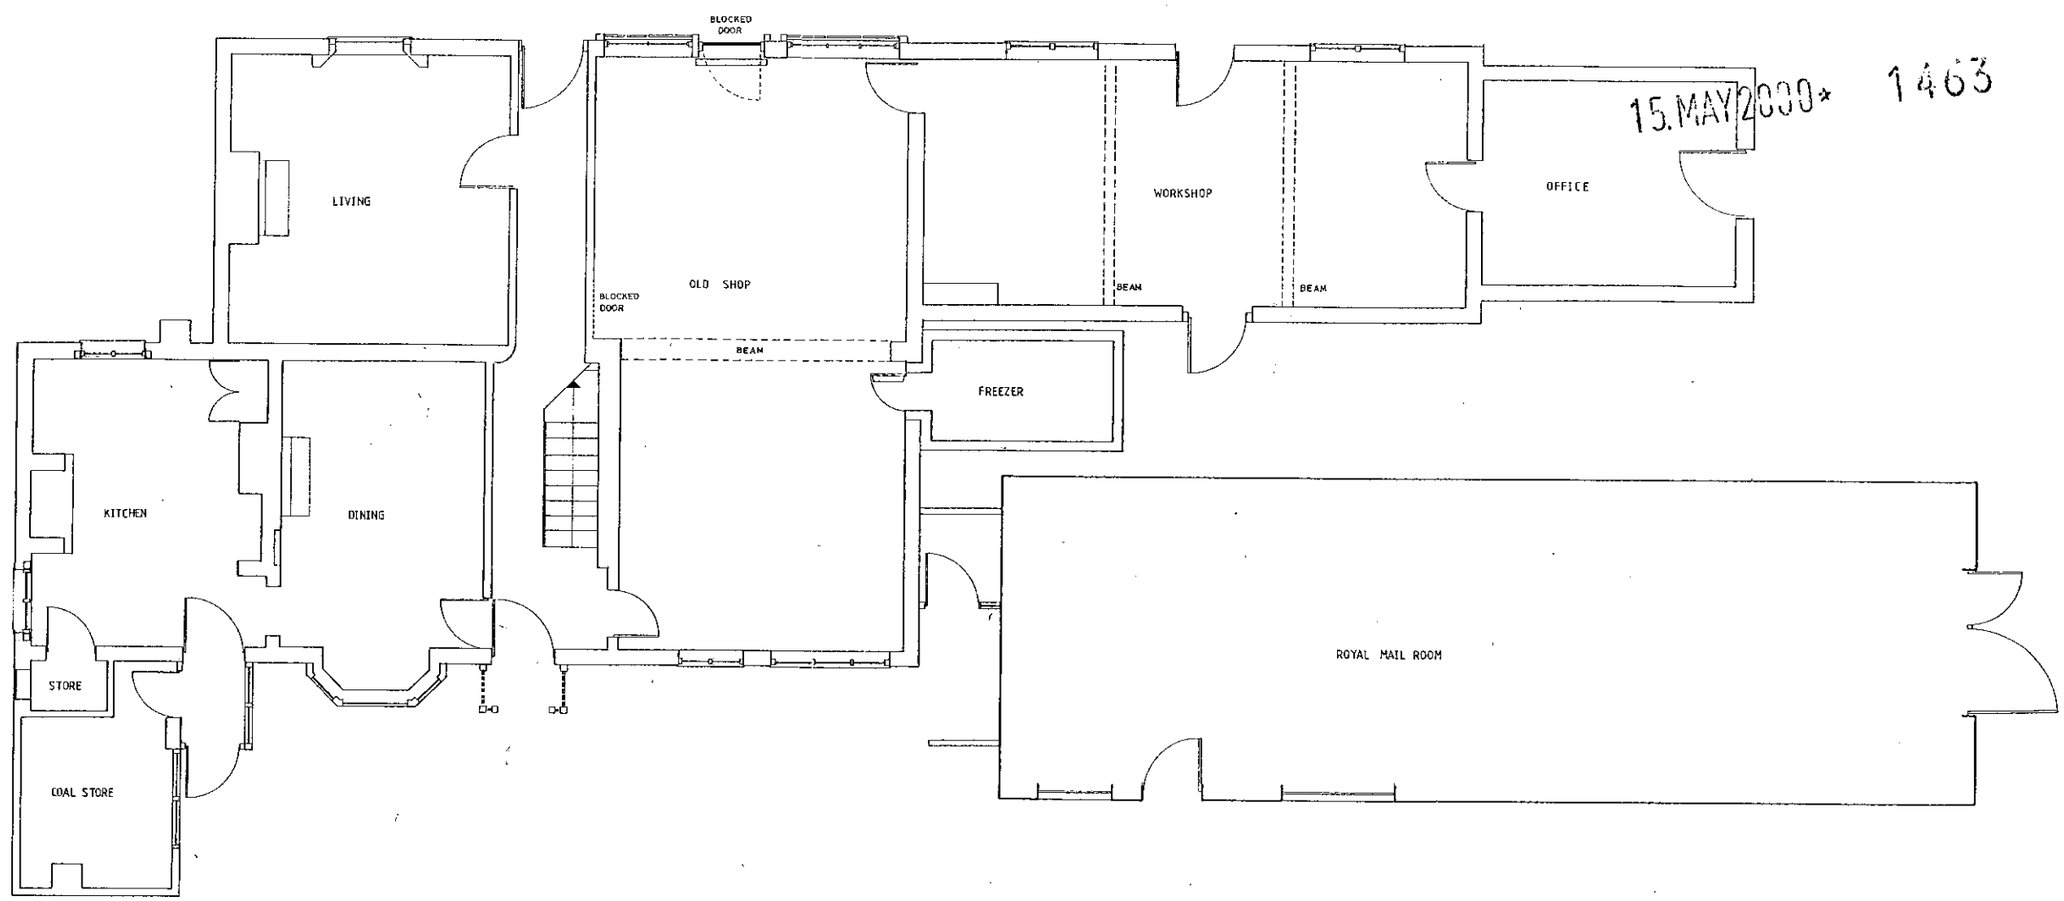

15.MAY2000* 1463

Existing First
Floor Plan

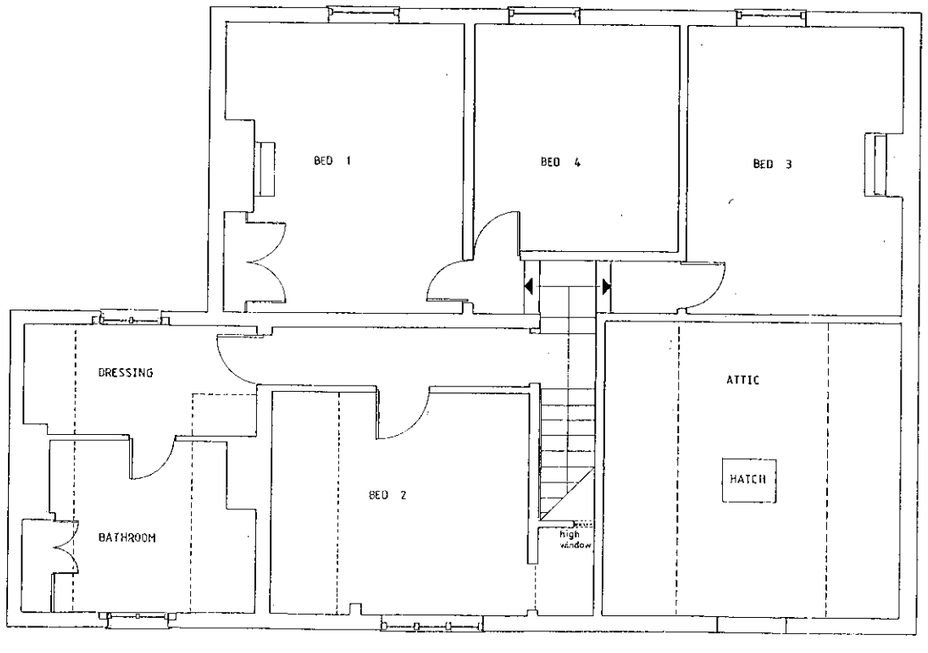

SUPERSEDED

letter	date	revision

0 10 20 30 40 50 60 70 80 90 100
0 2 3

job
FORMER RISELEY STORES
RISELEY
BERKSHIRE

client
READING CHAIR & DESK

drawing
FLOOR PLANS
BLOCK "E"

scale 1:100
date MAY 2000
drawn by A.N.
1477-21

ANDREWS KALIK ASSOCIATES
CHARTERED ARCHITECTS
101 LONDON ROAD READING BERKSHIRE
(0118) 9501700

NOTES:

RETAIN ALL CHIMNEY BREASTS.

ALL PARTITIONS INCLUDING SECTIONS ABOVE DOORS TO BE BUILT OF TIMBER STUD WORK FACED WITH PLASTERBOARD AND FINISHED WITH SKIM PLASTER.

ALL EXTERNAL MATERIALS TO BE RECLAIMED IF POSSIBLE.

ALL INTERNAL JOINERY TO BE REUSED WHERE POSSIBLE.

ALL ROOF LIGHTS TO BE VELUX "GVA-HERITAGE"457x608 RECOMMENDED FOR CONSEVATION AREAS.

ALL MATERIALS, INTERNALLY AND EXTERNALLY TO BE APPROVED BY MR. SANDERS.

BLOCK "E"

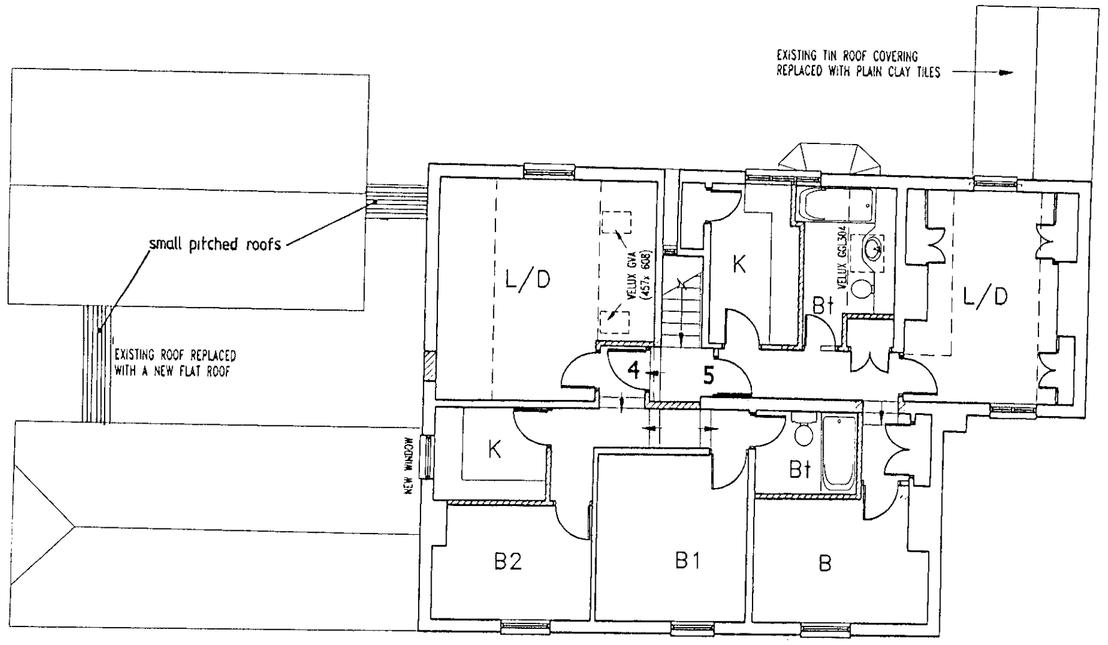

FIRST FLOOR PLAN

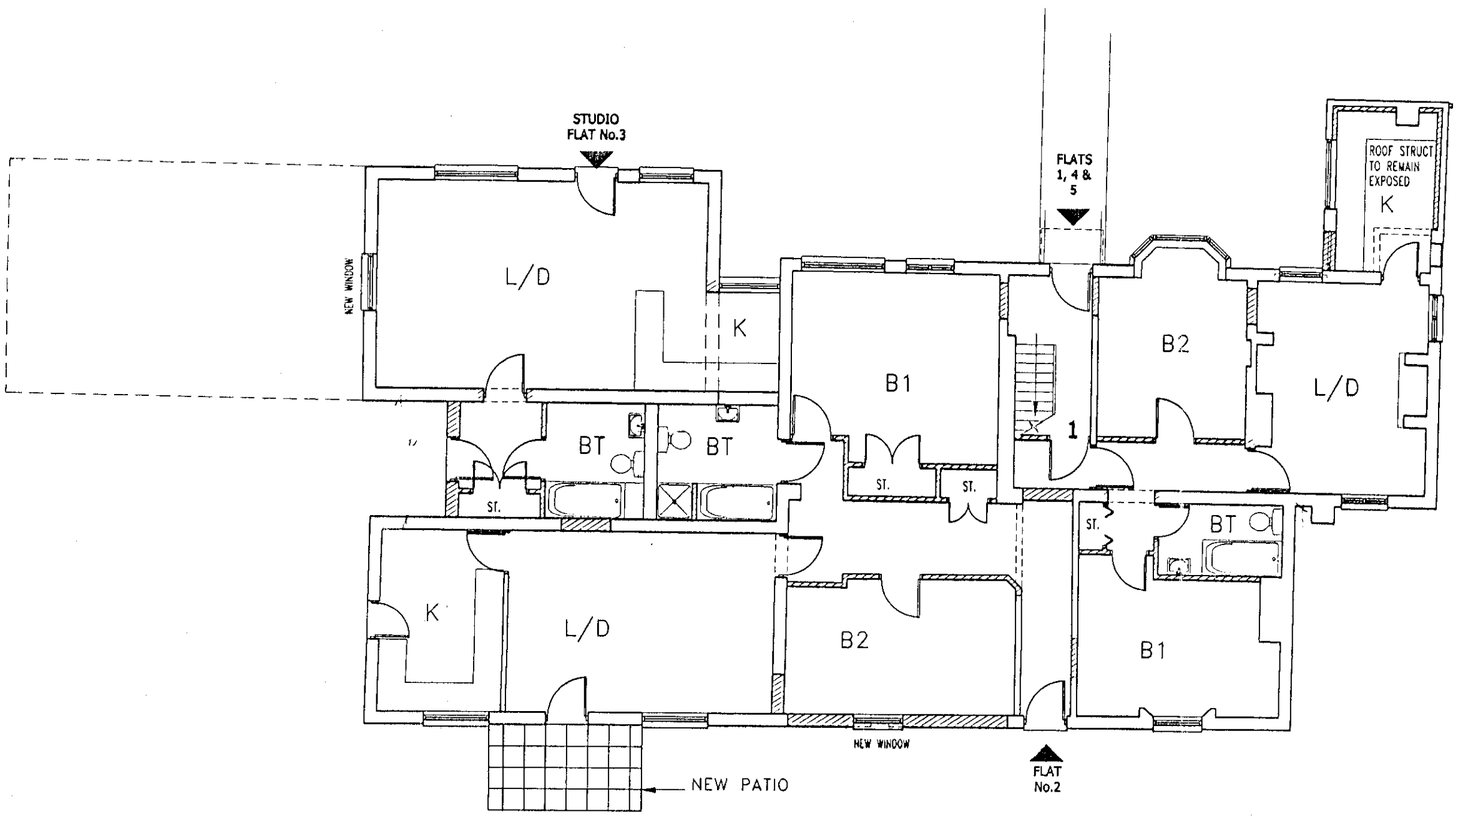

GROUND FLOOR PLAN

letter	date	revision
D	Aug'01	Roof Lights omitted.
C	25-08-00	DRAWING UPDATE
B	08-08-00	DRAWING UPDATE
A	29-06-00	DRAWING UPDATE

job FORMER RISELEY STORES
RISELEY
BERKSHIRE

client READING CHAIR & DESK

drawing FLOOR PLANS BLOCK "E"
CONVERSION OF EXISTING TO FLATS

scale 1:100
date JUNE 2000
drawn by A.N.
1477-26D

(0118) 9501100
THE STUDIO
101 LONDON ROAD
READING BERKSHIRE
CHARTERED ARCHITECTS
ANDREWS KALIK ASSOCIATES

DRAWING SERVICES	HPT
	TLS
	ENF
APP	
CS	
21 AUG 2001	
COPIES TO:	ACK:
	FILE:

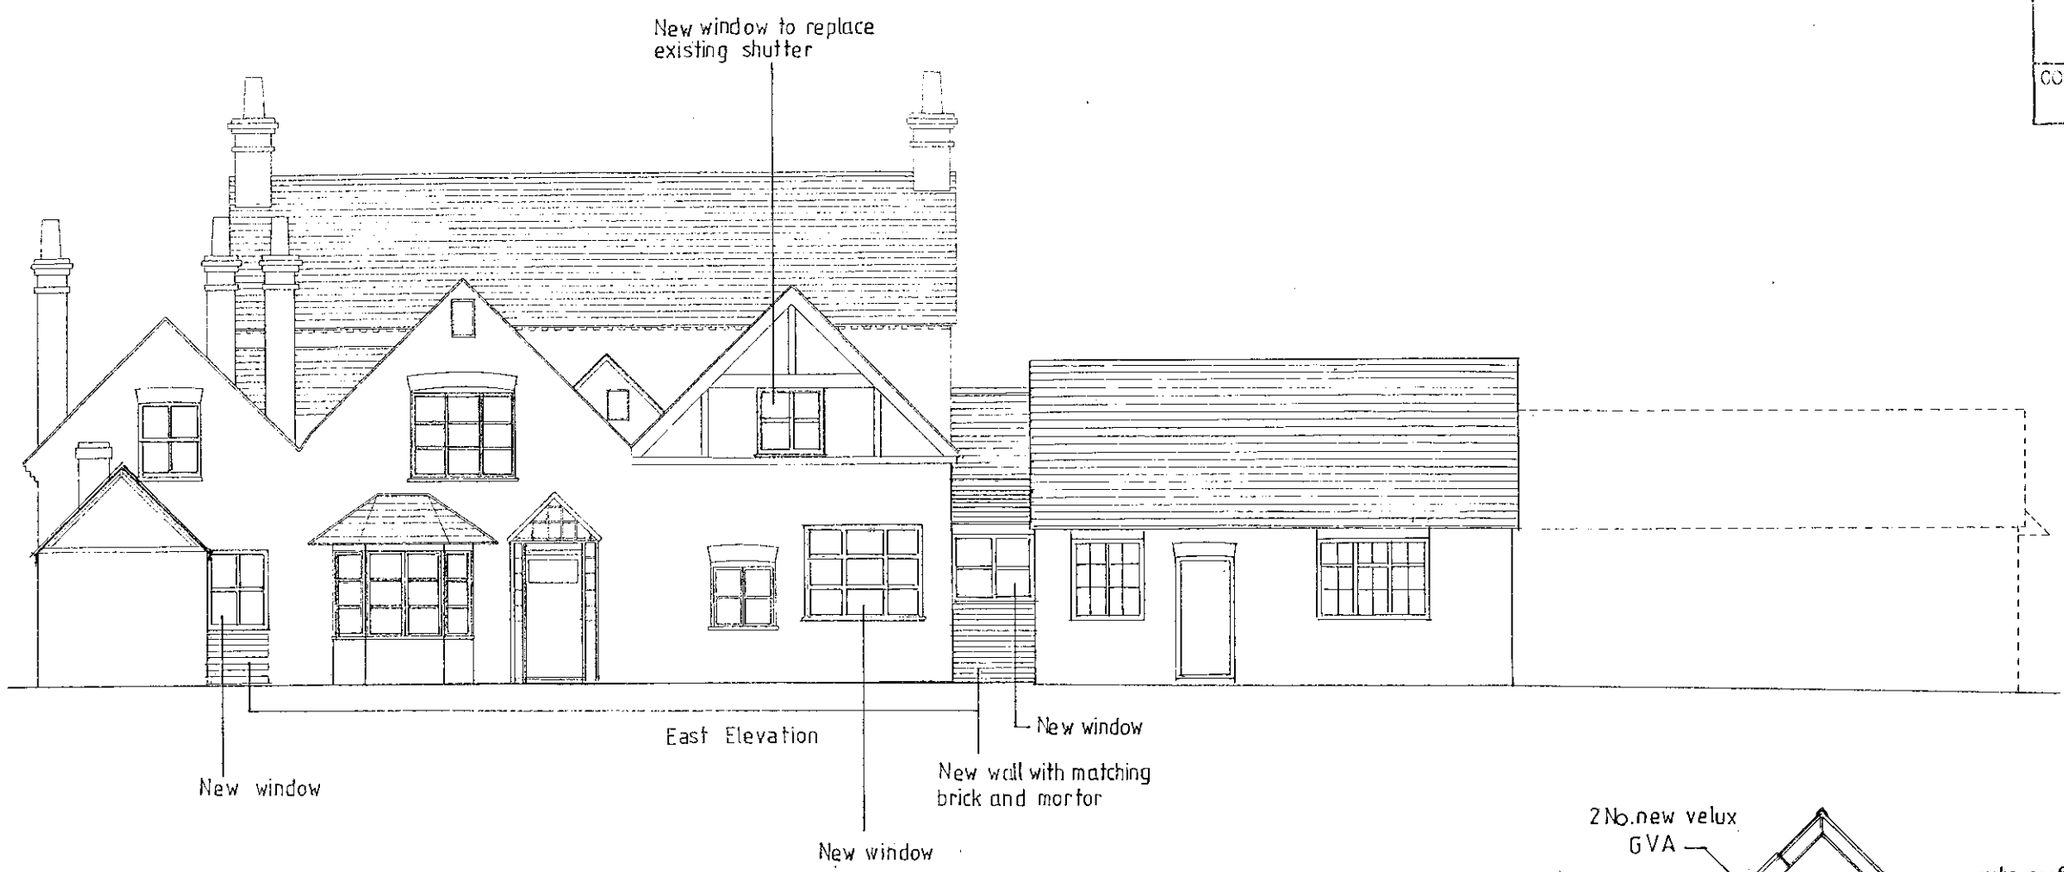

East Elevation

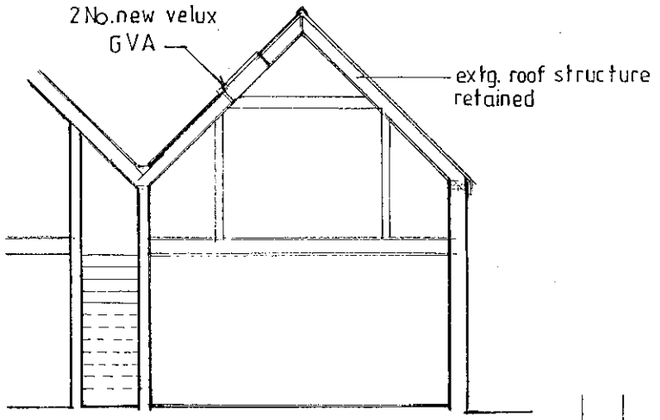

SECTION A-A

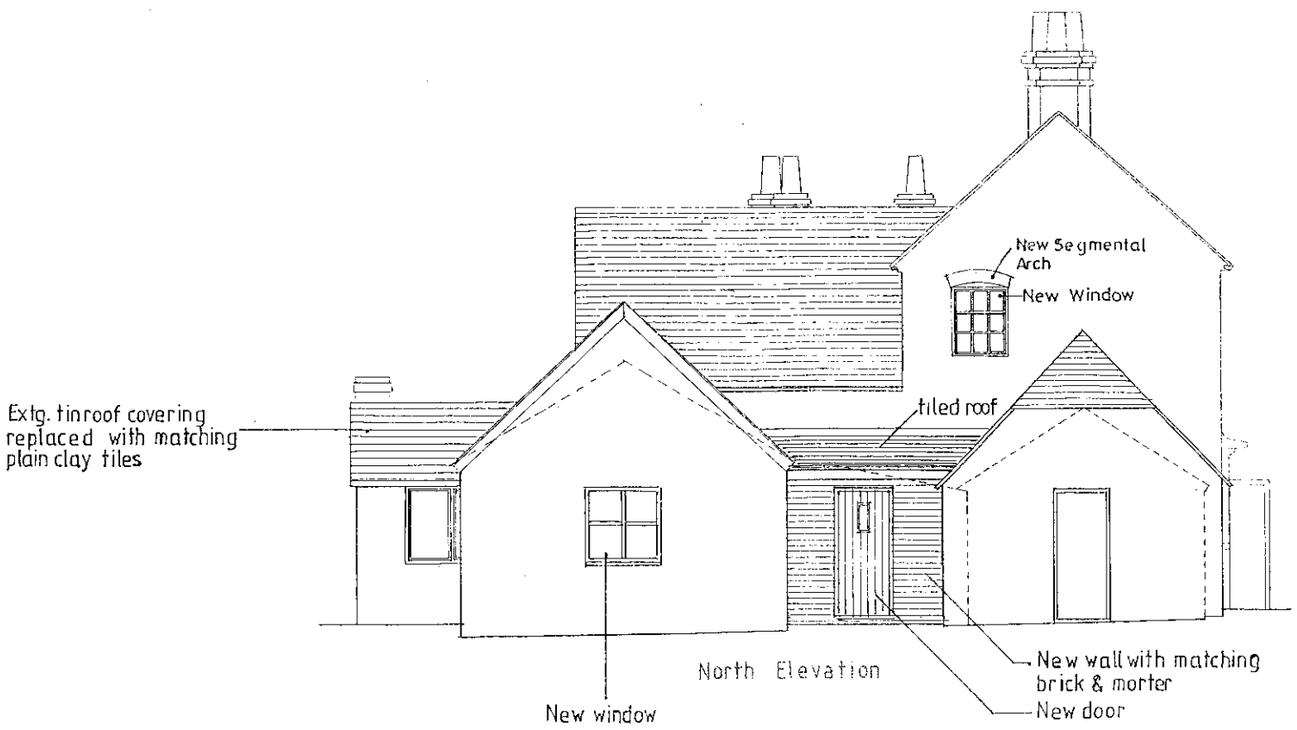

North Elevation

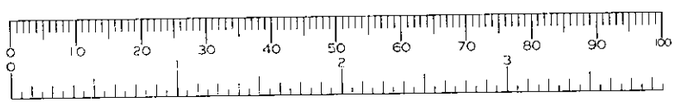

D	Aug '01	TILED ROOF BETWEEN 2-3.
C	AUG 2000	DRAWING UPDATE
B	AUG 2000	DRAWING UPDATE
A	JUN 2000	DRAWING UPDATE

Former Riseley Stores
Riseley
Berkshire

Reading Chair and Desk

Proposed Elevations (E & N)
Block "E"

1:100

MAY 00 | AMG

1477/ 20D

THE STUDIO LONDON ROAD BERKSHIRE
READING
CHARTERED ARCHITECTS
ANDREWS KALIK ASSOCIATES

15.MAY2000* 1463



East Elevation

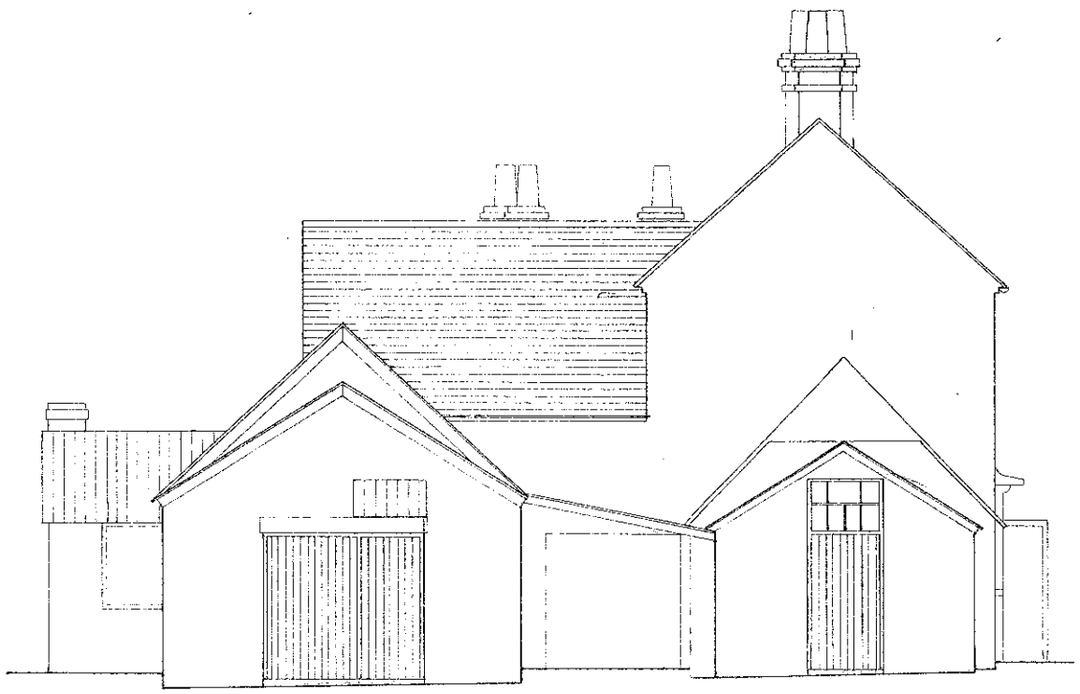

North Elevation

0 10 20 30 40 50 60 70 80 90 100
0 2 3

job Former Riseley Stores
Riseley
Berkshire

client Reading Chair and Desk

drawing Existing Elevations (E and N)

scale 1:100

date MAY00 drawn by AMG

1477/ 22

letter	date	revision

THE STUDIO LONDON ROAD BERKSHIRE
(0118) 9501100
101 READING
CHARTERED ARCHITECTS
ANDREWS KALIK ASSOCIATES

15.MAY2000* 1463



West Elevation

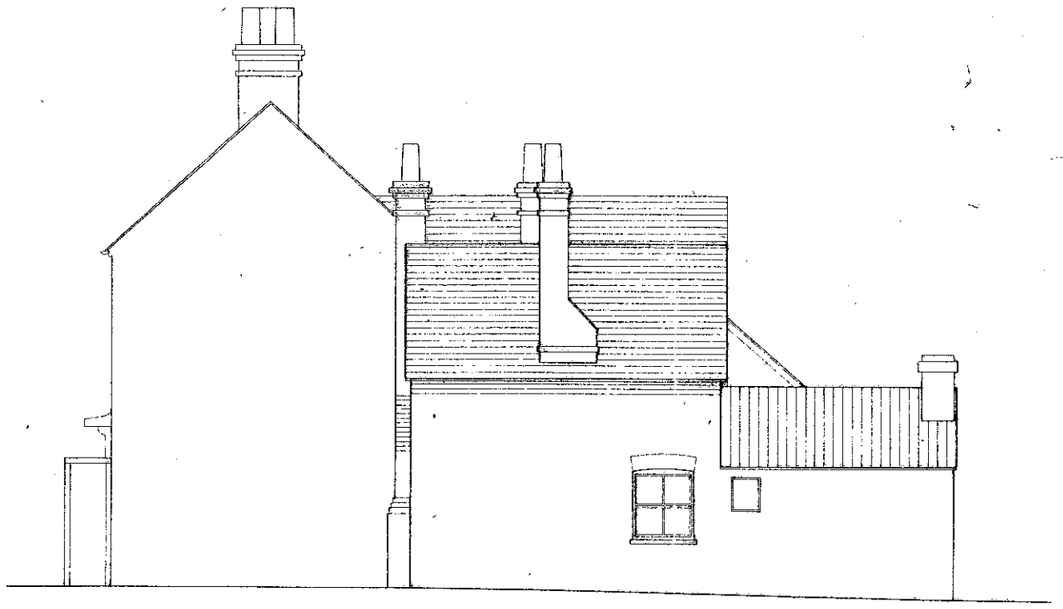

South Elevation

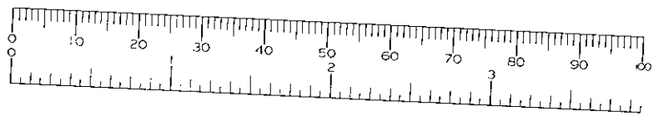

letter date revision

job Former Riseley Stores
Riseley
Berkshire

client Reading Chair and Desk

drawing Existing Elevations (S and W)

scale 1: 100

date MAY 00 | drawn by AMG

1477/23

(0118) 9507100
THE STUDIO
101 LONDON ROAD
READING BERKSHIRE
CHARTERED ARCHITECTS
ANDREWS KALIK ASSOCIATES

Existing Ground
Floor Plan

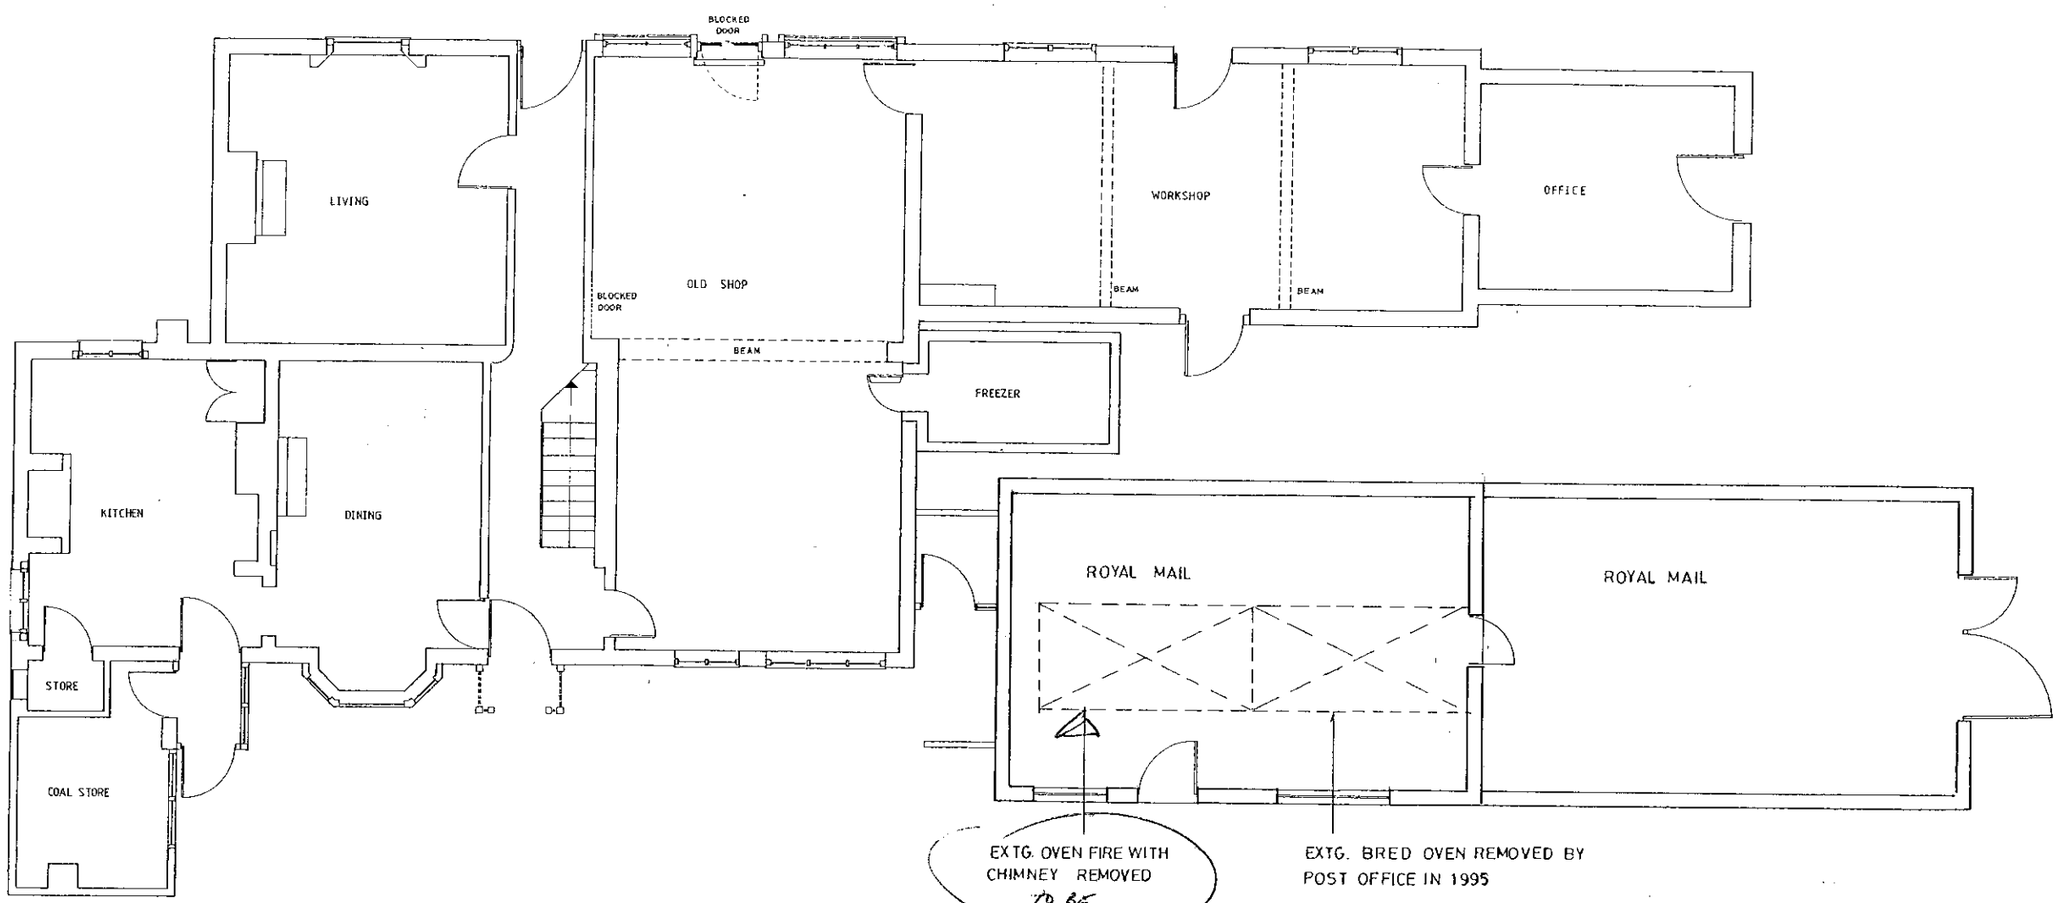

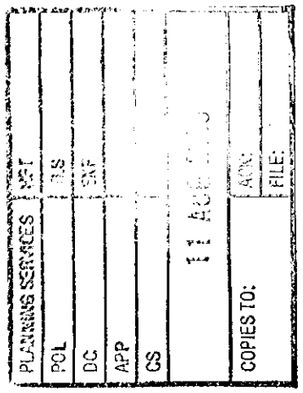

Existing First
Floor Plan

REVISED PLAN
F/1000/1838

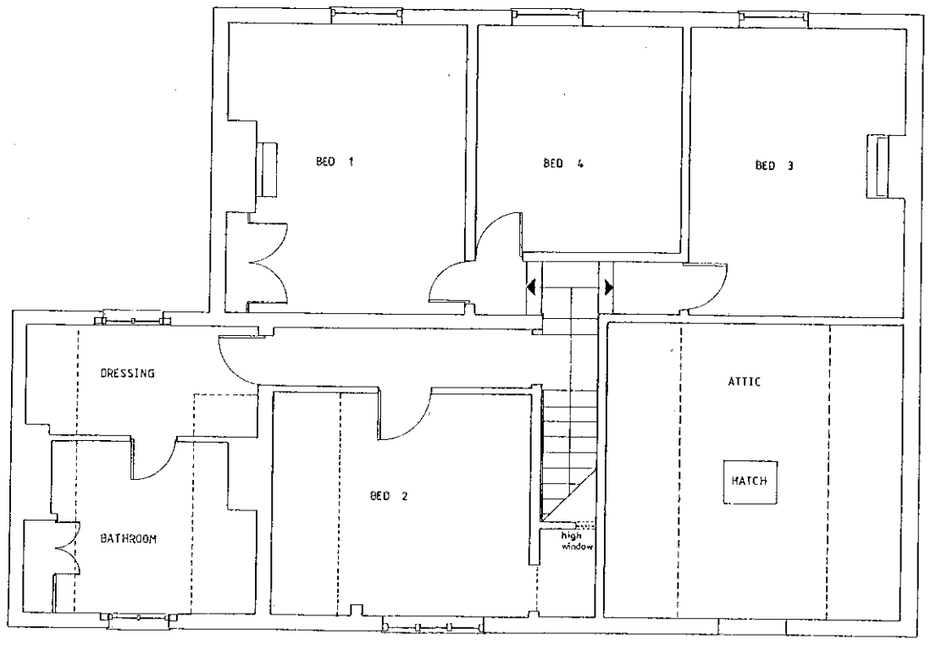

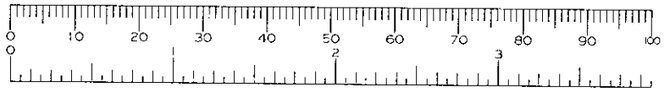

letter	date	revision
A	09.08.00	DRAWING UPDATE

job
FORMER RISELEY STORES
RISELEY
BERKSHIRE

client
READING CHAIR & DESK

drawing
FLOOR PLANS
BLOCK "E"

scale 1:100
date MAY 2000
drawn by A.N.

1477-21A

KALIK ANDREWS CHARTERED ASSOCIATES
ARCHITECTS
101 LONDON ROAD READING BERKSHIRE
THE STUDIO
(0118) 9507700

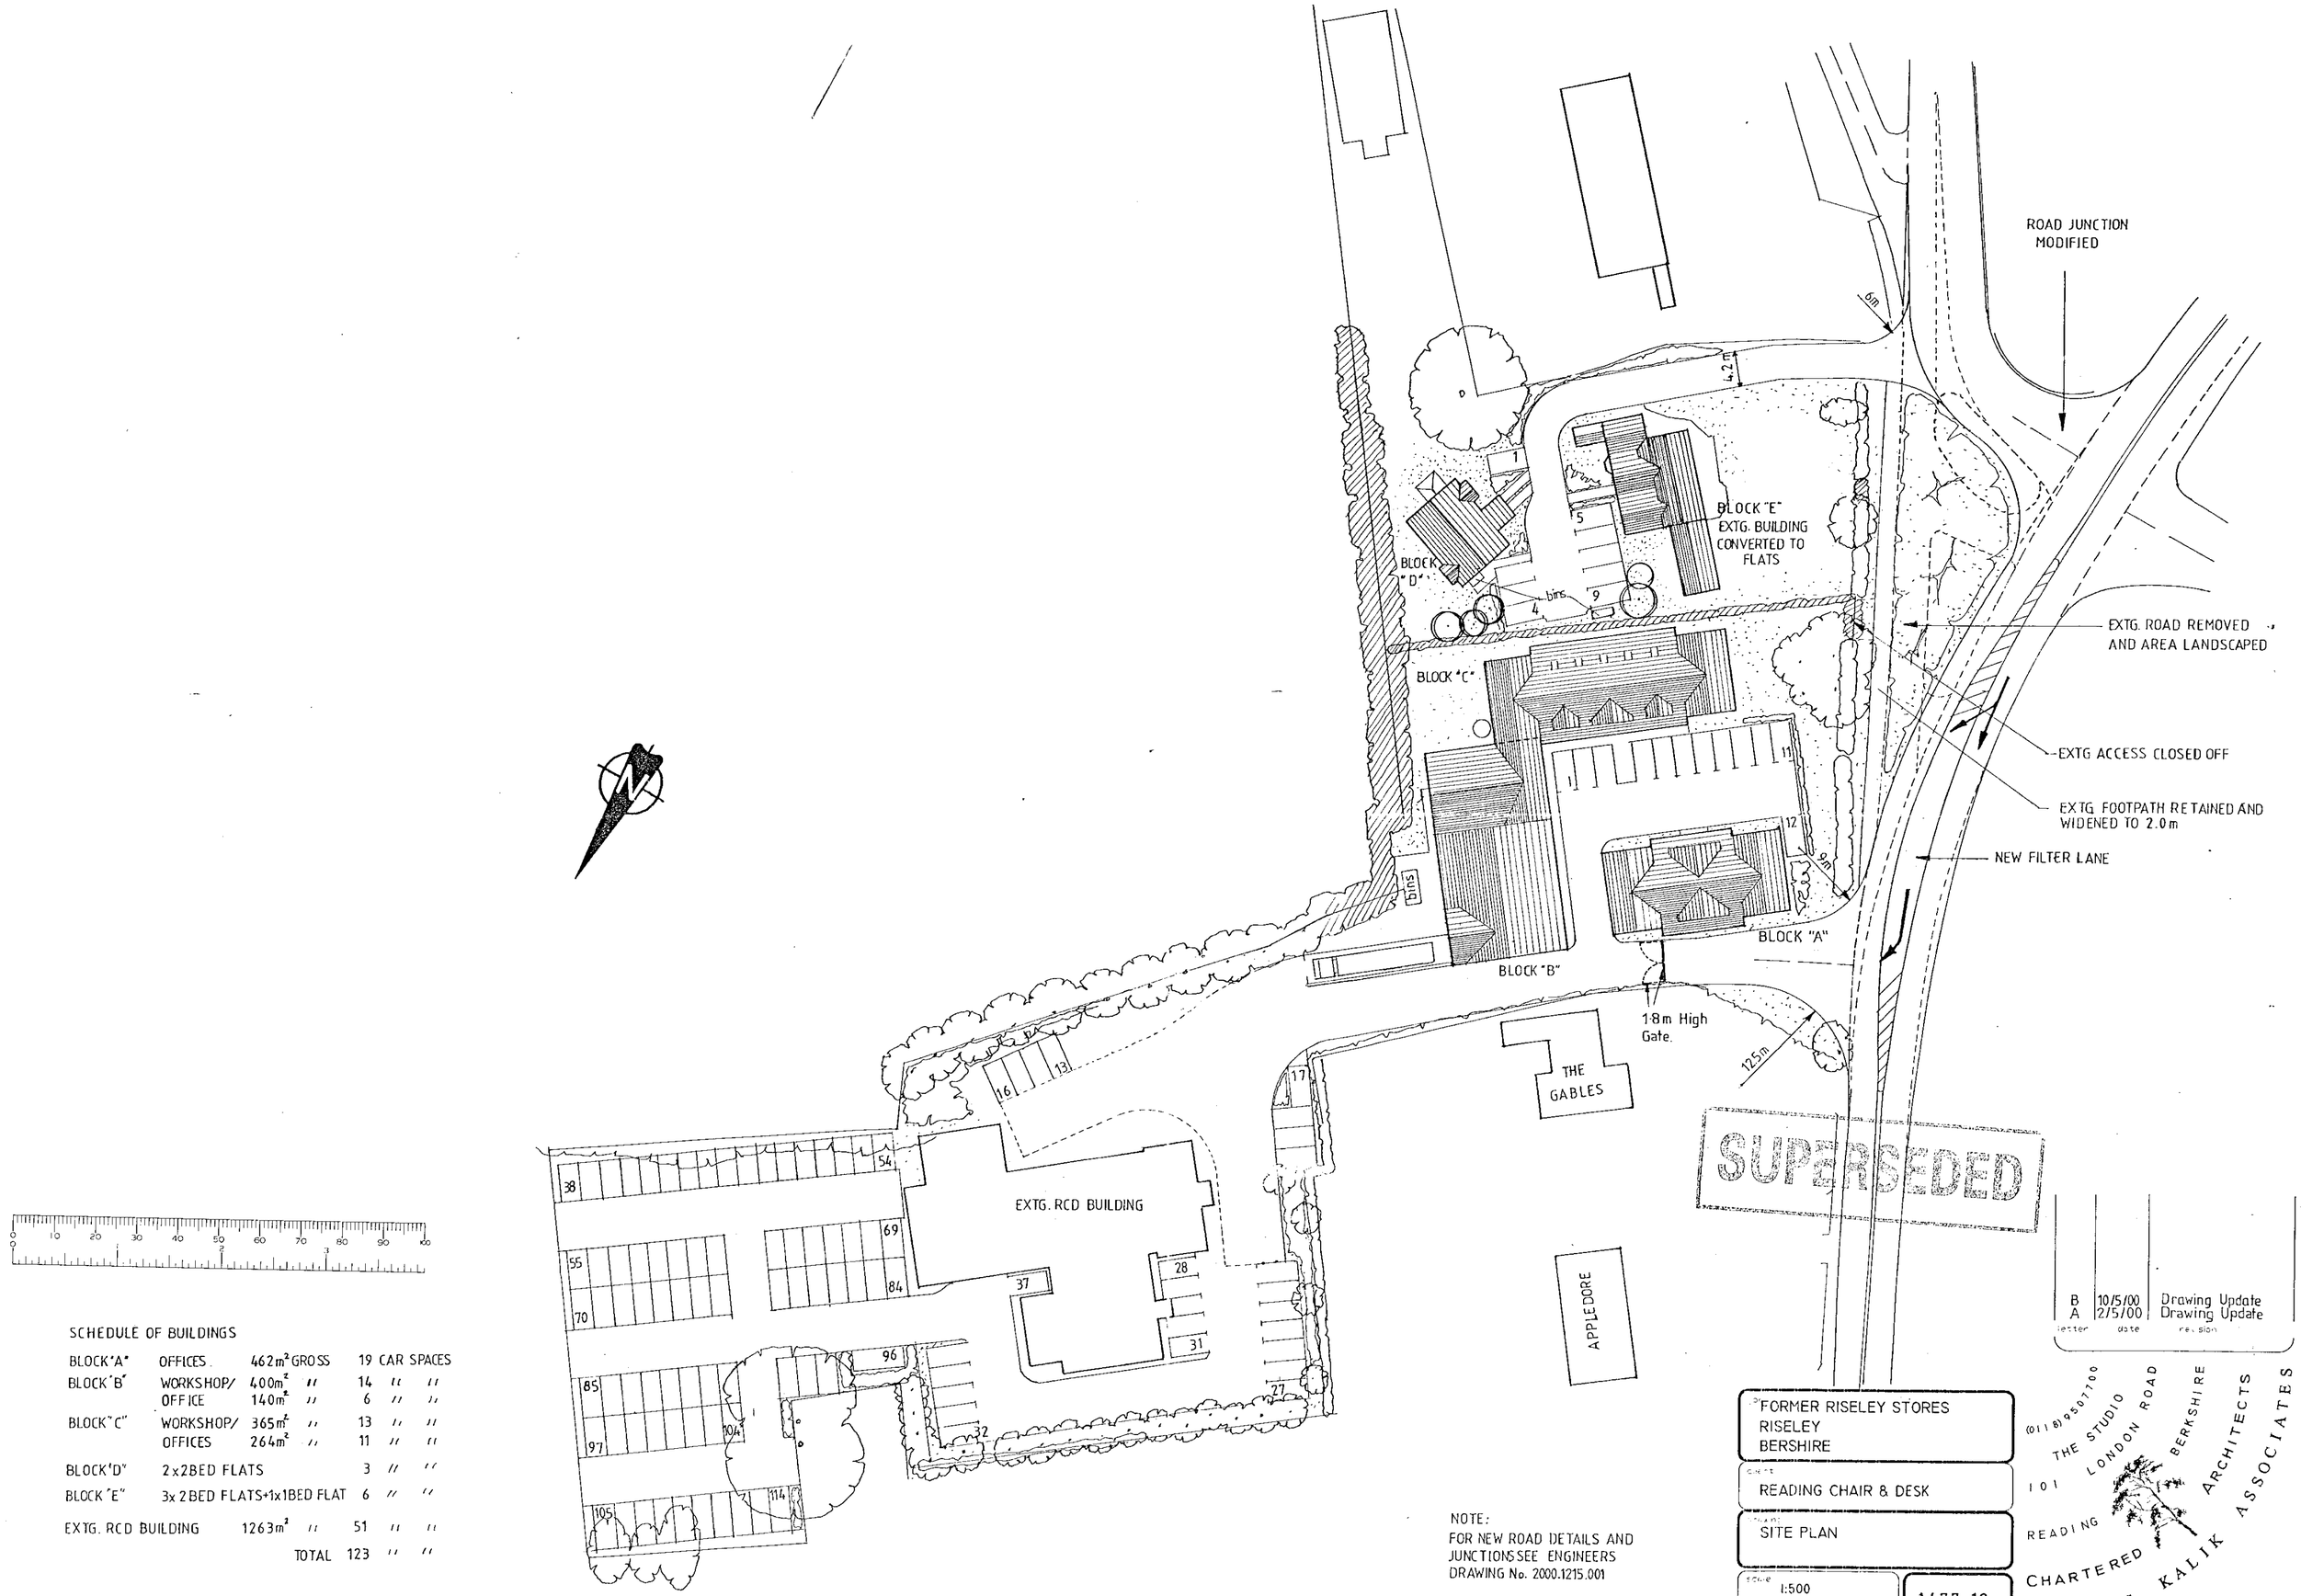
ROAD JUNCTION MODIFIED
6m
4.2m
BLOCK "E" EXTG. BUILDING CONVERTED TO FLATS
BLOCK "D"
bins
BLOCK "C"
EXTG. ROAD REMOVED AND AREA LANDSCAPED
EXTG ACCESS CLOSED OFF
EXTG. FOOTPATH RETAINED AND WIDENED TO 2.0m
NEW FILTER LANE
9m
BLOCK "A"
BLOCK "B"
1.8m High Gate.
12.5m
THE GABLES
EXTG. RCD BUILDING
APPLEDORE
SUPERSEDED
0 10 20 30 40 50 60 70 80 90 100
SCHEDULE OF BUILDINGS
BLOCK 'A' OFFICES 462m² GROSS 19 CAR SPACES
BLOCK 'B' WORKSHOP/ 400m² " 14 " "
OFFICE 140m² " 6 " "
BLOCK "C" WORKSHOP/ 365m² " 13 " "
OFFICES 264m² " 11 " "
BLOCK 'D' 2x2BED FLATS 3 " "
BLOCK 'E' 3x2BED FLATS+1x1BED FLAT 6 " "
EXTG. RCD BUILDING 1263m² " 51 " "
TOTAL 123 " "
NOTE:
FOR NEW ROAD DETAILS AND JUNCTIONS SEE ENGINEERS DRAWING No. 2000.1215.001
B 10/5/00 Drawing Update
A 2/5/00 Drawing Update
letter date revision
FORMER RISELEY STORES
RISELEY
BERSHIRE
client
READING CHAIR & DESK
drawing
SITE PLAN
scale 1:500
date APRIL 2000
drawn by A.N
1477-16B
KALIK ASSOCIATES CHARTERED ARCHITECTS
THE STUDIO 101 LONDON ROAD READING BERKSHIRE
(0118) 9507700
ANDREWS