Do not scale from this drawing.
Refer any discrepancies immediately to the designer.
This drawing is copyright

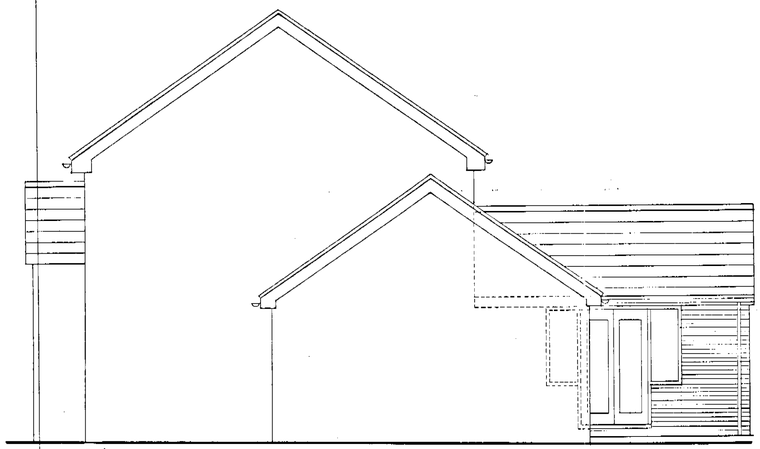

~~REAR~~ Side ELEVATION



~~SIDE~~ Rear ELEVATION

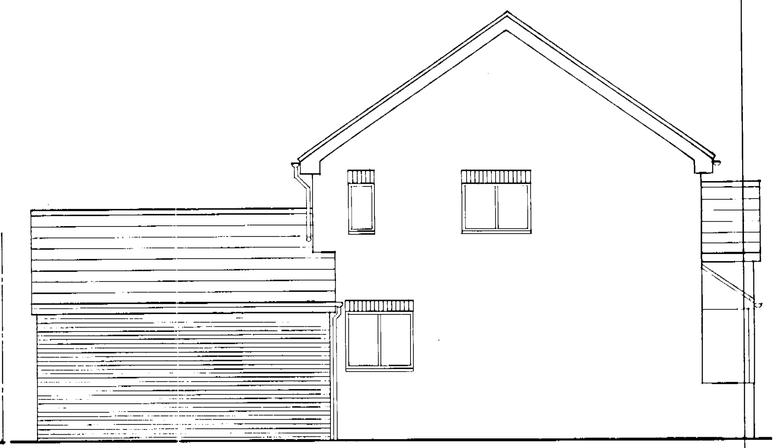

SIDE ELEVATION



FRONT ELEVATION

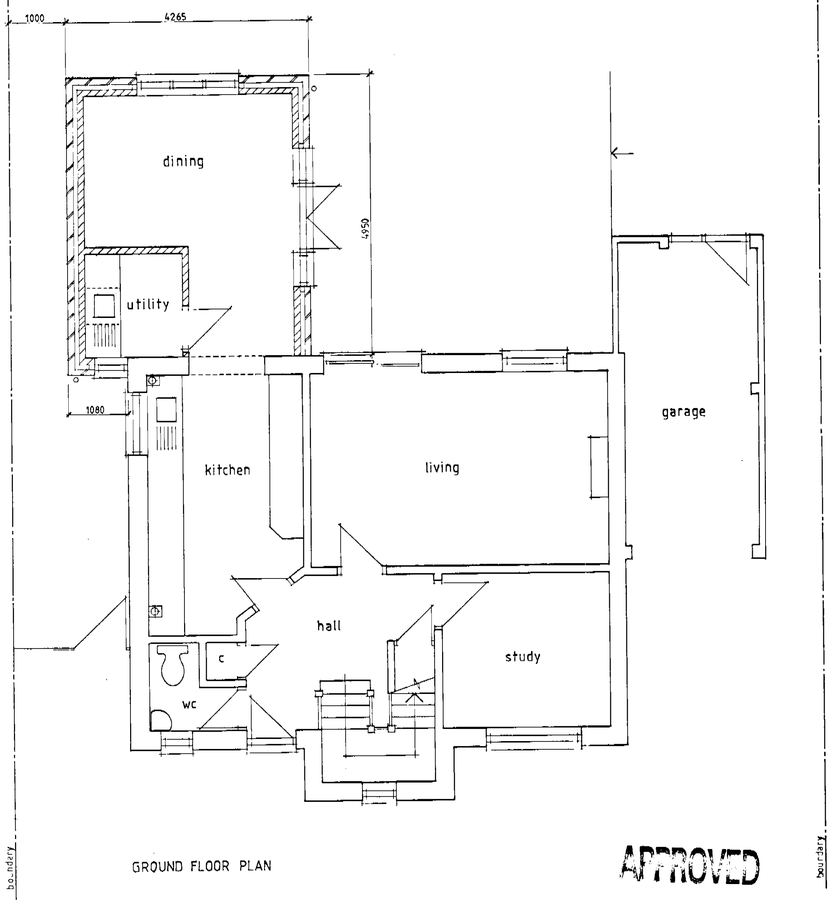

GROUND FLOOR PLAN

APPROVED

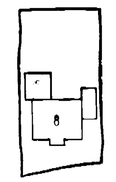

SITE LAYOUT 1:500

27 MAR 2002* 6244

Client
Mr + Mrs Schippers

Project
8 Sibley Park Road
Earley
Reading
Berkshire

Drawing Title
Proposed single storey rear extension

Scale 1:50 1:500 | Drawn | Date MAR 02

Drawing No 162 / 02

17/6/02

Draftline D165

Do not scale from this drawing.
Refer any discrepancies immediately to the designer.
This drawing is copyright

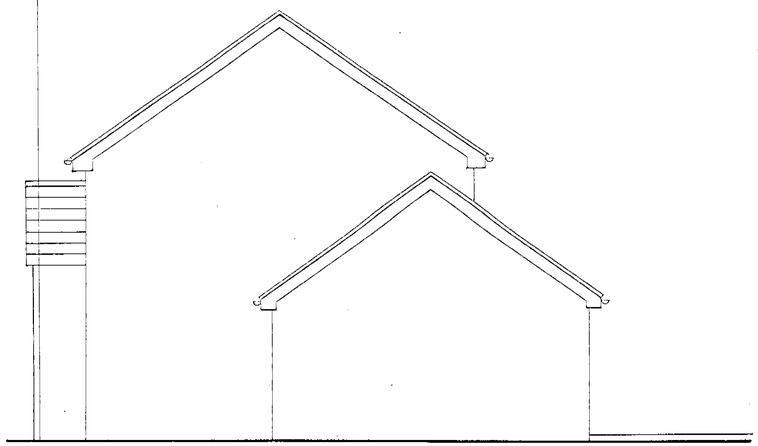

REAR ELEVATION



SIDE ELEVATION

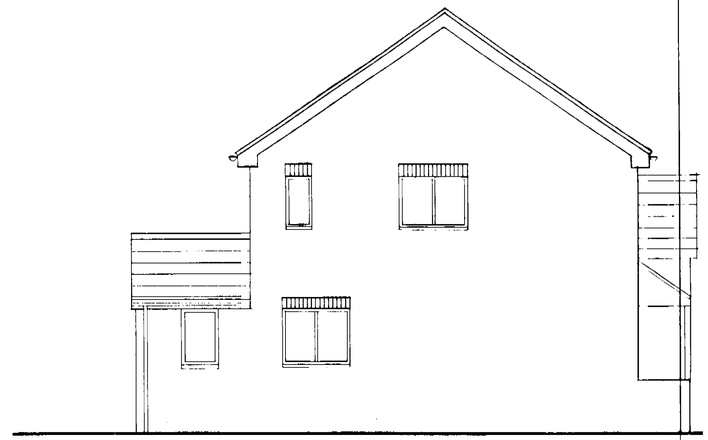

SIDE ELEVATION

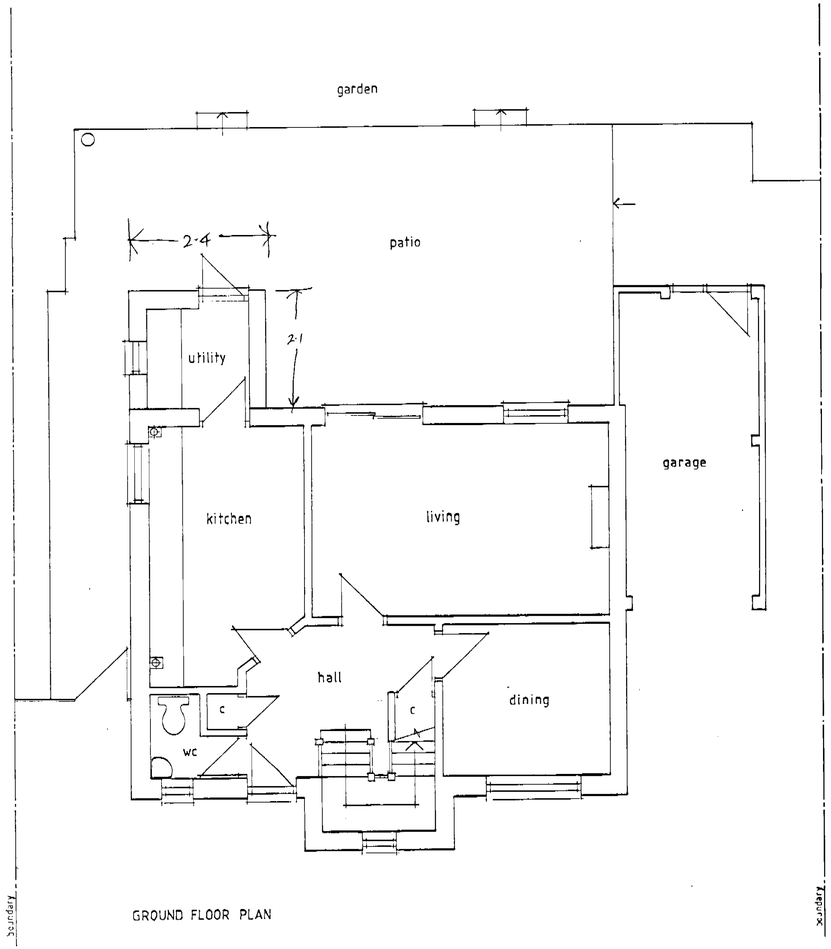

GROUND FLOOR PLAN

27.MAR2002* 6244

Client
Mr + Mrs Schippers

Project
8 Sibley Park Road
Earley
Reading
Berkshire

Drawing Title
Existing plan + elevation

Scale	Drawn	Date
1. 50		MAR 02

Drawing No 162 / 01