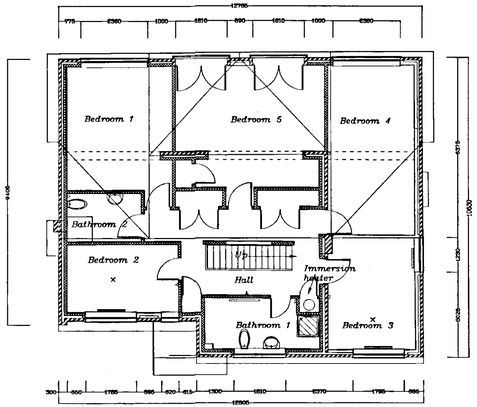


First ~~Floor~~ Plan 1:100

Revised Plan
-for first floor only

1 0 DEC 2001

CLIENT'S ADDRESS

34 KEEPMATCH RD
WOKINGHAM
BERKSHIRE
RG40 1Q7

DRAWING TITLE

PROPOSED WORKS


PROJECT TITLE

EXTENSION TO EXISTING BUILDING


DRAWN	DATE	SCALE
CNT	06/12/01	1:100
PROJECT No.	DWG No.	REV No.
001	002	001

A ONE CONSULTANTS


CARL TAGOE ARCHITECT RIBA
DALE COTTAGE
40 ROSE HILL
BINFIELD
BERKSHIRE, RG42 5LG
TEL / FAX (01344) 423044
E-MAIL CARL.TAGOE@FREE-INTERNET.CO.UK

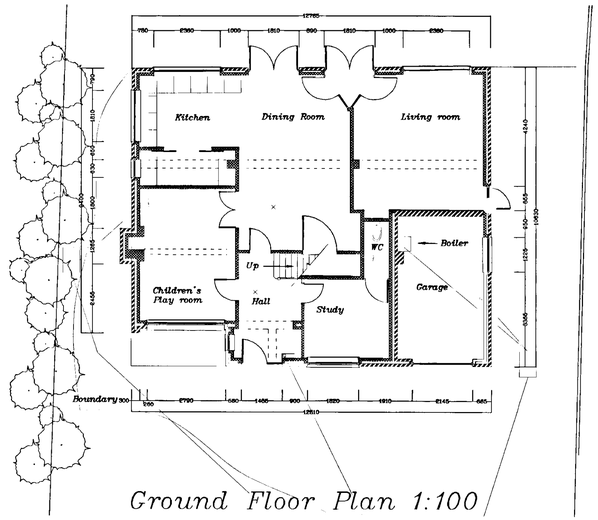


Ground Floor Plan 1:100

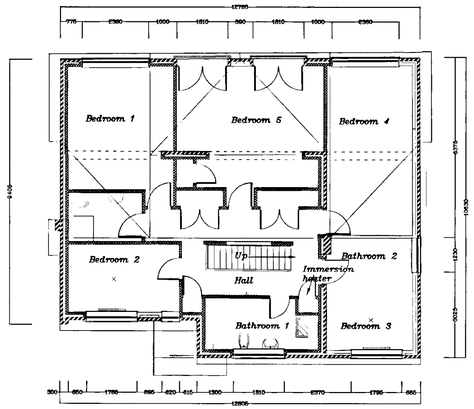


First Floor Plan 1:100
Superseded by drawing n° 002 Revision 001
(first floor superseded only)

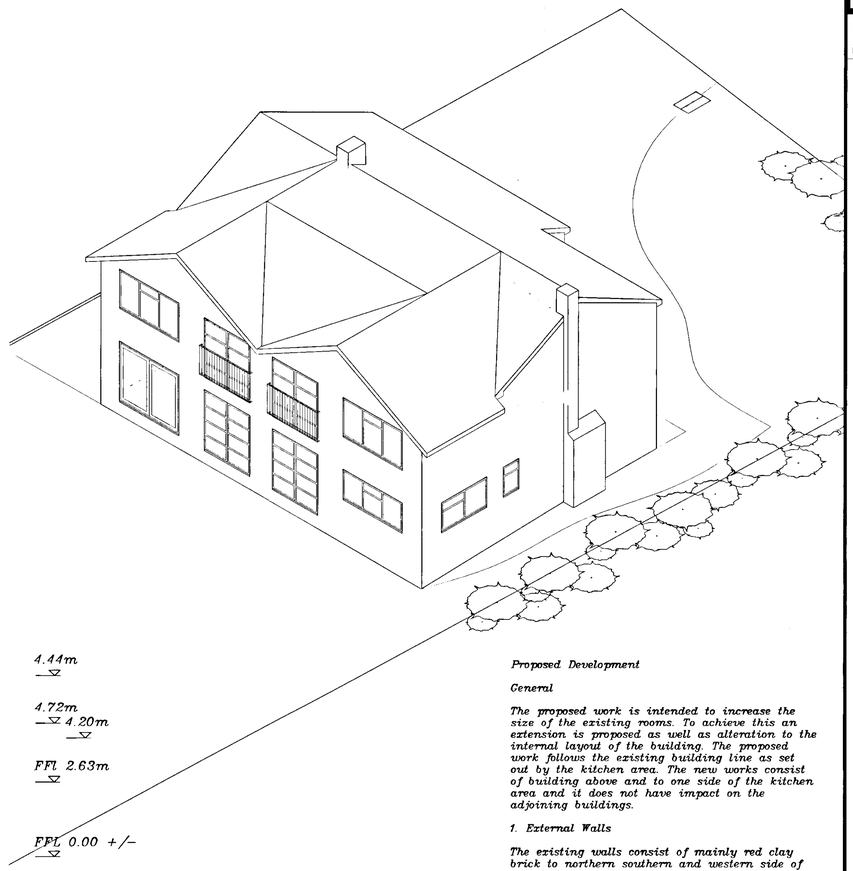


3D View NTS

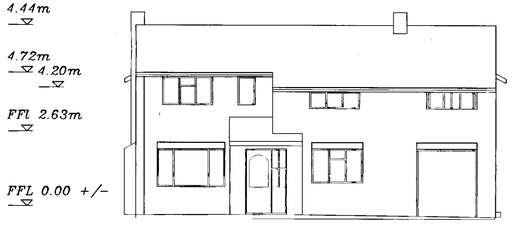


East Facade 1:100

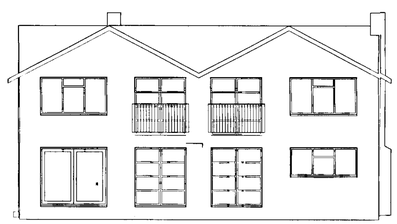


West Facade 1:100

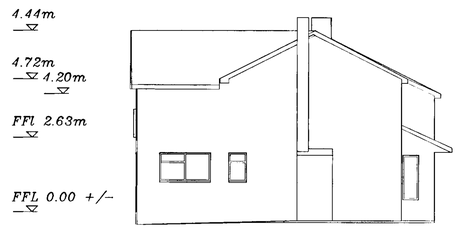

South Facade 1:100

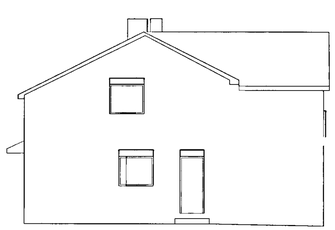

North Facade 1:100

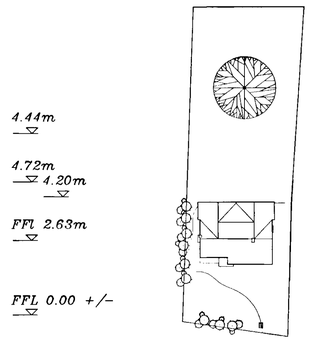

Site Plane 1:500

Proposed Development

General

The proposed work is intended to increase the size of the existing rooms. To achieve this an extension is proposed as well as alteration to the internal layout of the building. The proposed work follows the existing building line as set out by the kitchen area. The new works consist of building above and to one side of the kitchen area and it does not have impact on the adjoining buildings.

1. External Walls

The existing walls consist of mainly red clay brick to northern southern and western side of the building and red clay brick and white render to the eastern side. The proposed works on the western façade is to be in clay brick to match existing

2. Windows

All windows are in timber, painted white. Proposed new works are to be similar.

3. Roof

There are various roof finishes, to existing building, interlocking tiles to pitched roofs; subsequent flat roof is in bitumen felt. Proposed new extension is to be traditional pitched roof-using materials to match existing.

4. Drainage

Except for forming new connections to existing drainage system there are no changes proposed.

5. Highway

The proposed development will not affect the existing access to the highway.

6. Parking

The proposed development will not affect the existing car parking spaces, as the number of bedrooms etc will remain the same.

7. Existing Trees

No trees are proposed to be felled in this development

THESE DRAWINGS ARE TO BE USED FOR PLANNING APPLICATION SUBMISSION AND ARE NOT TO BE USED FOR DETAIL CONSTRUCTION PURPOSES.

Copy right of Carl Tagoe.

PROJECT No.	DWG No.	REV No.
002	002	___

REV NOTES.

REV	DATE	DRAWN	NOTES

NOTES

27.NOV.2001 • 5353

A ONE CONSULTANTS

CARL TAGOE ARCHITECT RIBA
DALE COTTAGE
40 ROSE HILL
BINFIELD
BERKSHIRE, RG42 5LG
TEL. (01344) 423044
E-MAIL CARL.TAGOE@FREE-INTERNET.CO.UK

PROJECT TITLE

EXTENSION TO EXISTING BUILDING

CLIENT'S ADDRESS


34 KEEPHATCH ROAD
WOKINGHAM
BERKSHIRE
RG40 1QJ

DRAWING TITLE


PROPOSED WORKS
APPROVED

DRAWN	DATE	SCALE
CNT	06/11/01	1:100


PROJECT No.	DWG No.	REV No.
001	002	___

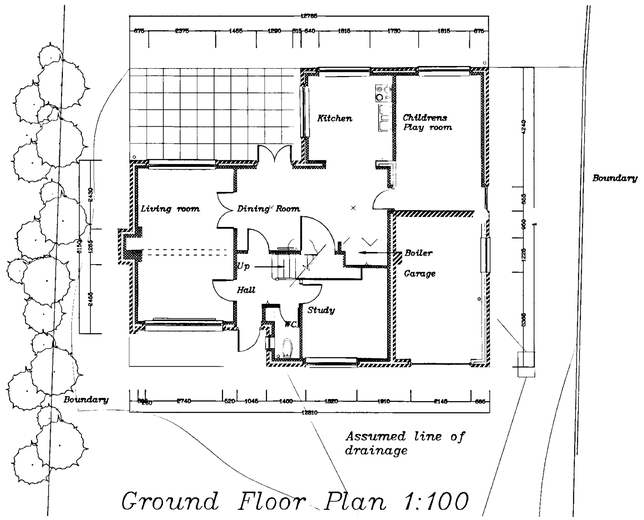

Ground Floor Plan 1:100

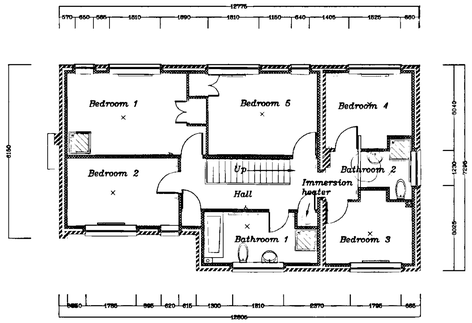

First Floor Plan 1:100

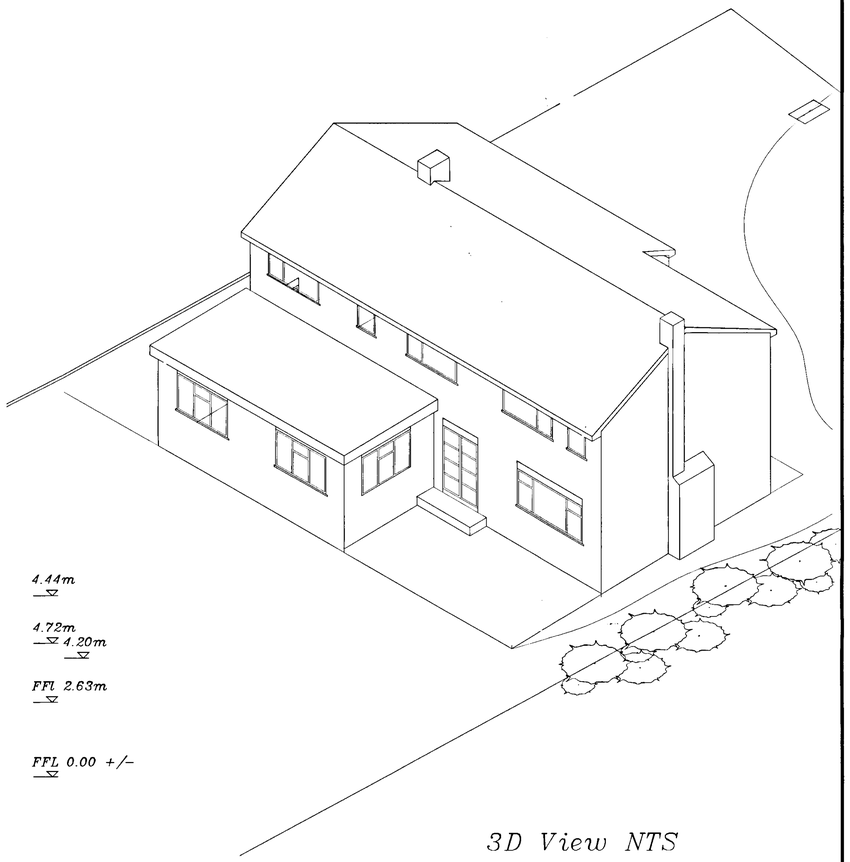


3D View NTS




East Facade 1:100




West Facade 1:100

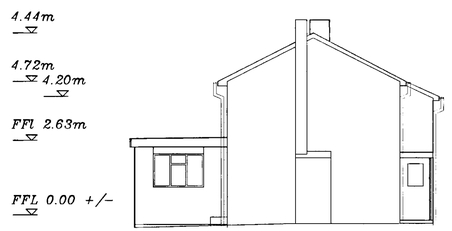


South Facade 1:100

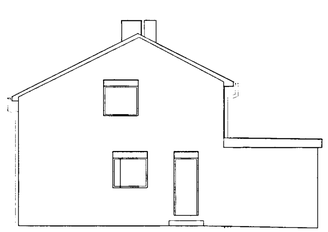

North Facade 1:100

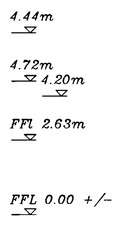

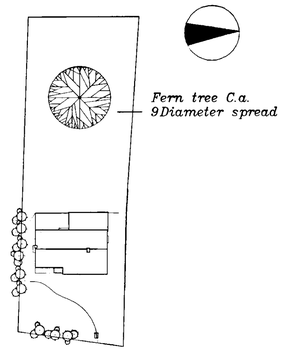

Site Plane 1:500

THESE DRAWINGS ARE TO BE USED FOR PLANNING APPLICATION SUBMISSION AND ARE NOT TO BE USED FOR DETAIL CONSTRUCTION PURPOSES.

Copy right of Carl Tagoe.

PROJECT No.	DWG No.	REV No.
001	001	

REV NOTES.

REV	DATE	DRAWN	NOTES

NOTES

27.NOV.2001* 5353

A ONE CONSULTANTS

CARL TAGOE ARCHITECT RIBA
DALE COTTAGE
40 ROSE HILL
BINFIELD
BERKSHIRE, RG42 5LG
TEL. (01344) 423044
E-MAIL CARL.TAGOE@FREE-INTERNET.CO.UK

PROJECT TITLE

EXTENSION TO EXISTING BUILDING

CLIENT'S ADDRESS

34 KEEPHATCH ROAD
WOKINGHAM
BERKSHIRE
RG40 1QJ


DRAWING TITLE

AS EXISTING

APPROVED

DRAWN	DATE	SCALE
CNT	06/11/01	1:100

PROJECT No.	DWG No.	REV No.
001	001	

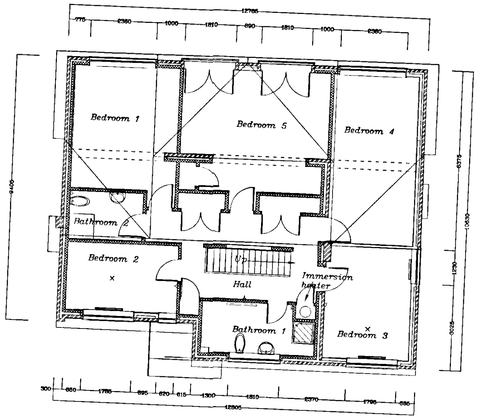

First ~~Floor~~ Plan 1:100

16 DEC 2001

Revised plan

A ONE CONSULTANTS

CARL TAGOE ARCHITECT RIBA
DALE COTTAGE
40 ROSE HILL
BINFIELD
BERKSHIRE, RG42 5LG
TEL / FAX (01344) 423044
E-MAIL CARL.TAGOE@FREE-INTERNET.CO.UK

CLIENT'S ADDRESS

34 KEEPHATCH RD
WOKINGHAM
BERKSHIRE
RG40 1G7


DRAWING TITLE

PROPOSED WORKS


PROJECT TITLE

EXTENSION TO EXISTING BUILDING


DRAWN	DATE	SCALE
CNT	06/12/01	1:100
PROJECT No.	DWG No.	REV No.
001	002	001

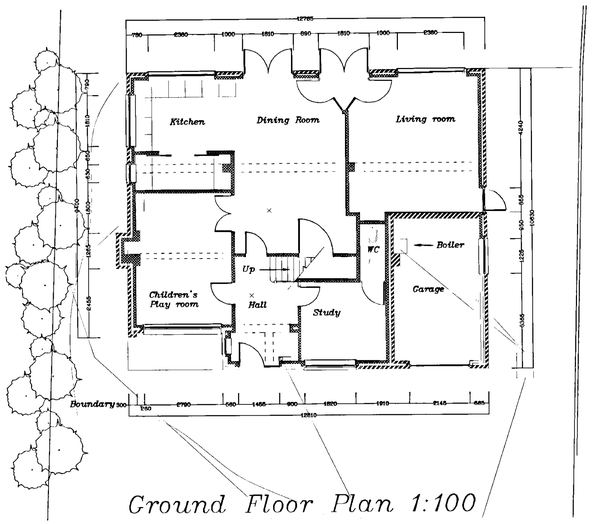

Ground Floor Plan 1:100

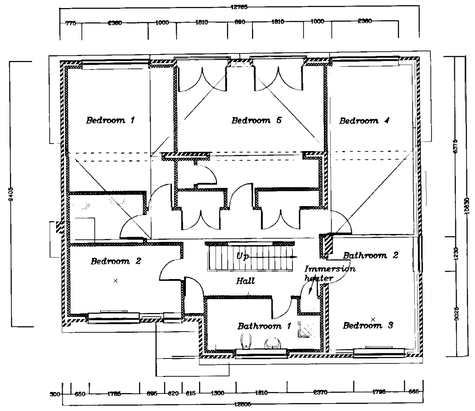


First Floor Plan 1:100
Superceded by 001 / 001 Rev 001
only first floor plan superceded

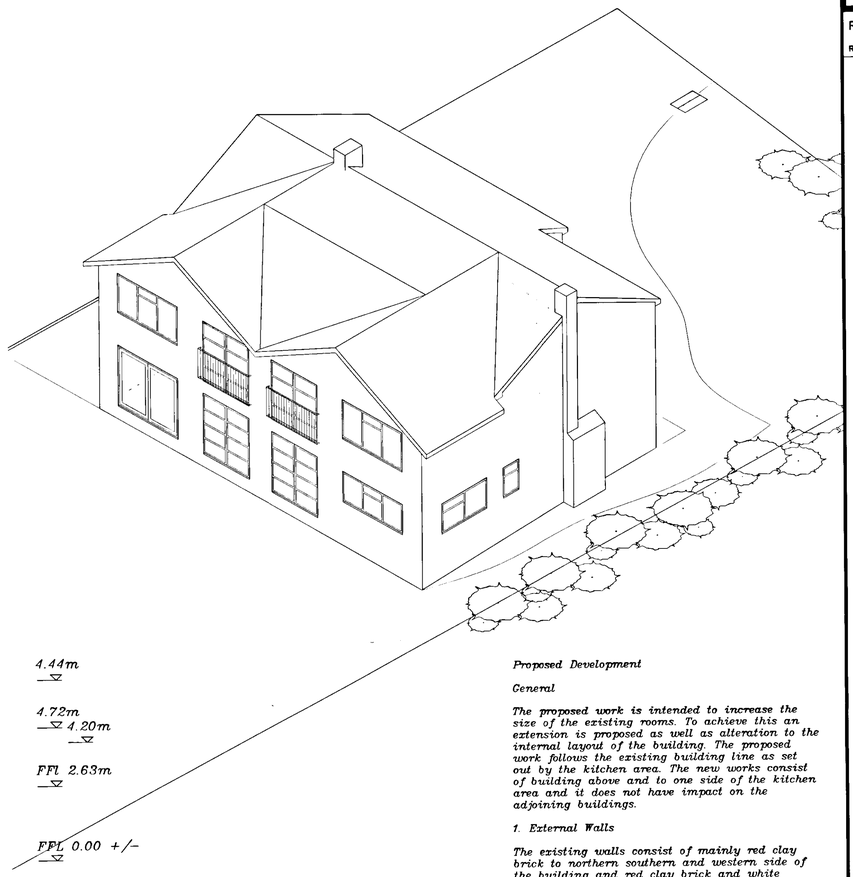


3D View NTS




East Facade 1:100

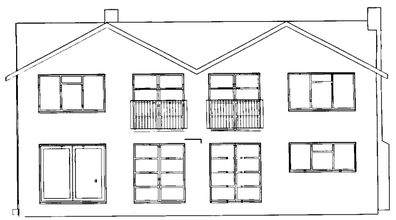


West Facade 1:100

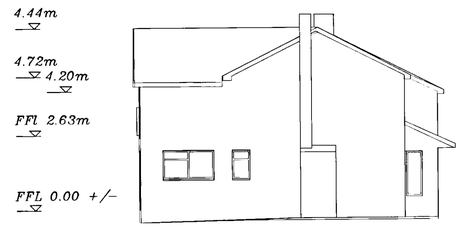

South Facade 1:100

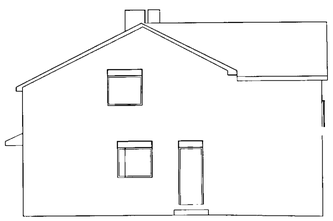

North Facade 1:100

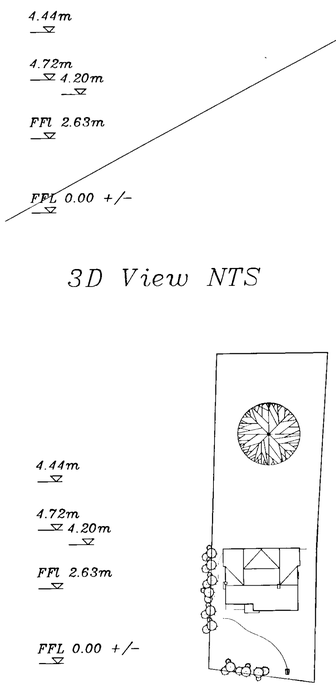

Site Plane 1:500

Proposed Development

General

The proposed work is intended to increase the size of the existing rooms. To achieve this an extension is proposed as well as alteration to the internal layout of the building. The proposed work follows the existing building line as set out by the kitchen area. The new works consist of building above and to one side of the kitchen area and it does not have impact on the adjoining buildings.

1. External Walls

The existing walls consist of mainly red clay brick to northern southern and western side of the building and red clay brick and white render to the eastern side. The proposed works on the western façade is to be in clay brick to match existing

2. Windows

All windows are in timber, painted white. Proposed new works are to be similar.

3. Roof

There are various roof finishes, to existing building, interlocking tiles to pitched roofs; subsequent flat roof is in bitumen felt. Proposed new extension is to be traditional pitched roof-using materials to match existing.

4. Drainage

Except for forming new connections to existing drainage system there are no changes proposed.

5. Highway

The proposed development will not affect the existing access to the highway.

6. Parking

The proposed development will not affect the existing car parking spaces, as the number of bedrooms etc will remain the same.

7. Existing Trees

No trees are proposed to be felled in this development

THESE DRAWINGS ARE TO BE USED FOR PLANNING APPLICATION SUBMISSION AND ARE NOT TO BE USED FOR DETAIL CONSTRUCTION PURPOSES.



Copy right of Carl Tagoe.

PROJECT No.	DWG No.	REV No.
002	002	___

REV NOTES.

REV	DATE	DRAWN	NOTES

NOTES

27 NOV 2001 5353

A ONE CONSULTANTS

CARL TAGOE ARCHITECT RIBA
DALE COTTAGE
40 ROSE HILL
BINFIELD
BERKSHIRE, RG42 5LG
TEL. (01344) 423044
E-MAIL CARL.TAGOE@FREE-INTERNET.CO.UK

PROJECT TITLE

EXTENSION TO EXISTING BUILDING

CLIENT'S ADDRESS

34 KEEPHATCH ROAD
WOKINGHAM
BERKSHIRE
RG40 1QJ


DRAWING TITLE

PROPOSED WORKS


APPROVED

DRAWN	DATE	SCALE
CNT	06/11/01	1:100


PROJECT No.	DWG No.	REV No.
001	002	___

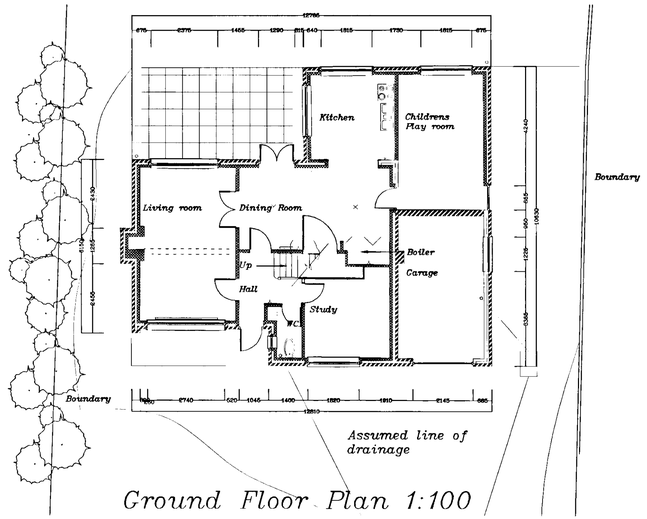

Ground Floor Plan 1:100

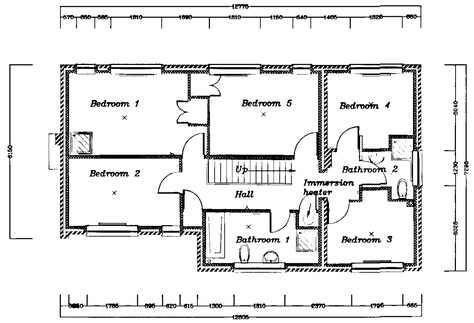

First Floor Plan 1:100

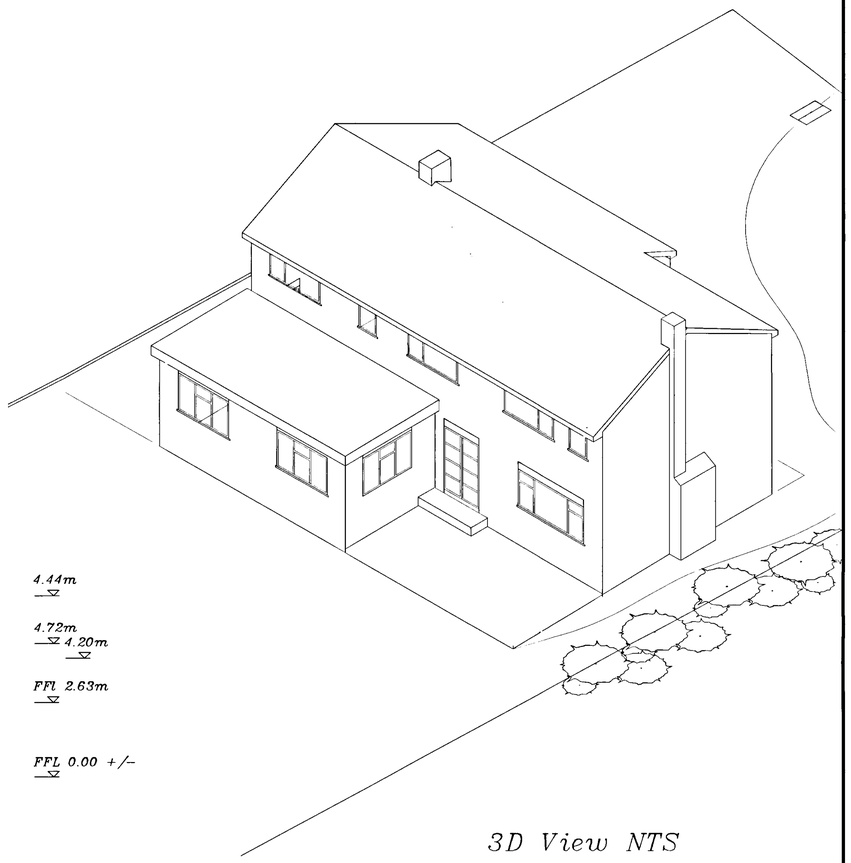


3D View NTS




East Facade 1:100




West Facade 1:100

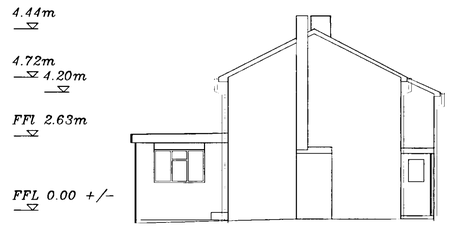

South Facade 1:100

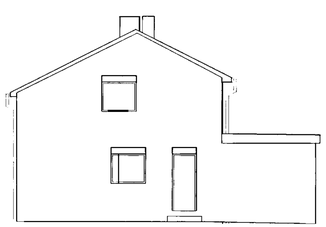

North Facade 1:100

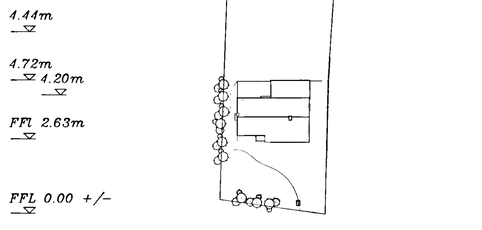

Site Plane 1:500

THESE DRAWINGS ARE TO BE USED FOR PLANNING APPLICATION SUBMISSION AND ARE NOT TO BE USED FOR DETAIL CONSTRUCTION PURPOSES.

Copy right of Carl Tagoe.

PROJECT No.	DWG No.	REV No.
001	001	

REV NOTES.

REV	DATE	DRAWN	NOTES

NOTES

27.NOV.2001 5353

A ONE CONSULTANTS

CARL TAGOE ARCHITECT RIBA
DALE COTTAGE
40 ROSE HILL
BINFIELD
BERKSHIRE, RG42 5LG
TEL. (01344) 423044
E-MAIL CARL.TAGOE@FREE-INTERNET.CO.UK

PROJECT TITLE

EXTENSION TO EXISTING BUILDING

CLIENT'S ADDRESS

34 KEEPHATCH ROAD
WOKINGHAM
BERKSHIRE
RG40 1QJ

DRAWING TITLE

AS EXISTING
APPROVED

DRAWN	DATE	SCALE
CNT	06/11/01	1:100

PROJECT No.	DWG No.	REV No.
001	001	