

TL/2000/2565
25/10/00

SITE.

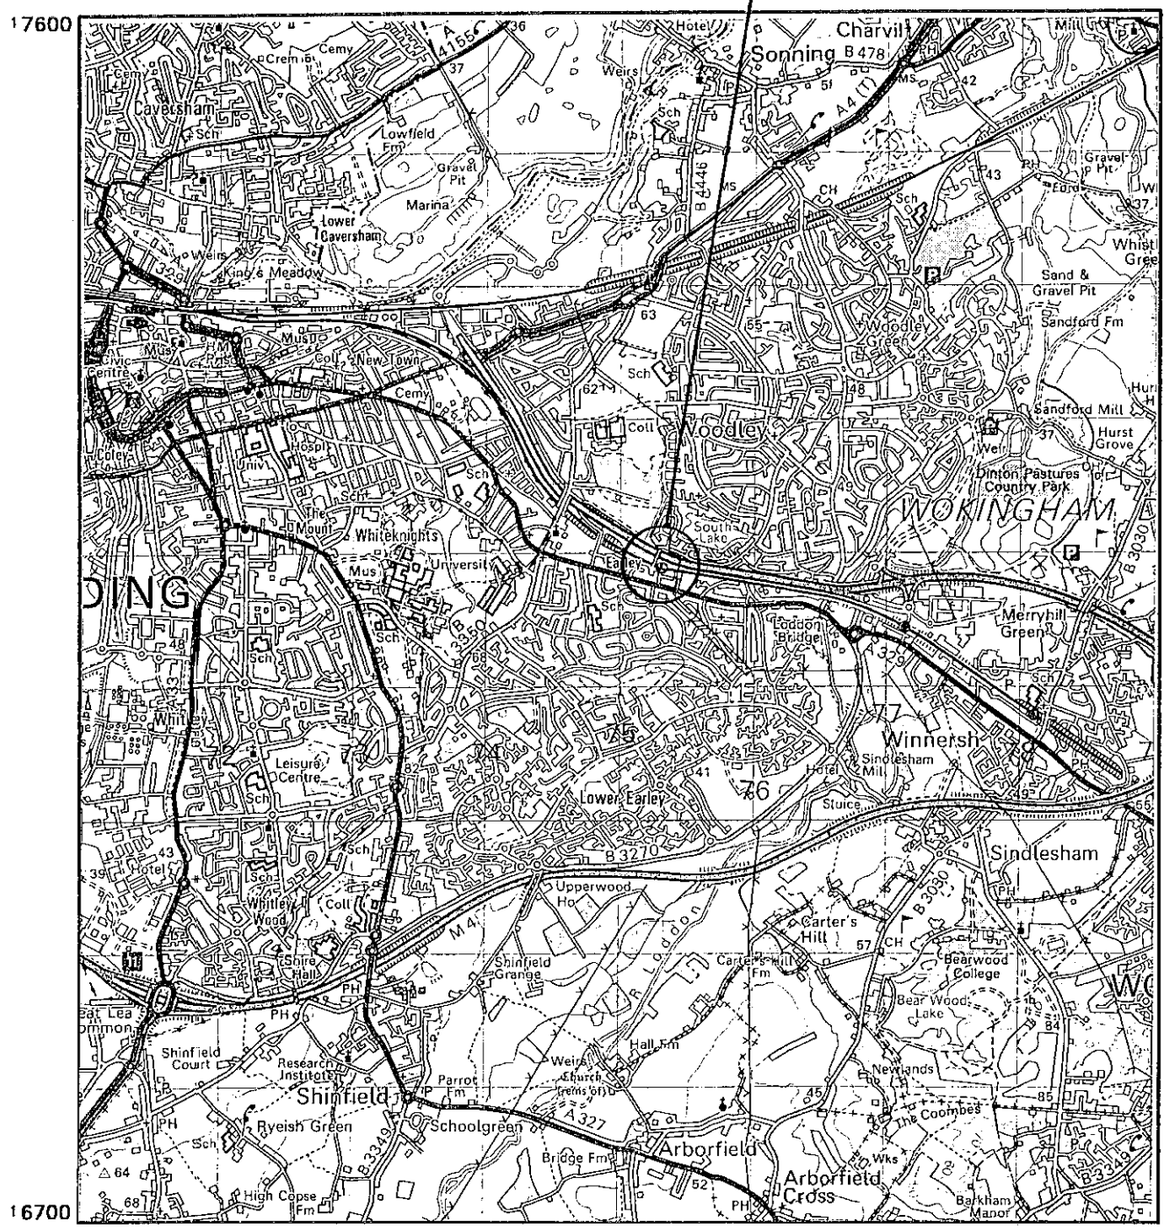


Site Grid Reference SU 7529 7189
Landranger 1:50,000. Map number 175

SITE.

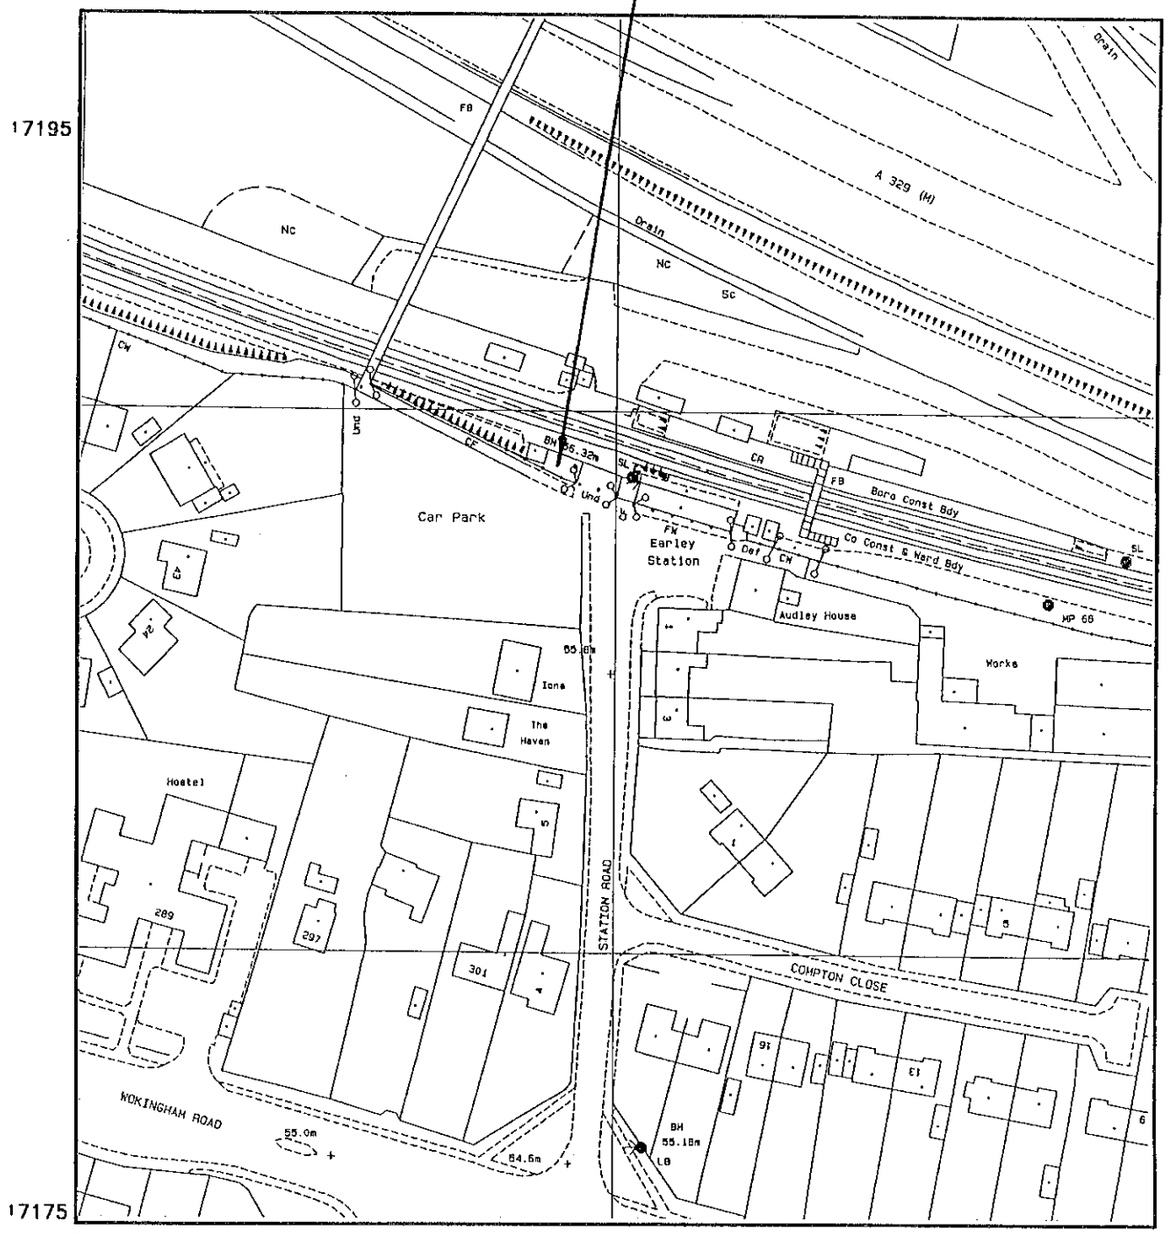

Site Grid Reference SU 7529 7189
(Scale 1:1,250)

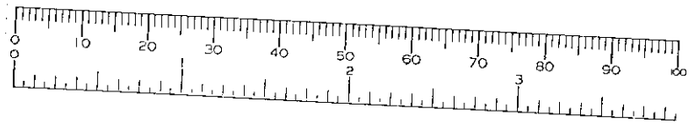

Reproduced from the Ordnance Survey maps with permission of the Controller of H.M. Stationery office. © Crown Copyright.

7183D

Ballast Wiltshier FS22848

vodafone FS12463


REV	BY/CHK	APP'D	DESCRIPTION	DATE
-	MJW/NK	JC/BQP	Contract issue	21/04/98

EARLEY – BRITISH RAIL STATION – STATION ROAD
SITE LOCATION MAPS


SCALES	Drawing Status	DWG No.	Rev
AS SHOWN	Construction	3228–M1	–

TL/2000/2565


25/10

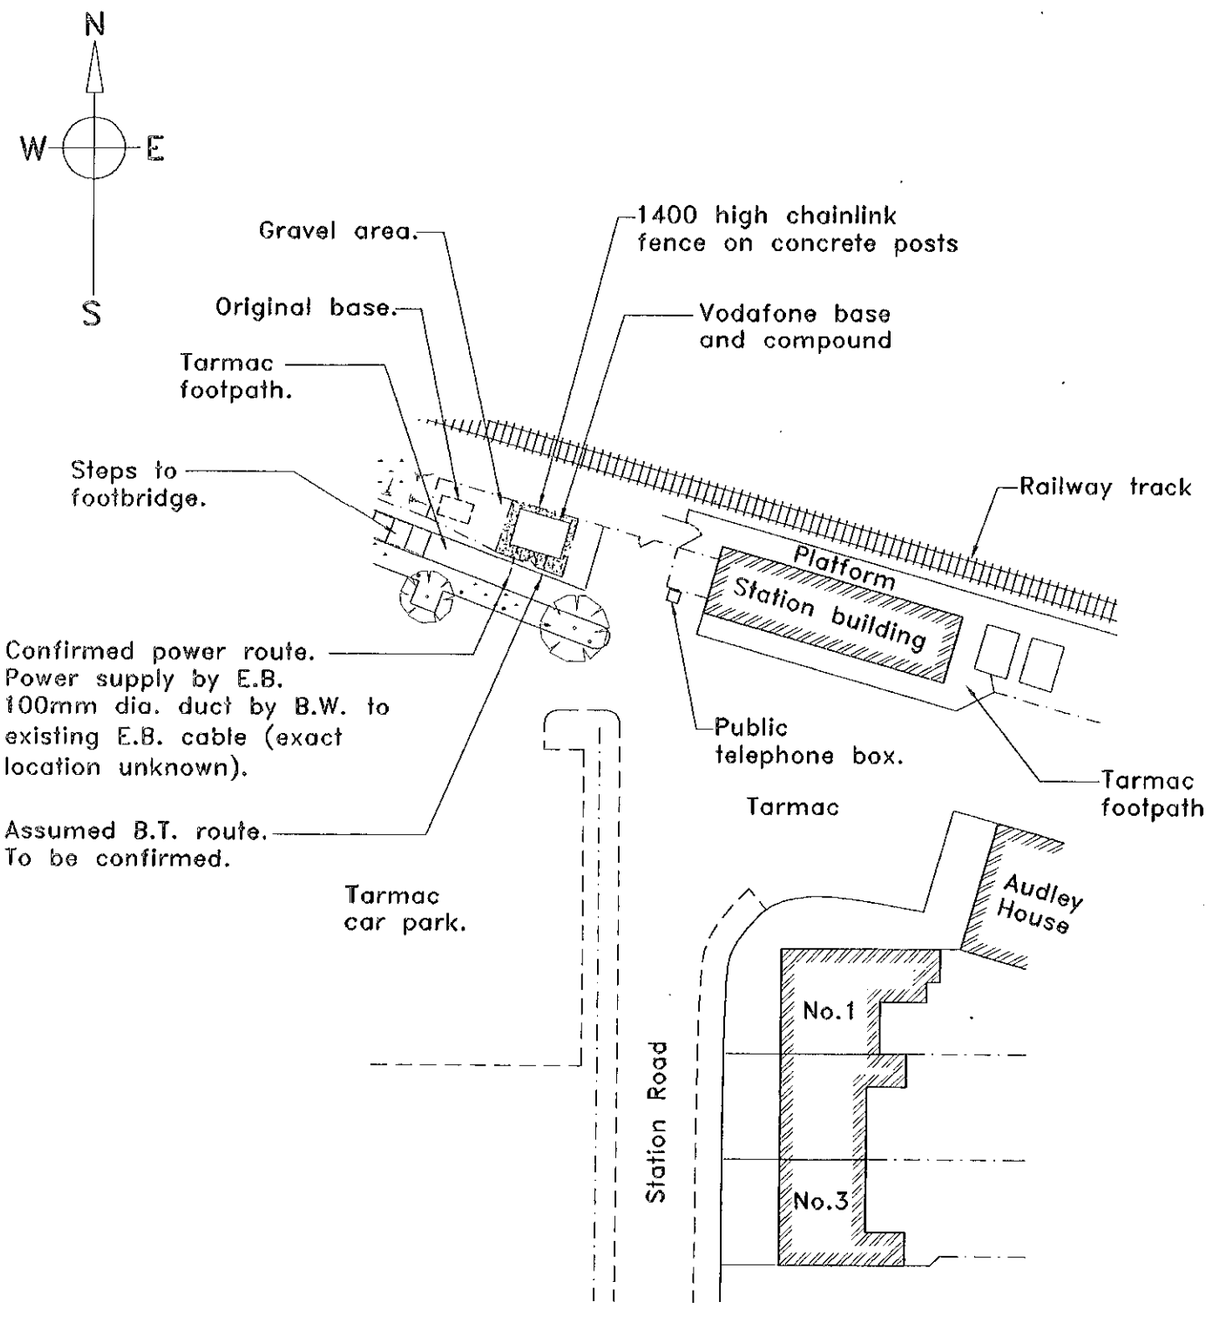

SITE PLAN.
1:500

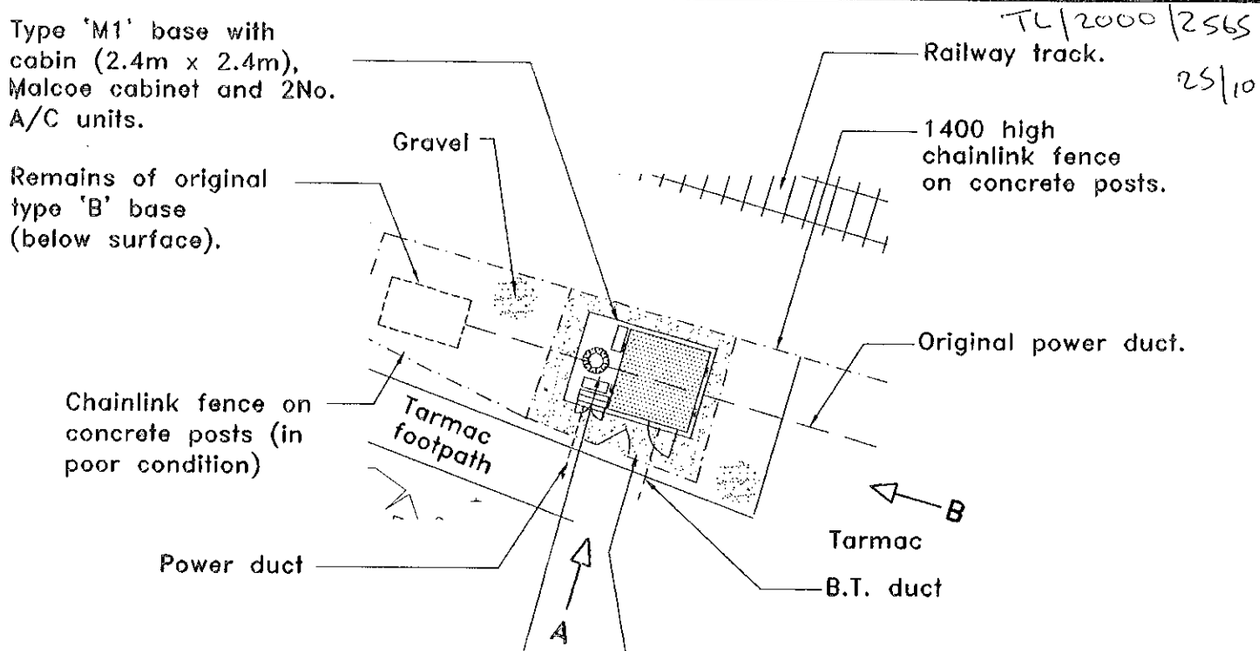

BASE LOCATION PLAN.
1:200

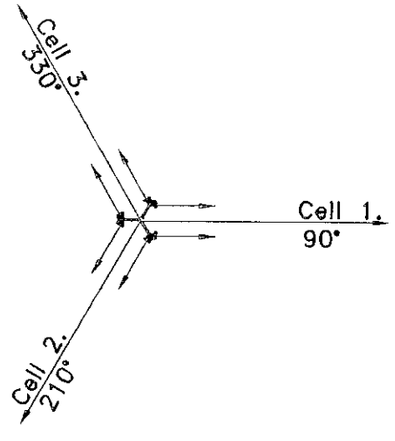

ANTENNA ORIENTATION PLAN.

71830

Ballast Wiltshier FS22848

vodafone FS12463

REV	BY / CHK	APP'D	DESCRIPTION		DATE
-	MJW/NK	JC/BQP	Contract issue		21/04/98
A	MJW/JC	JC/BQP	Power route confirmed	(3637)	01/06/98
B	NK/MJW	MJW/BQP	Compound gate revised and step deleted.	(4716)	09/04/99
C	KFL/JB	JB/BW	Phase 2 pole indicated.		21/08/00
D	RWC/JB	JB/BW	Pole arrangement amended.		07/09/00
E	CM/JB	JB/B	Phase 2 pole indicated.		13/10/00

EARLEY – BRITISH RAIL STATION – STATION ROAD
SITE PLANS


SCALES	Drawing Status	DWG No.	Rev
1:500 1:200	Proposal	3228–T1	E

TL/2000/2565
25/10


NOTES

Type 'M1' base with:-
15.0m pole (Type 15)
3No. XPD 72-10 X-polar antennas (Headload 7)
Orientations - Cell 1 = 90° (0°-6° downtilt)
Cell 2 = 210° (0°-6° downtilt)
Cell 3 = 330° (0°-6° downtilt)
Cabin (2.4m x 2.4m), Malcoe cabinet and 2No. A/C units.


Confirmed B.T. landline.

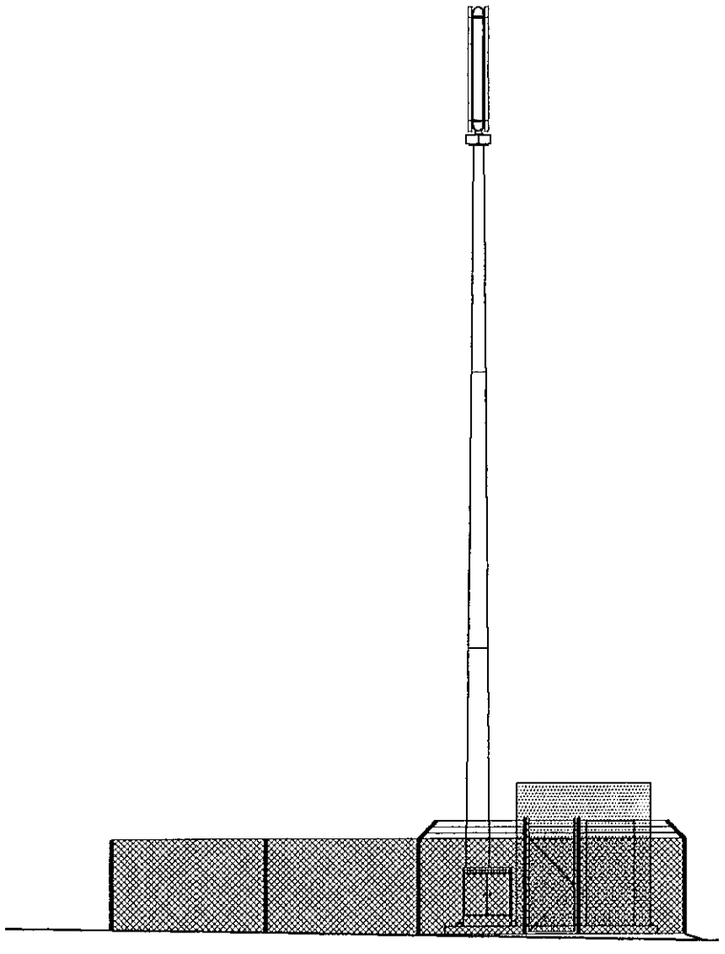

VIEW A

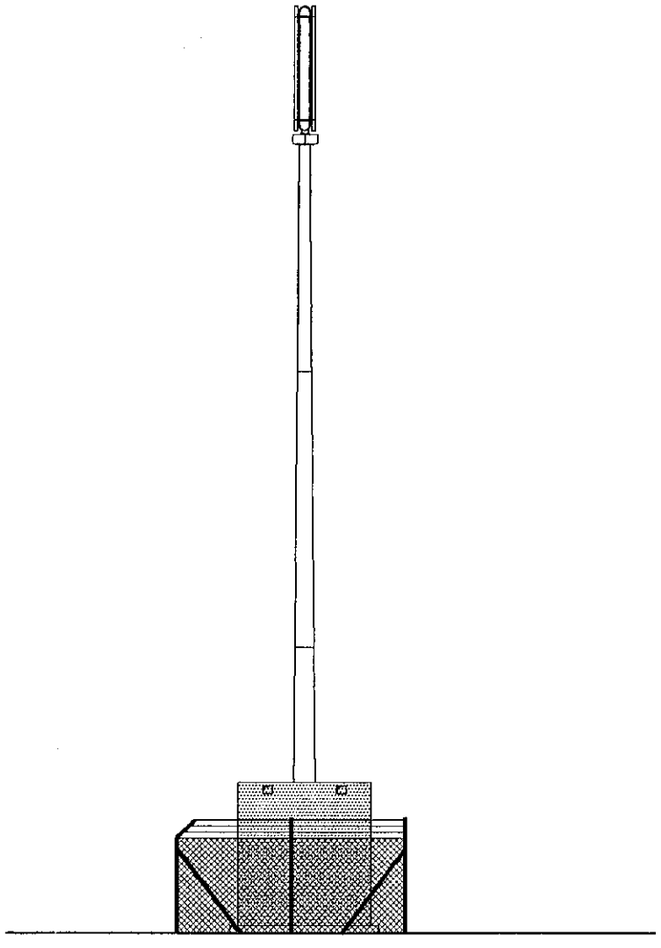

VIEW B

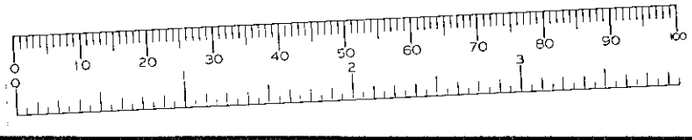

NOTE: REPRESENTATION ONLY - DO NOT SCALE FROM THIS DRAWING.

Ballast Wiltshier FS22848

vodafone FS12463

REV	BY/CHK	APP'D	DESCRIPTION	DATE
-	KFL/JB	JB/BW	Contract issue	22/08/00
A	LJC/JB	JB/BW	Notes amended.	05/09/00

EARLEY - BRITISH RAIL STATION- STATION ROAD
ELEVATIONS (CURRENT ARRANGEMENT)


SCALES	Drawing Status	DWG No.	Rev
1:100	As Built	3228-T3	A

TL/2000/2565
25/10

NOTES

Type 'M1' base with:-
New 15.0m Phase 2 pole - existing Monopole to be removed.
6No. XPD 72-10 X-polar antennas.
Orientations - Cell 1 = 90° (0°-6° downtilt)
Cell 2 = 210° (0°-6° downtilt)
Cell 3 = 330° (0°-6° downtilt)
Cabin (2.4m x 2.4m), Malcoe cabinet and 2No. A/C units all to remain.

Confirmed B.T. landline.

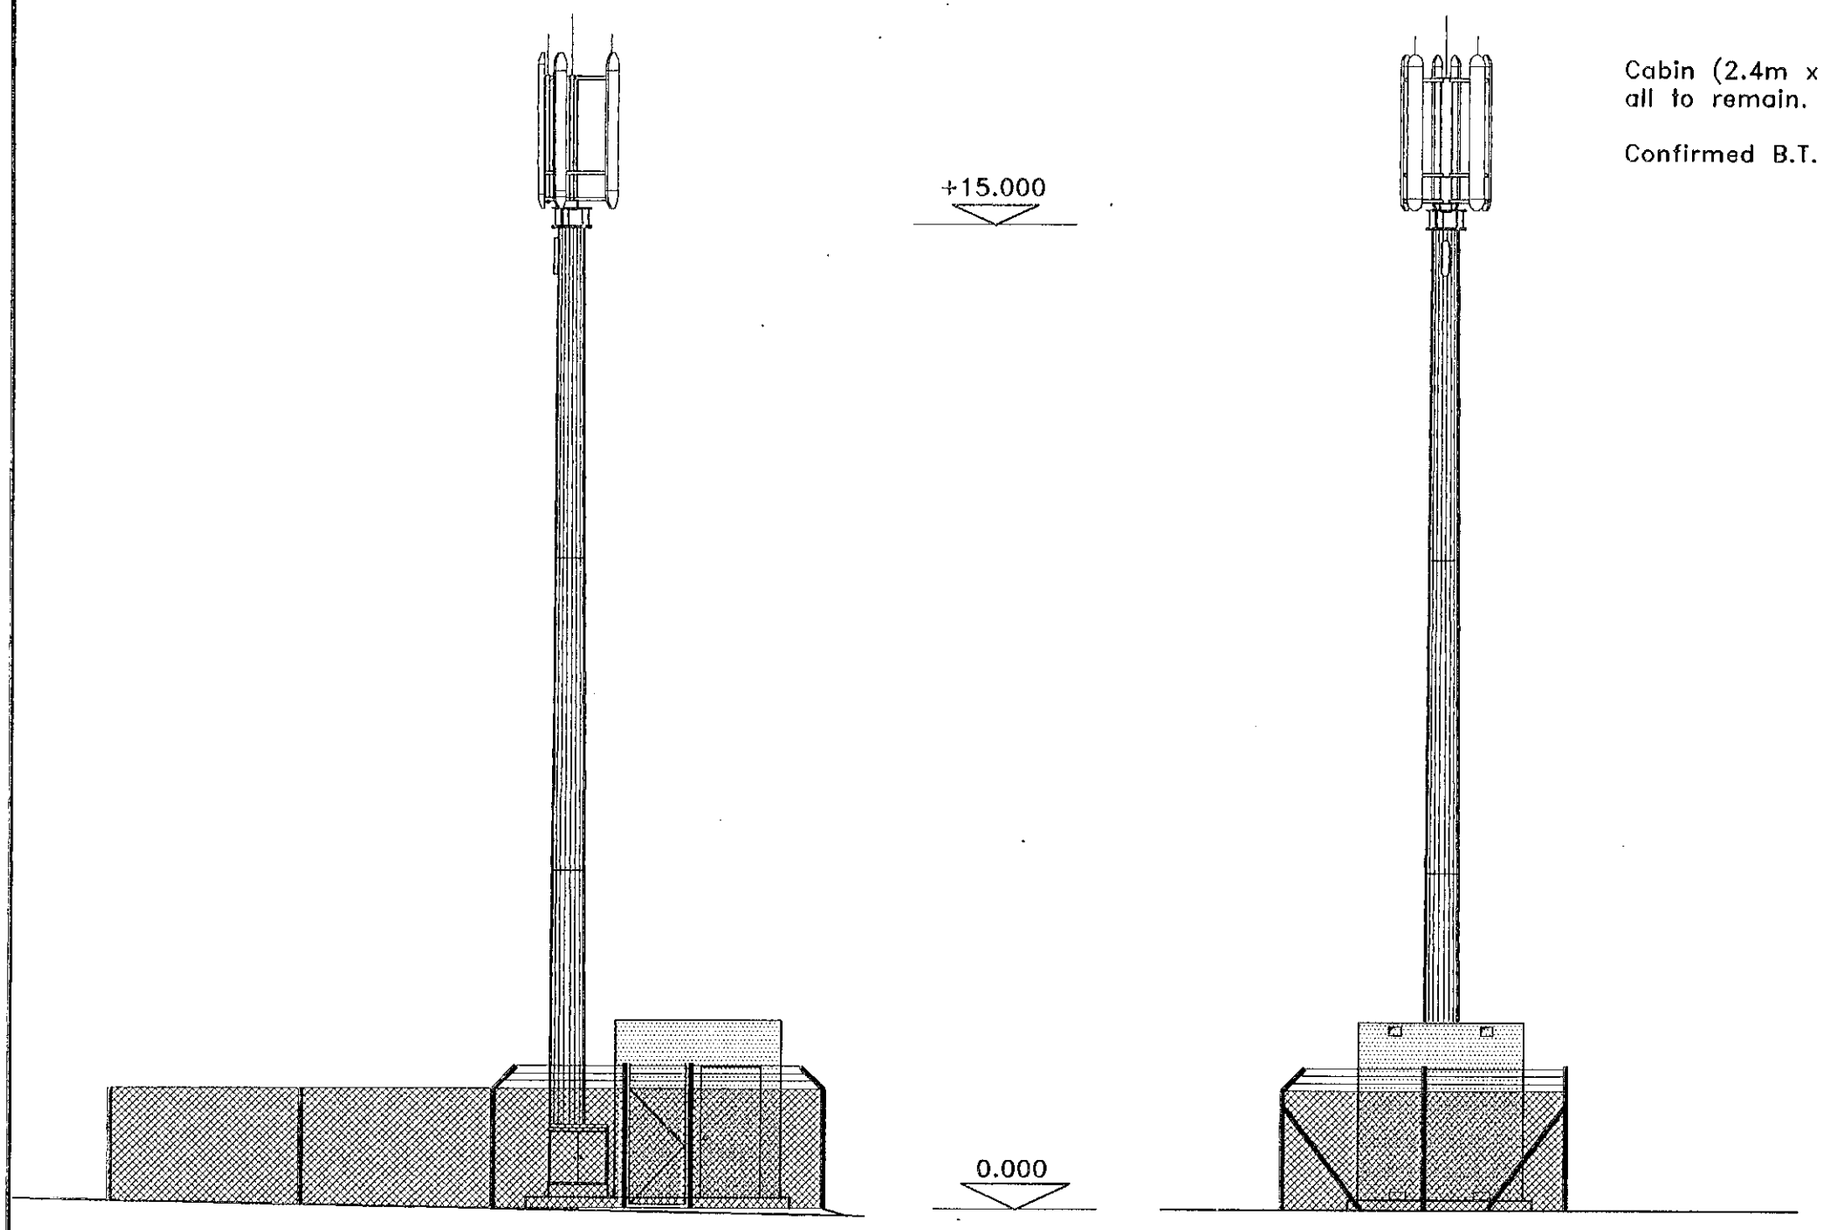

VIEW A

VIEW B

NOTE: REPRESENTATION ONLY - DO NOT SCALE FROM THIS DRAWING.

Ballast Wiltshier FSZ2848

vodafone FS12463

REV	BY/CHK	APP'D	DESCRIPTION	DATE
-	MJK/NK	JC/BQP	Contract issue.	21/04/00
A	KFL/JB	JB/BW	Phase 2 pole indicated.	22/08/00
B	RWG/JB	JB/BW	Pole arrangement amended.	07/09/00
C	CM/JB	JB/BW	Phase 2 pole indicated.	16/10/00

EARLEY - BRITISH RAIL STATION - STATION ROAD
ELEVATIONS

SCALES	Drawing Status	DWG No.	Rev
1:100	Proposal	3228-T2	C