WEST ELEVATION – AS BUILT

Garden shelter, link roof and retained shelter walls · Scale 1:50

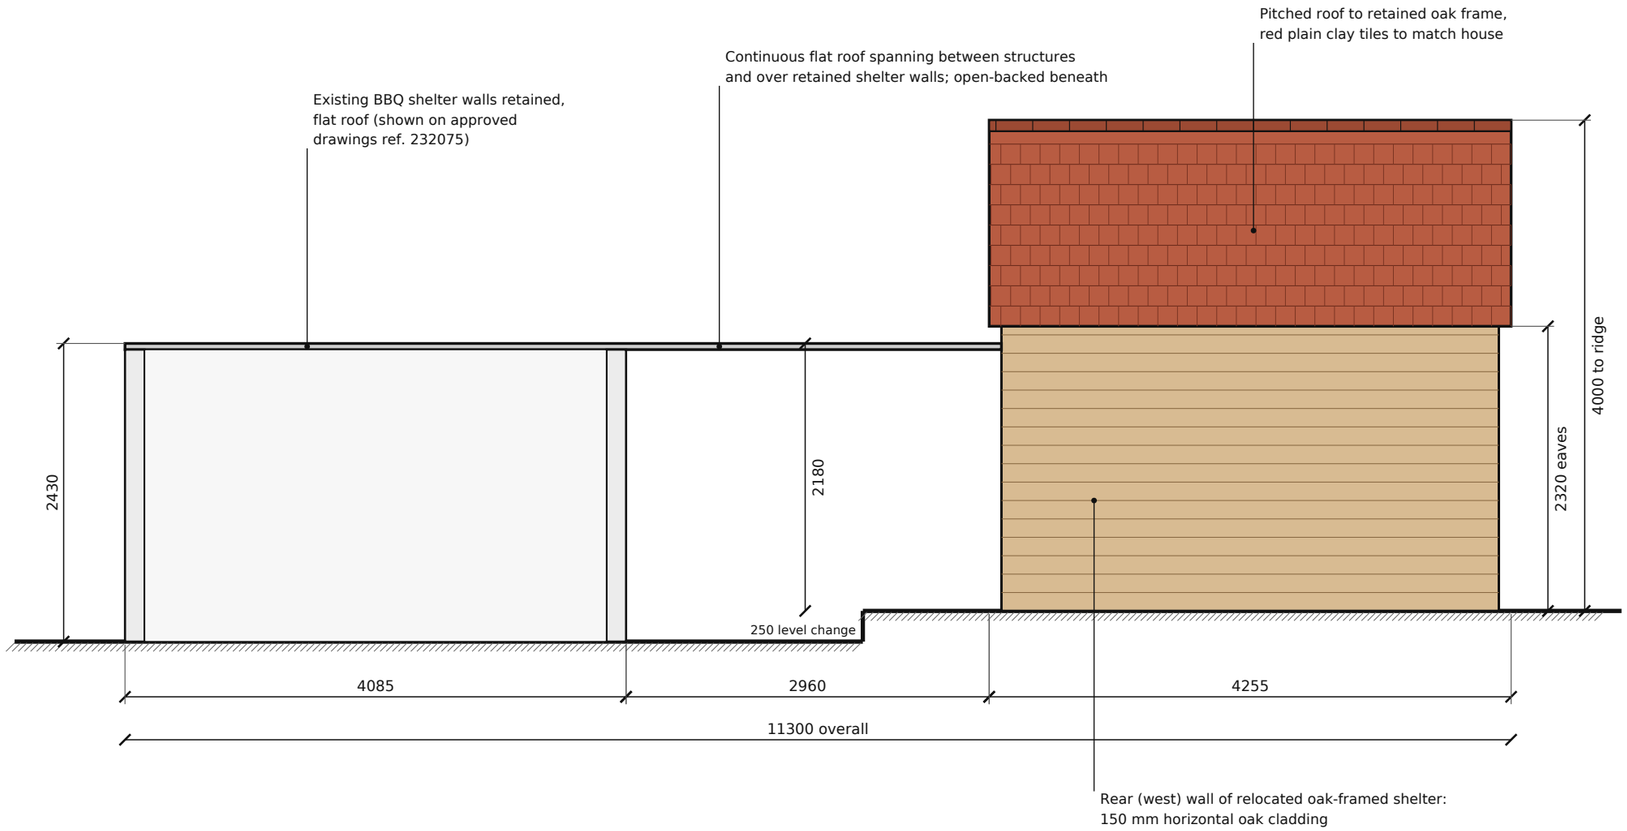



NOTES

1. All dimensions in millimetres unless stated otherwise.
2. Heights measured from adjacent finished ground level; ground falls 250 mm towards the retained shelter.
3. Oak frame: original summer house frame (approved under 052657) dismantled, relocated and re-erected on brick plinths.
4. Continuous flat roof at a single level over link and retained shelter; link section open-backed with no intermediate post.
5. Retained shelter: existing walls retained with new flat roof as shown on drawings approved under 232075.
6. Materials and finishes to match existing.
7. Oak frame roof: red plain clay tiles to match main house.
8. Rear (west) wall of oak-framed shelter: 150 mm horizontal oak cladding.

PROJECT
Retention of relocated oak-framed garden shelter, link roof and rear hardstanding

SITE
Apple Tree Cottage, Church Lane, Arborfield, Reading RG2 9JA

CLIENT
Mr & Mrs L Haughton

DRAWING
Garden Shelter – West Elevation (As Built)

SCALE	DATE	DRAWN
1:50 @ A3	31.10.26	LH

DRAWING No.	REV	STATUS
ATC-GS-02	**A**	**PLANNING**