NORTH ELEVATION – AS BUILT

Log store north end with oak-framed shelter beyond · Scale 1:50

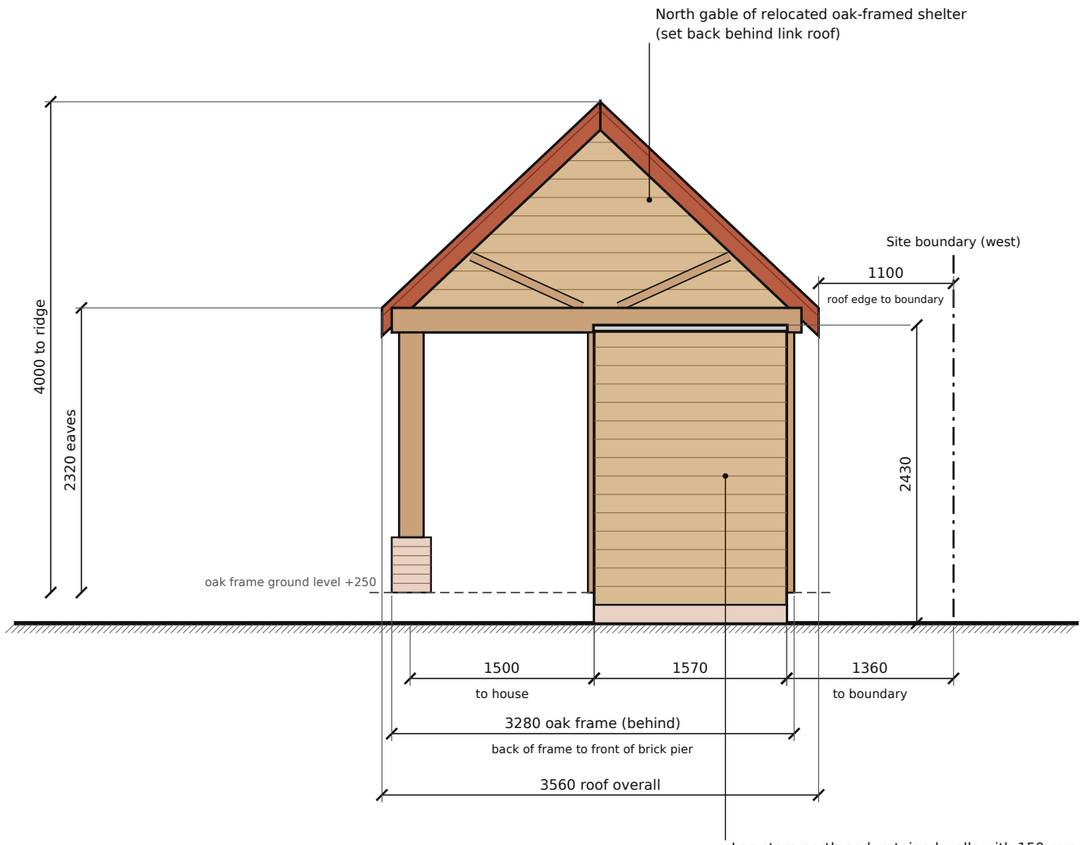

Log store north end: retained walls with 150 mm horizontal oak cladding on brick course; 50 mm flat roof

SCALE BAR 1:50

0 1 2 3 4 5 m

NOTES

1. All dimensions in millimetres unless stated otherwise.
2. Heights measured from adjacent finished ground level.
3. Oak frame: original summer house frame (approved under 052657) dismantled, relocated and re-erected on brick plinths.
4. Oak frame roof: red plain clay tiles to match main house.
5. Walls: horizontal oak cladding, 150 mm boards.
6. Ground falls 250 mm from oak frame to log store; heights of log store from lower ground, heights of oak frame from upper ground.

PROJECT
Retention of relocated oak-framed garden shelter, link roof and rear hardstanding

SITE
Apple Tree Cottage, Church Lane, Arborfield, Reading RG2 9JA

CLIENT
Mr & Mrs L Haughton

DRAWING
Garden Shelter – North Elevation (As Built)

SCALE	DATE	DRAWN
1:50 @ A3	31.10.26	LH

DRAWING No.	REV	STATUS
ATC-GS-03	**C**	**PLANNING**