SOUTH ELEVATION – AS BUILT

Gable end of relocated oak-framed shelter · Scale 1:50

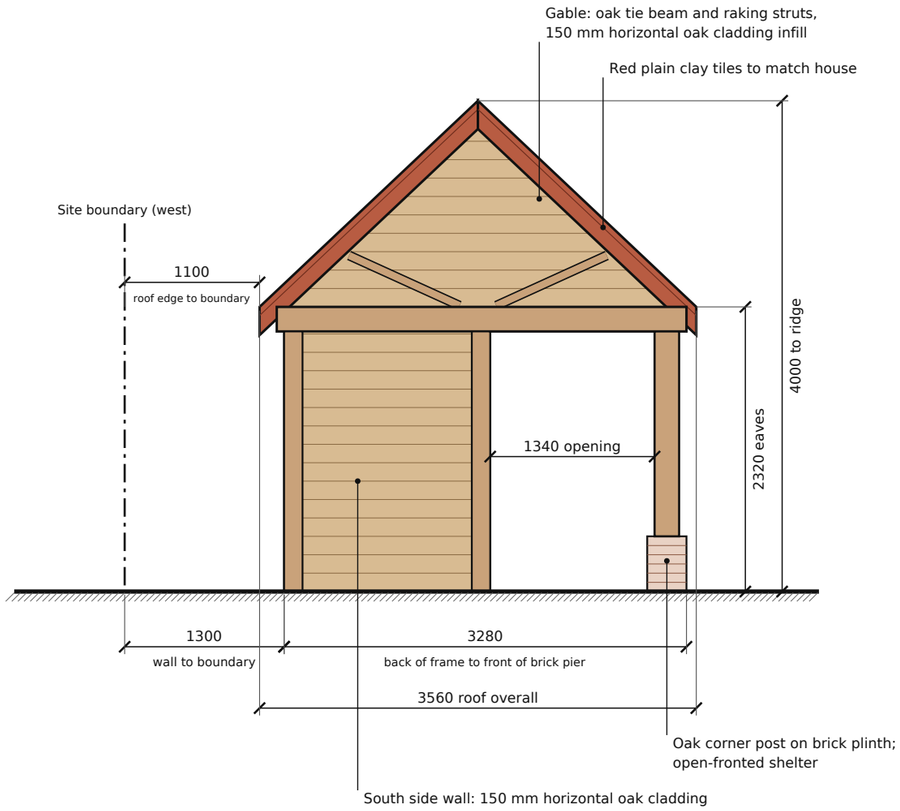

SCALE BAR 1:50

0 1 2 3 4 5 m

NOTES

1. All dimensions in millimetres unless stated otherwise.
2. Heights measured from adjacent finished ground level.
3. Oak frame: original summer house frame (approved under 052657) dismantled, relocated and re-erected on brick plinths.
4. Oak frame roof: red plain clay tiles to match main house.
5. Walls: horizontal oak cladding, 150 mm boards.
6. West boundary: 1300 mm from oak frame wall, 1100 mm from roof edge.

PROJECT Retention of relocated oak-framed garden shelter, link roof and rear hardstanding		
SITE Apple Tree Cottage, Church Lane, Arborfield, Reading RG2 9JA		
CLIENT Mr & Mrs L Haughton		
DRAWING Garden Shelter – South Elevation (As Built)		
SCALE 1:50 @ A3	**DATE** 31.10.26	**DRAWN** LH
DRAWING No. **ATC-GS-04**	**REV** **C**	**STATUS** **PLANNING**