PLAN – AS BUILT

Oak-framed shelter, BBQ link roof and log store · Scale 1:50

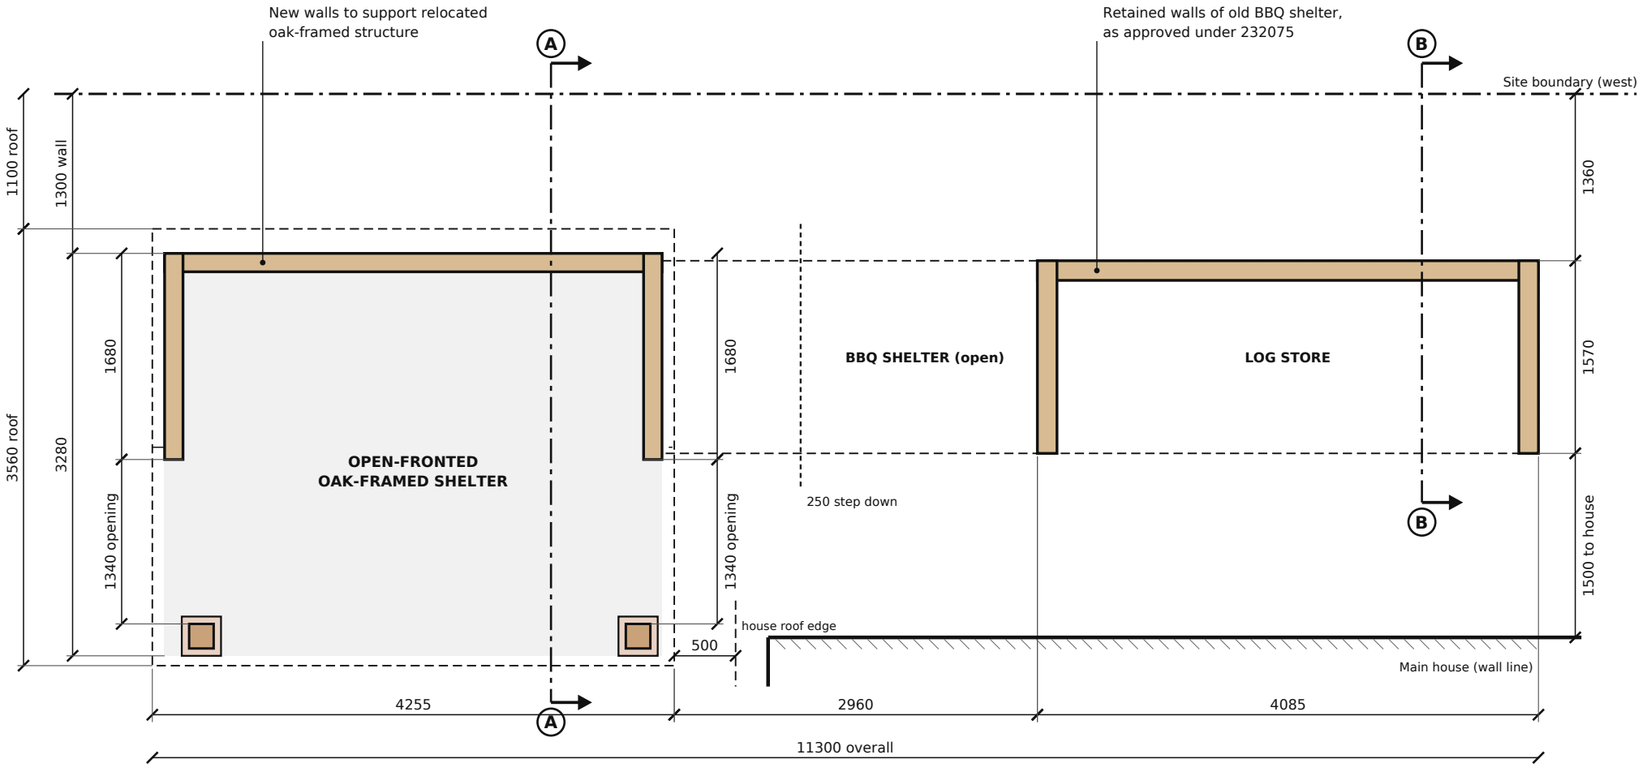

N

KEY

- Walls (oak clad)
- Brick plinth with oak post
- Roof outline over
- Site boundary

SCALE BAR 1:50

0 1 2 3 4 5 m

NOTES

1. All dimensions in millimetres unless stated otherwise.
2. Oak frame (approved under 052657) relocated; open to east; 1340 mm openings between side walls and oak posts.
3. Continuous 50 mm flat roof over BBQ shelter and log store.
4. Log store: walls retained from existing BBQ shelter (232075).
5. Ground falls 250 mm from oak frame towards log store.
6. West boundary: 1300 mm from oak frame wall, 1100 mm from roof edge; 1360 mm from log store wall.
7. Sections A–A and B–B shown on drawing ATC-GS-06.

PROJECT Retention of relocated oak-framed garden shelter, link roof and rear hardstanding		
SITE Apple Tree Cottage, Church Lane, Arborfield, Reading RG2 9JA		
CLIENT Mr & Mrs L Haughton		
DRAWING Garden Shelter – Plan (As Built)		
SCALE 1:50 @ A3	**DATE** 31.10.26	**DRAWN** LH
DRAWING No. **ATC-GS-05**	**REV** **D**	**STATUS** **PLANNING**