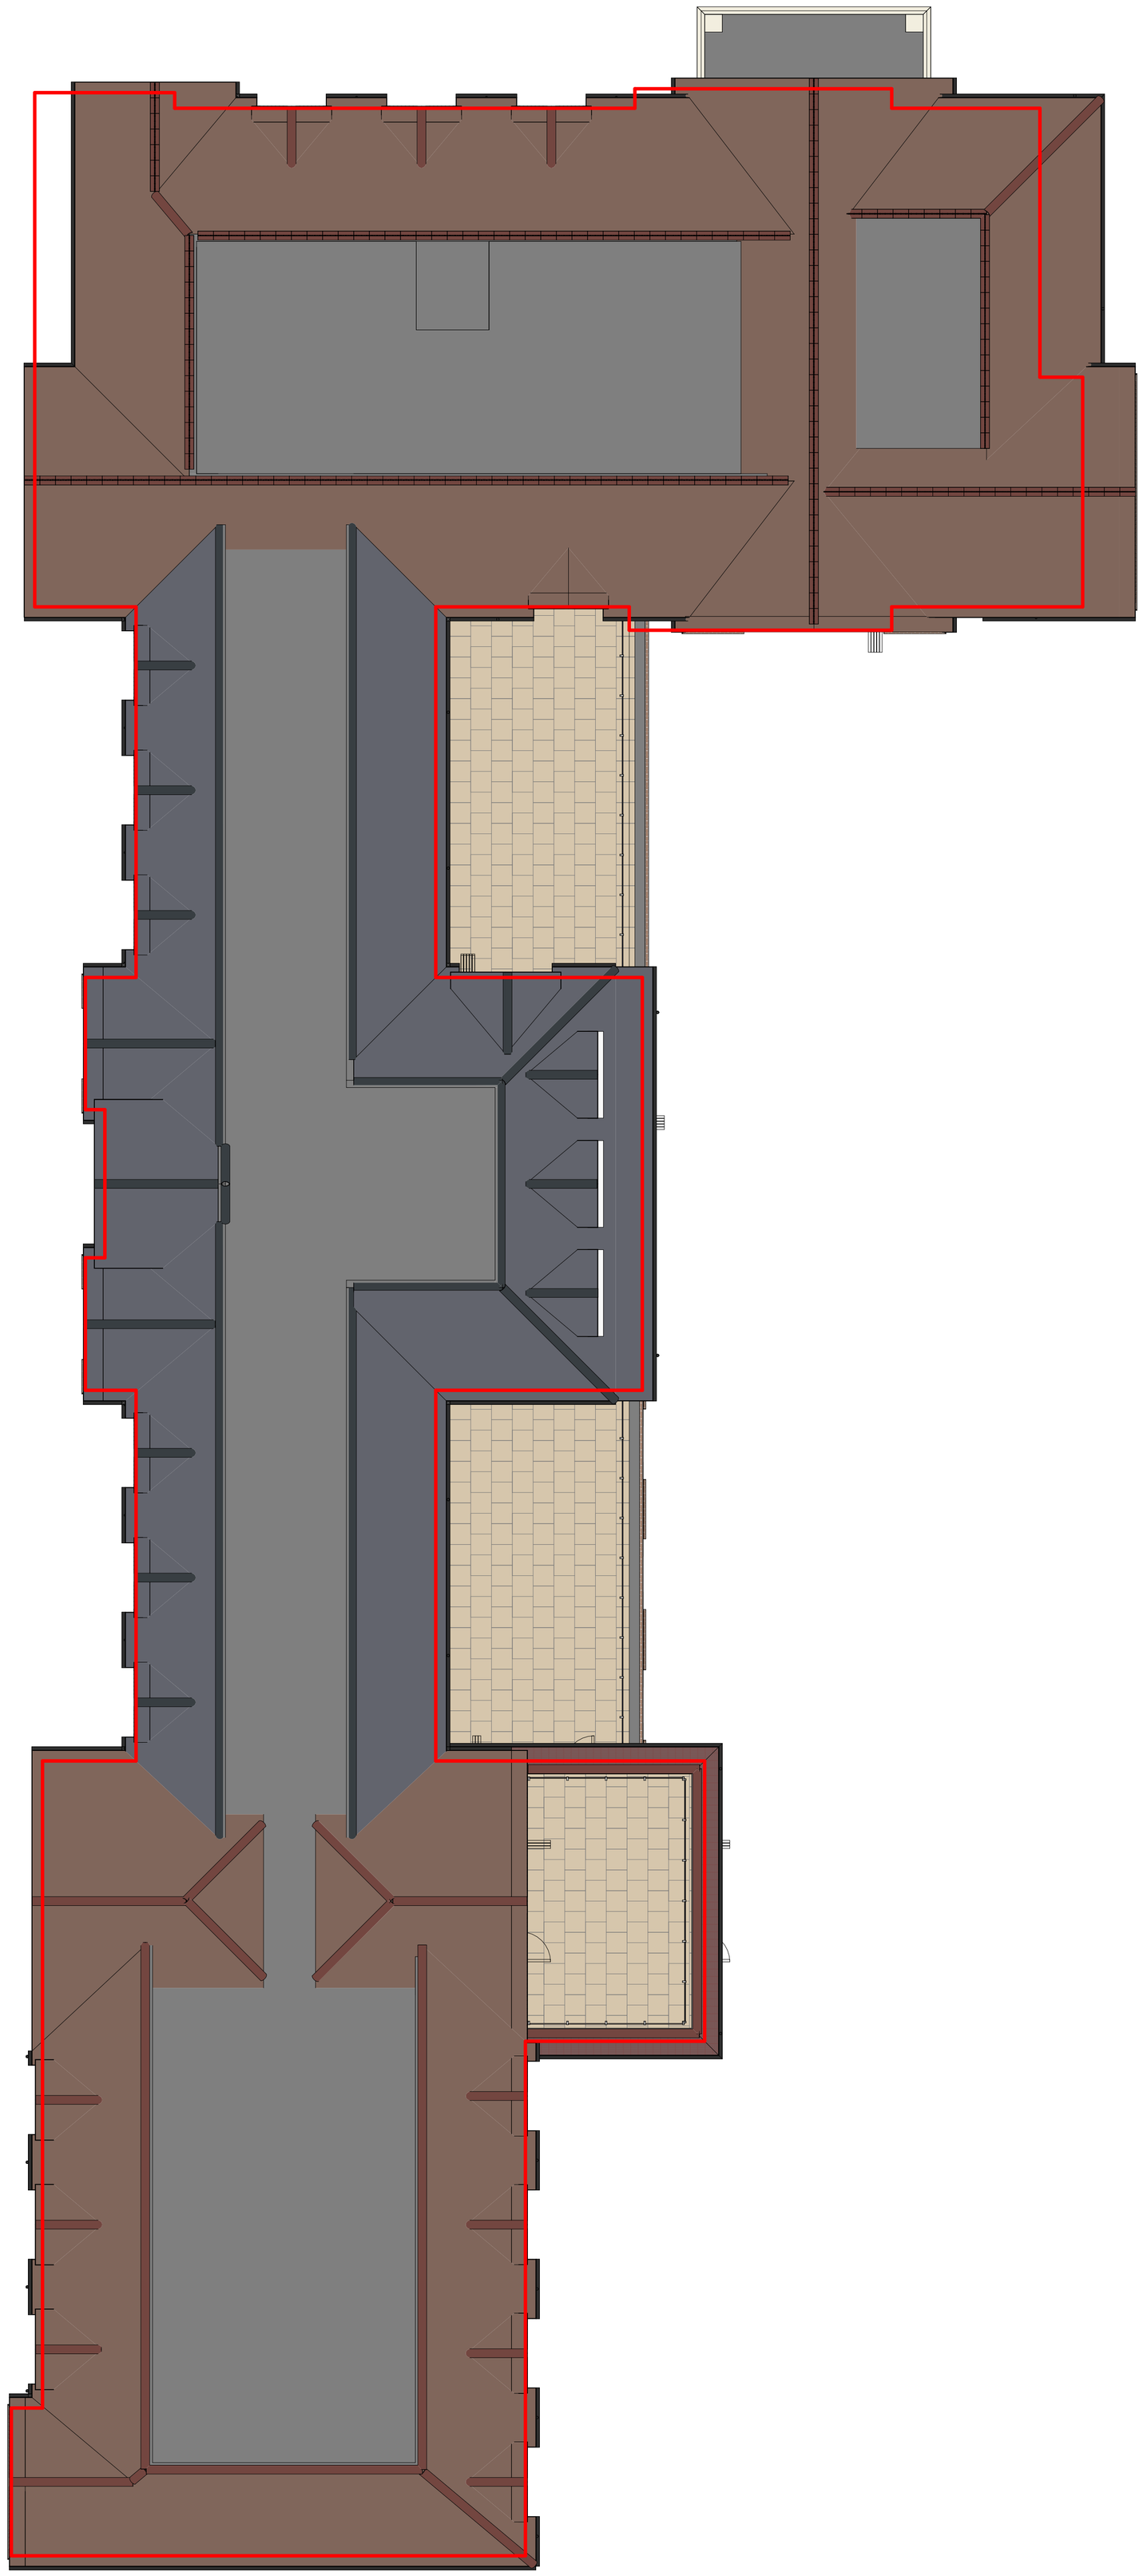


Key

Red line denotes outline of approved scheme (Planning Application Number: 233168)

REV	DESCRIPTION	BY	DATE

RM Design Group,
Unit 16 Escrick Business Park,
York,
North Yorkshire,
YO19 6FD

Web - www.rmdesigngroup.co.uk
Email - info@rmdesigngroup.co.uk
Tel - 01904 233539

NOTE:

ALL DIMENSIONS TO BE VERIFIED ON SITE PRIOR TO THE COMMENCEMENT OF ANY WORK OR THE PRODUCTION OF ANY SHOP DRAWING. ALL DISCREPANCIES TO BE REPORTED TO RM DESIGN GROUP.

THIS DRAWING IS TO BE READ IN CONJUNCTION WITH ALL RELATED ARCHITECTS AND ENGINEERS DRAWINGS AND ANY OTHER RELEVANT INFORMATION

THIS DRAWING IS COPYRIGHT © OF RM DESIGN GROUP.

CLIENT

Boutique Care Homes

PROJECT

Woodley Green

DRAWING TITLE

Proposed Roof Plan

DRAWING STATUS

PLANNING

SCALE AT A1:	DATE:	DRAWN:	CHECKED:
1 : 100	06/08/24	RM	Checker
PROJECT NO: **B01-06**	DRAWING NO:. **034**		REVISION:

0m 2m 4m 6m 8m 10m

VISUAL SCALE 1:100