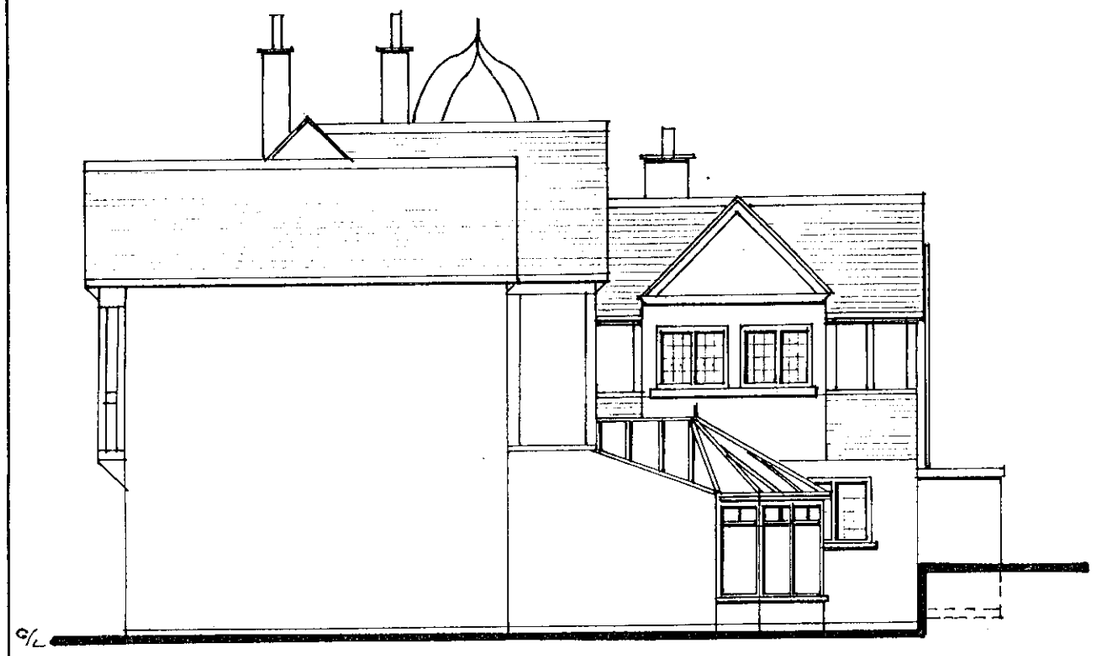

Side Elevation (S)

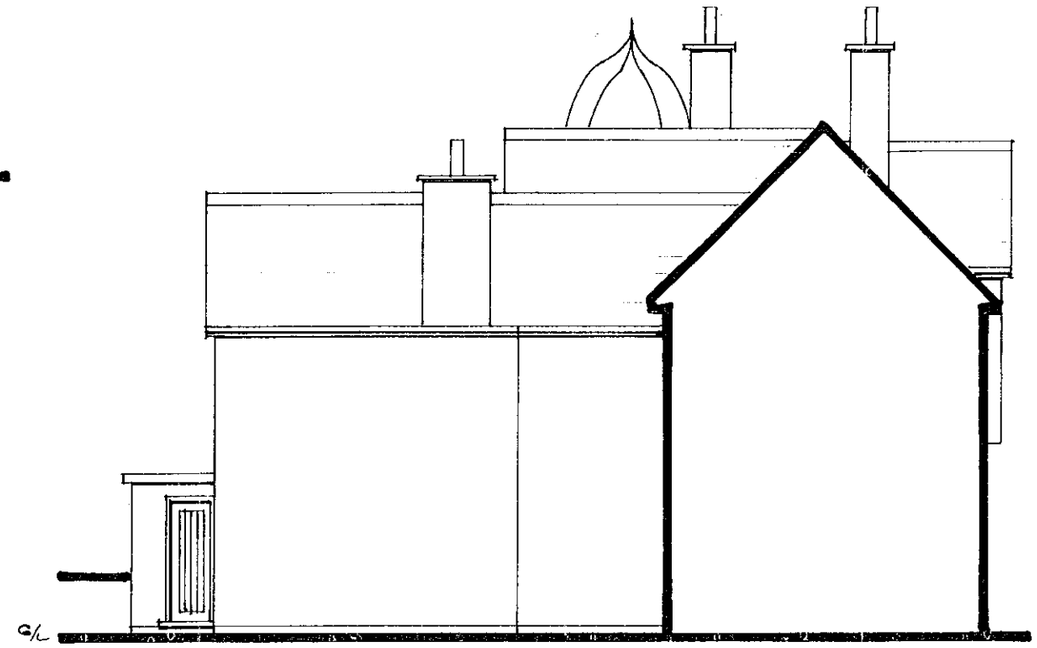

Side Elevation (N)



Rear Elevation

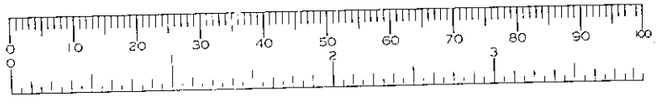

Note :
All dimensions must be checked on site and not scaled from this drawing.

20.NOV.2000* 2847

A		
	Date	Revision

© copyright

BOUCHER ASSOCIATES
CHARTERED SURVEYORS
CLIFTON HOUSE, 83 NEW ROAD
ASCOT
BERKSHIRE SL5 8PZ
TEL: 01344 883639

Client
Mr. N. Towers

Job Title
63 High Street
Wargrave
Berks.

APPROVED

Drawing Title
Existing Elevations

Scale 1 :100

Date Oct '00 Drawn by

Drg. No. 00 / 293 / 20 Rev.

Front elevation unaltered

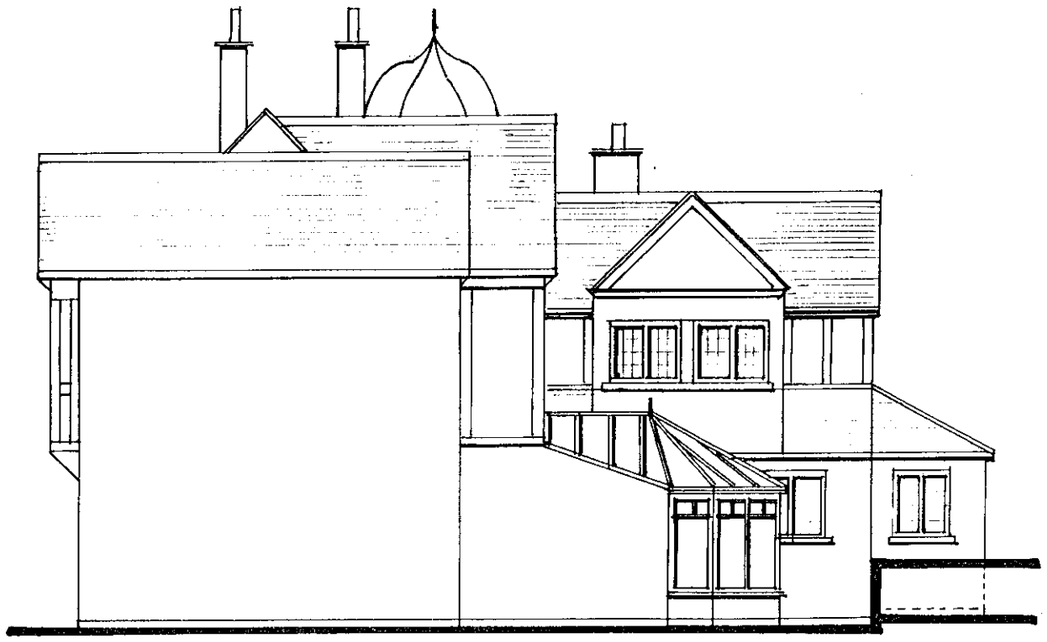

Side Elevation (S)

New Utility

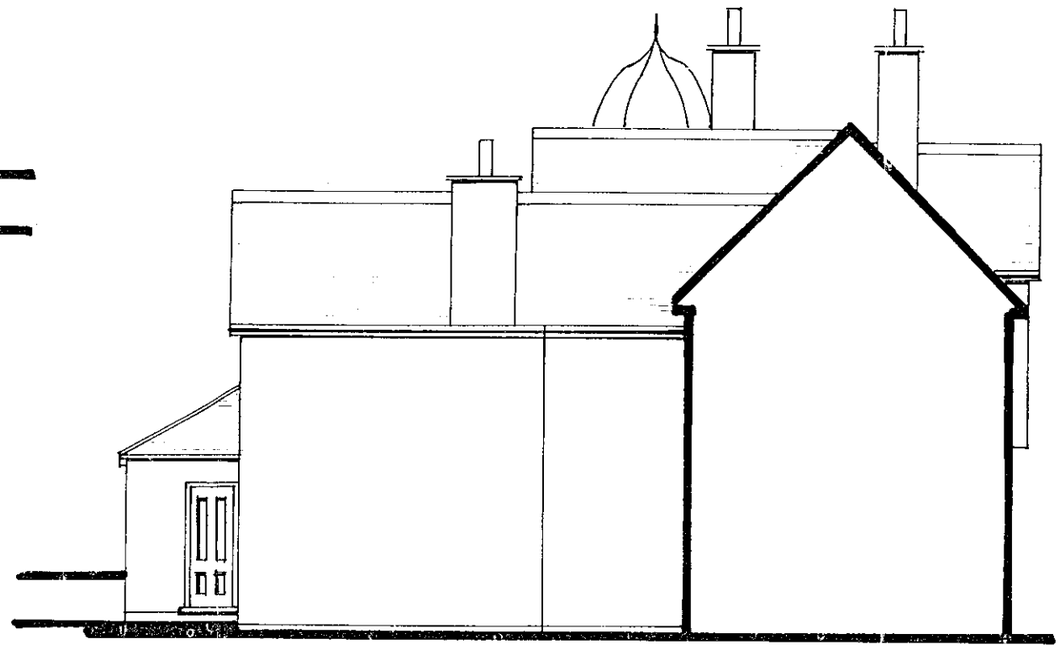

New Utility

Side Elevation (N)



New Utility

Rear Elevation

0 10 20 30 40 50 60 70 80 90 100

Note :
All dimensions must be checked on site and not scaled from this drawing.

A		
	Date	Revision

© copyright

BOUCHER ASSOCIATES
CHARTERED SURVEYORS
CLIFTON HOUSE, 83 NEW ROAD
ASCOT
BERKSHIRE SL5 8PZ
TEL: 01344 883639

Client

Mr. N. Towers

Job Title

63 High Street
Wargrave
Berks

APPROVED

Drawing Title

Proposed Elevations

Scale 1 : 100

Date oct'00. Drawn by

Drg. No. 00 / 293 / 21 Rev.

REPROPOINT 2589

ARCHITECTURAL 420x297 A3

CD 2/3/01

Note :
All dimensions must be checked on site
and not scaled from this drawing.



A	Nov 00.	Roofroom relayed
	Date	Revision

© copyright

BOUCHER ASSOCIATES
Chartered Surveyors
Clifton House
83 New Road
Ascot
Berks. SL5 8PZ

Tel: 01344 883639
Fax: 01344 893639

Client

M:. N. Towers

Job Title 20.NOV.2000 2547

63 High Street

Wargrave

Berks.

Drawing Title

Proposed Ground Floor

Scale 1 :50

Date Aug 00 | Drawn by

Drg. No. 00 / 293 / 03 | Rev. A

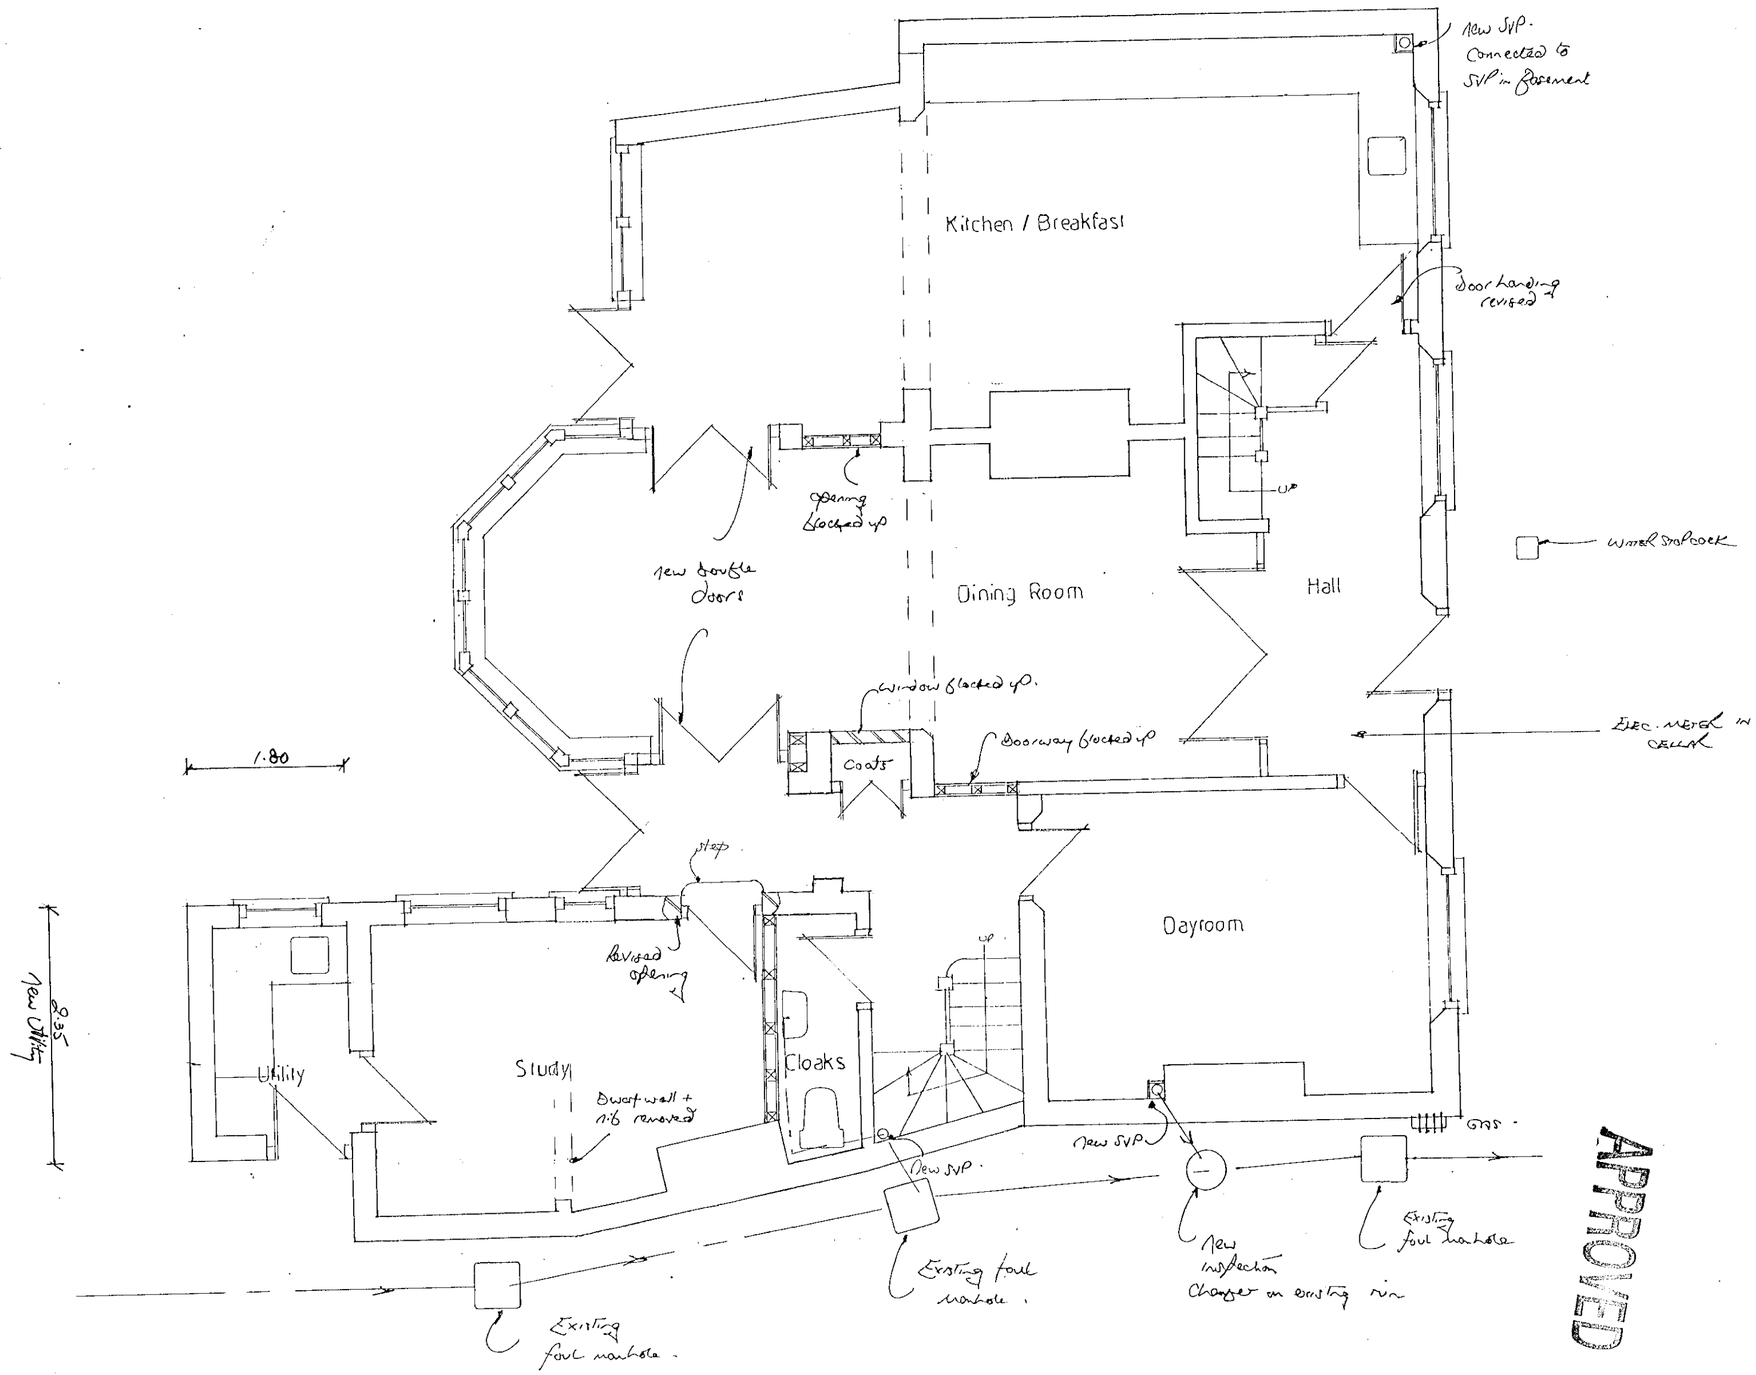

AS BUILT

2/3/01

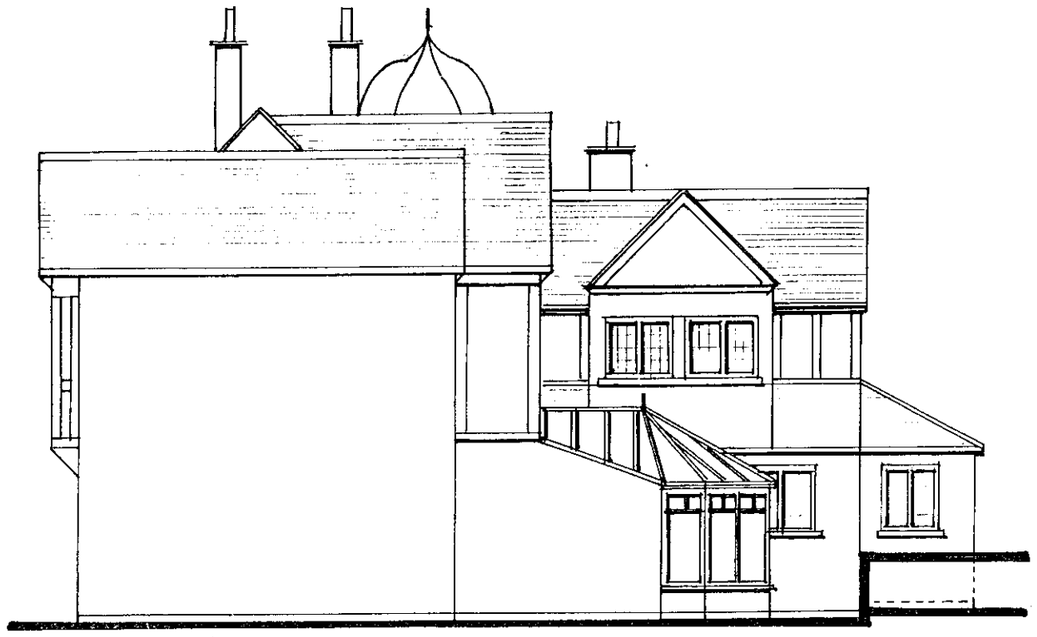

Side Elevation (S)

New Utility

Front elevation unaltered

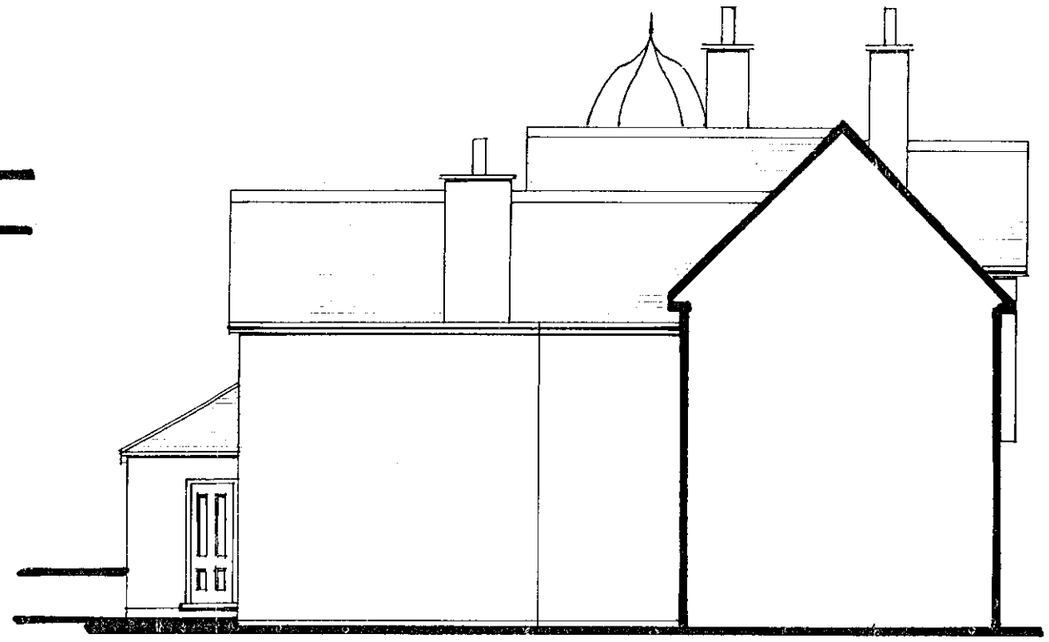

New Utility

Side Elevation (N)



New Utility

Rear Elevation

0 10 20 30 40 50 60 70 80 90 100

0 2 3

Note :
All dimensions must be checked on site and not scaled from this drawing.

20. NOV. 2000 2847

A		
	Date	Revision

© copyright

BOUCHER ASSOCIATES
CHARTERED SURVEYORS
CLIFTON HOUSE, 83 NEW ROAD
ASCOT
BERKSHIRE SL5 8PZ
TEL: 01344 883639

Client
Mr. N. Towers

Job Title
63 High Street
Wargrave
Berks

Drawing Title
Proposed Elevations

Scale 1 : 100

Date oct'00. Drawn by DB.

Drg. No. 00 / 293 / 21 Rev.

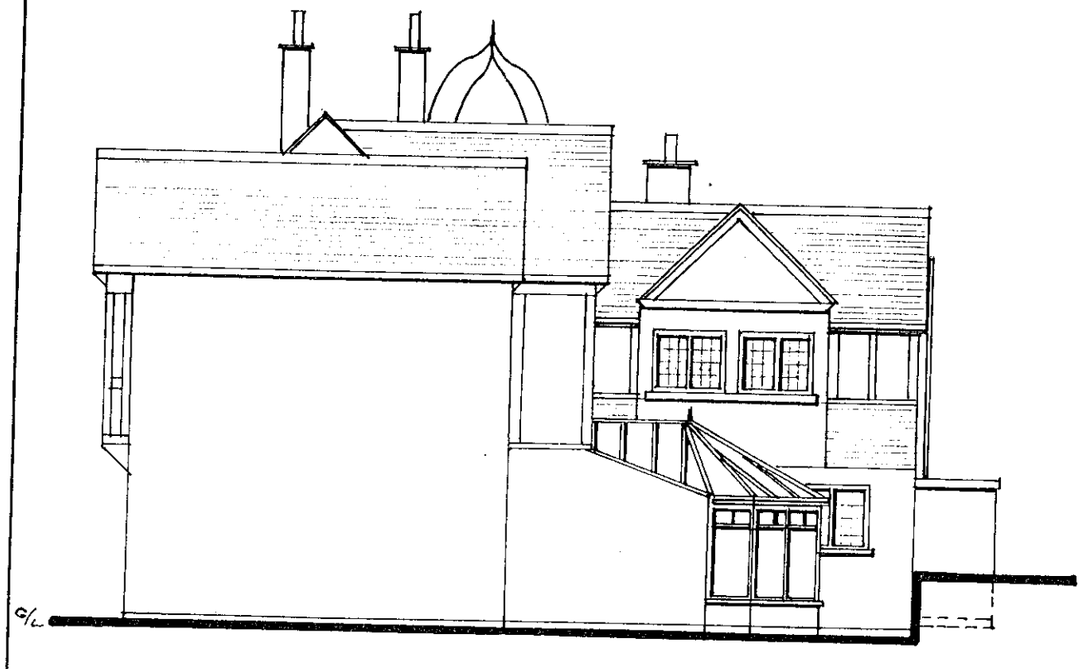

Side Elevation (S)

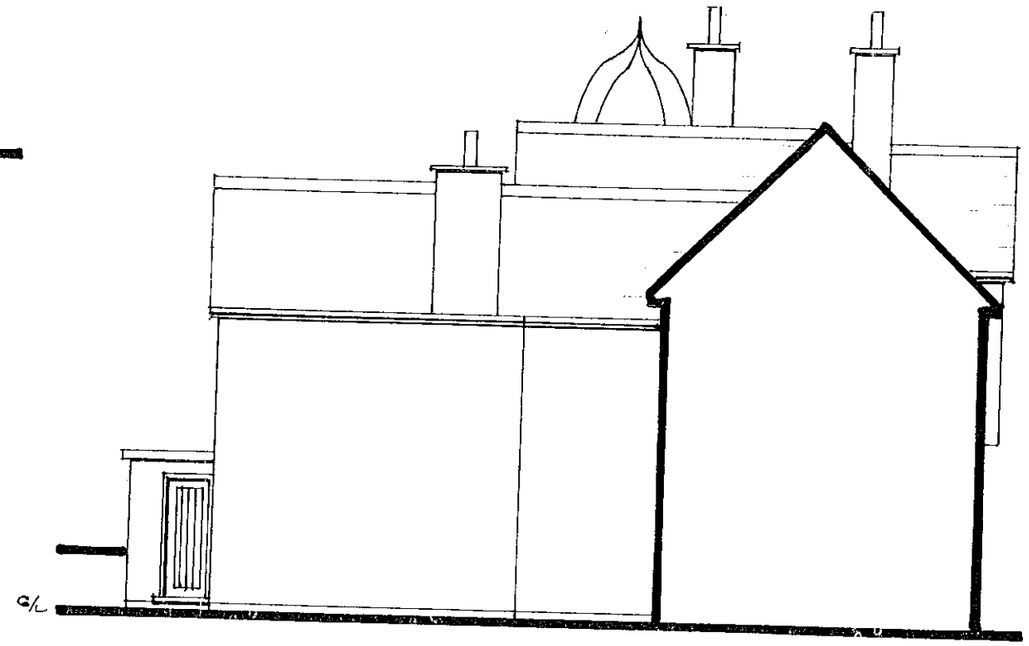

Side Elevation (N)



Rear Elevation

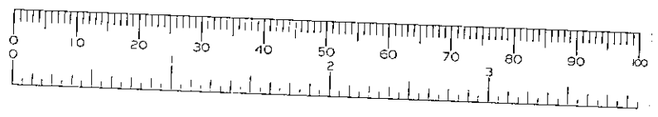

Note :
All dimensions must be checked on site and not scaled from this drawing.

20.NOV.2000* 2847

PLANNING SERVICES
POL
DC
APP
CS
COPIES

A		
	Date	Revision

© copyright

BOUCHER ASSOCIATES
CHARTERED SURVEYORS
CLIFTON HOUSE, 83 NEW ROAD
ASCOT
BERKSHIRE SL5 8PZ
TEL: 01344 883639

Client
Mr. N. Towers

Job Title
63 High Street
Wargrave
Berks.

Drawing Title
Existing Elevations

Scale 1:100

Date OCT '00 | Drawn by BB

Drg. No. 00 / 293 / 20 | Rev.

REPROPOINT 2589

Note :
All dimensions must be checked on site
and not scaled from this drawing.

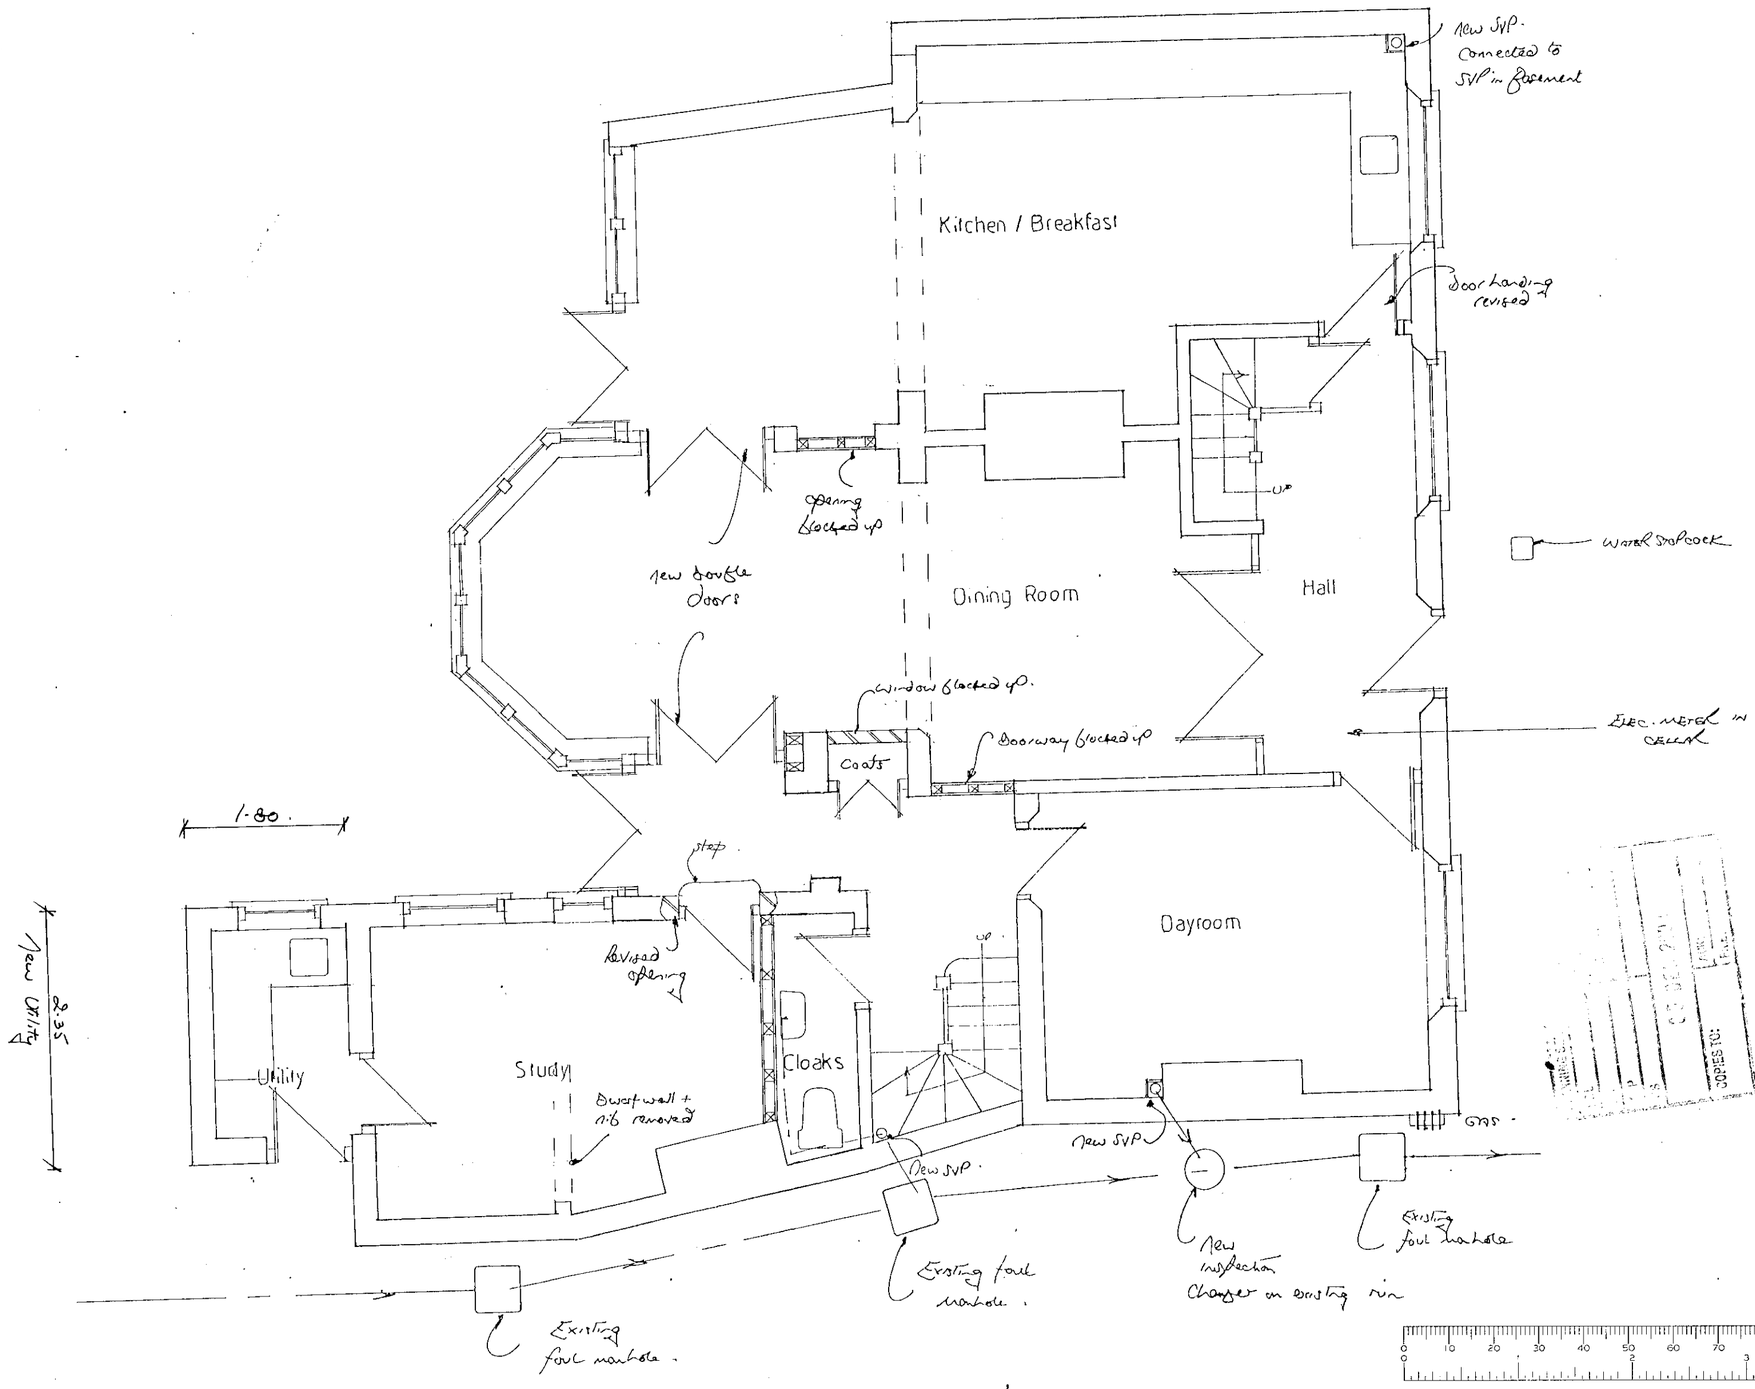

A	Nov 00.	Croudroom revised
	Date	Revision

© copyright

BOUCHER ASSOCIATES
Chartered Surveyors
Clifton House
83 New Road
Ascot
Berks. SL5 8PZ

Tel: 01344 883639
Fax: 01344 893639

Client

M:. N. Towers

Job Title

63 High Street 26.NOV.2000 2547
Wargrave
Berks.

Drawing Title

Proposed Ground Floor

Scale 1:50

Date Aug 00 | Drawn by

Drg. No. 00 / 293 / 03 | Rev. A

ARCHITECTURAL 420 x 594mm A2.

REPROPOINT 2577

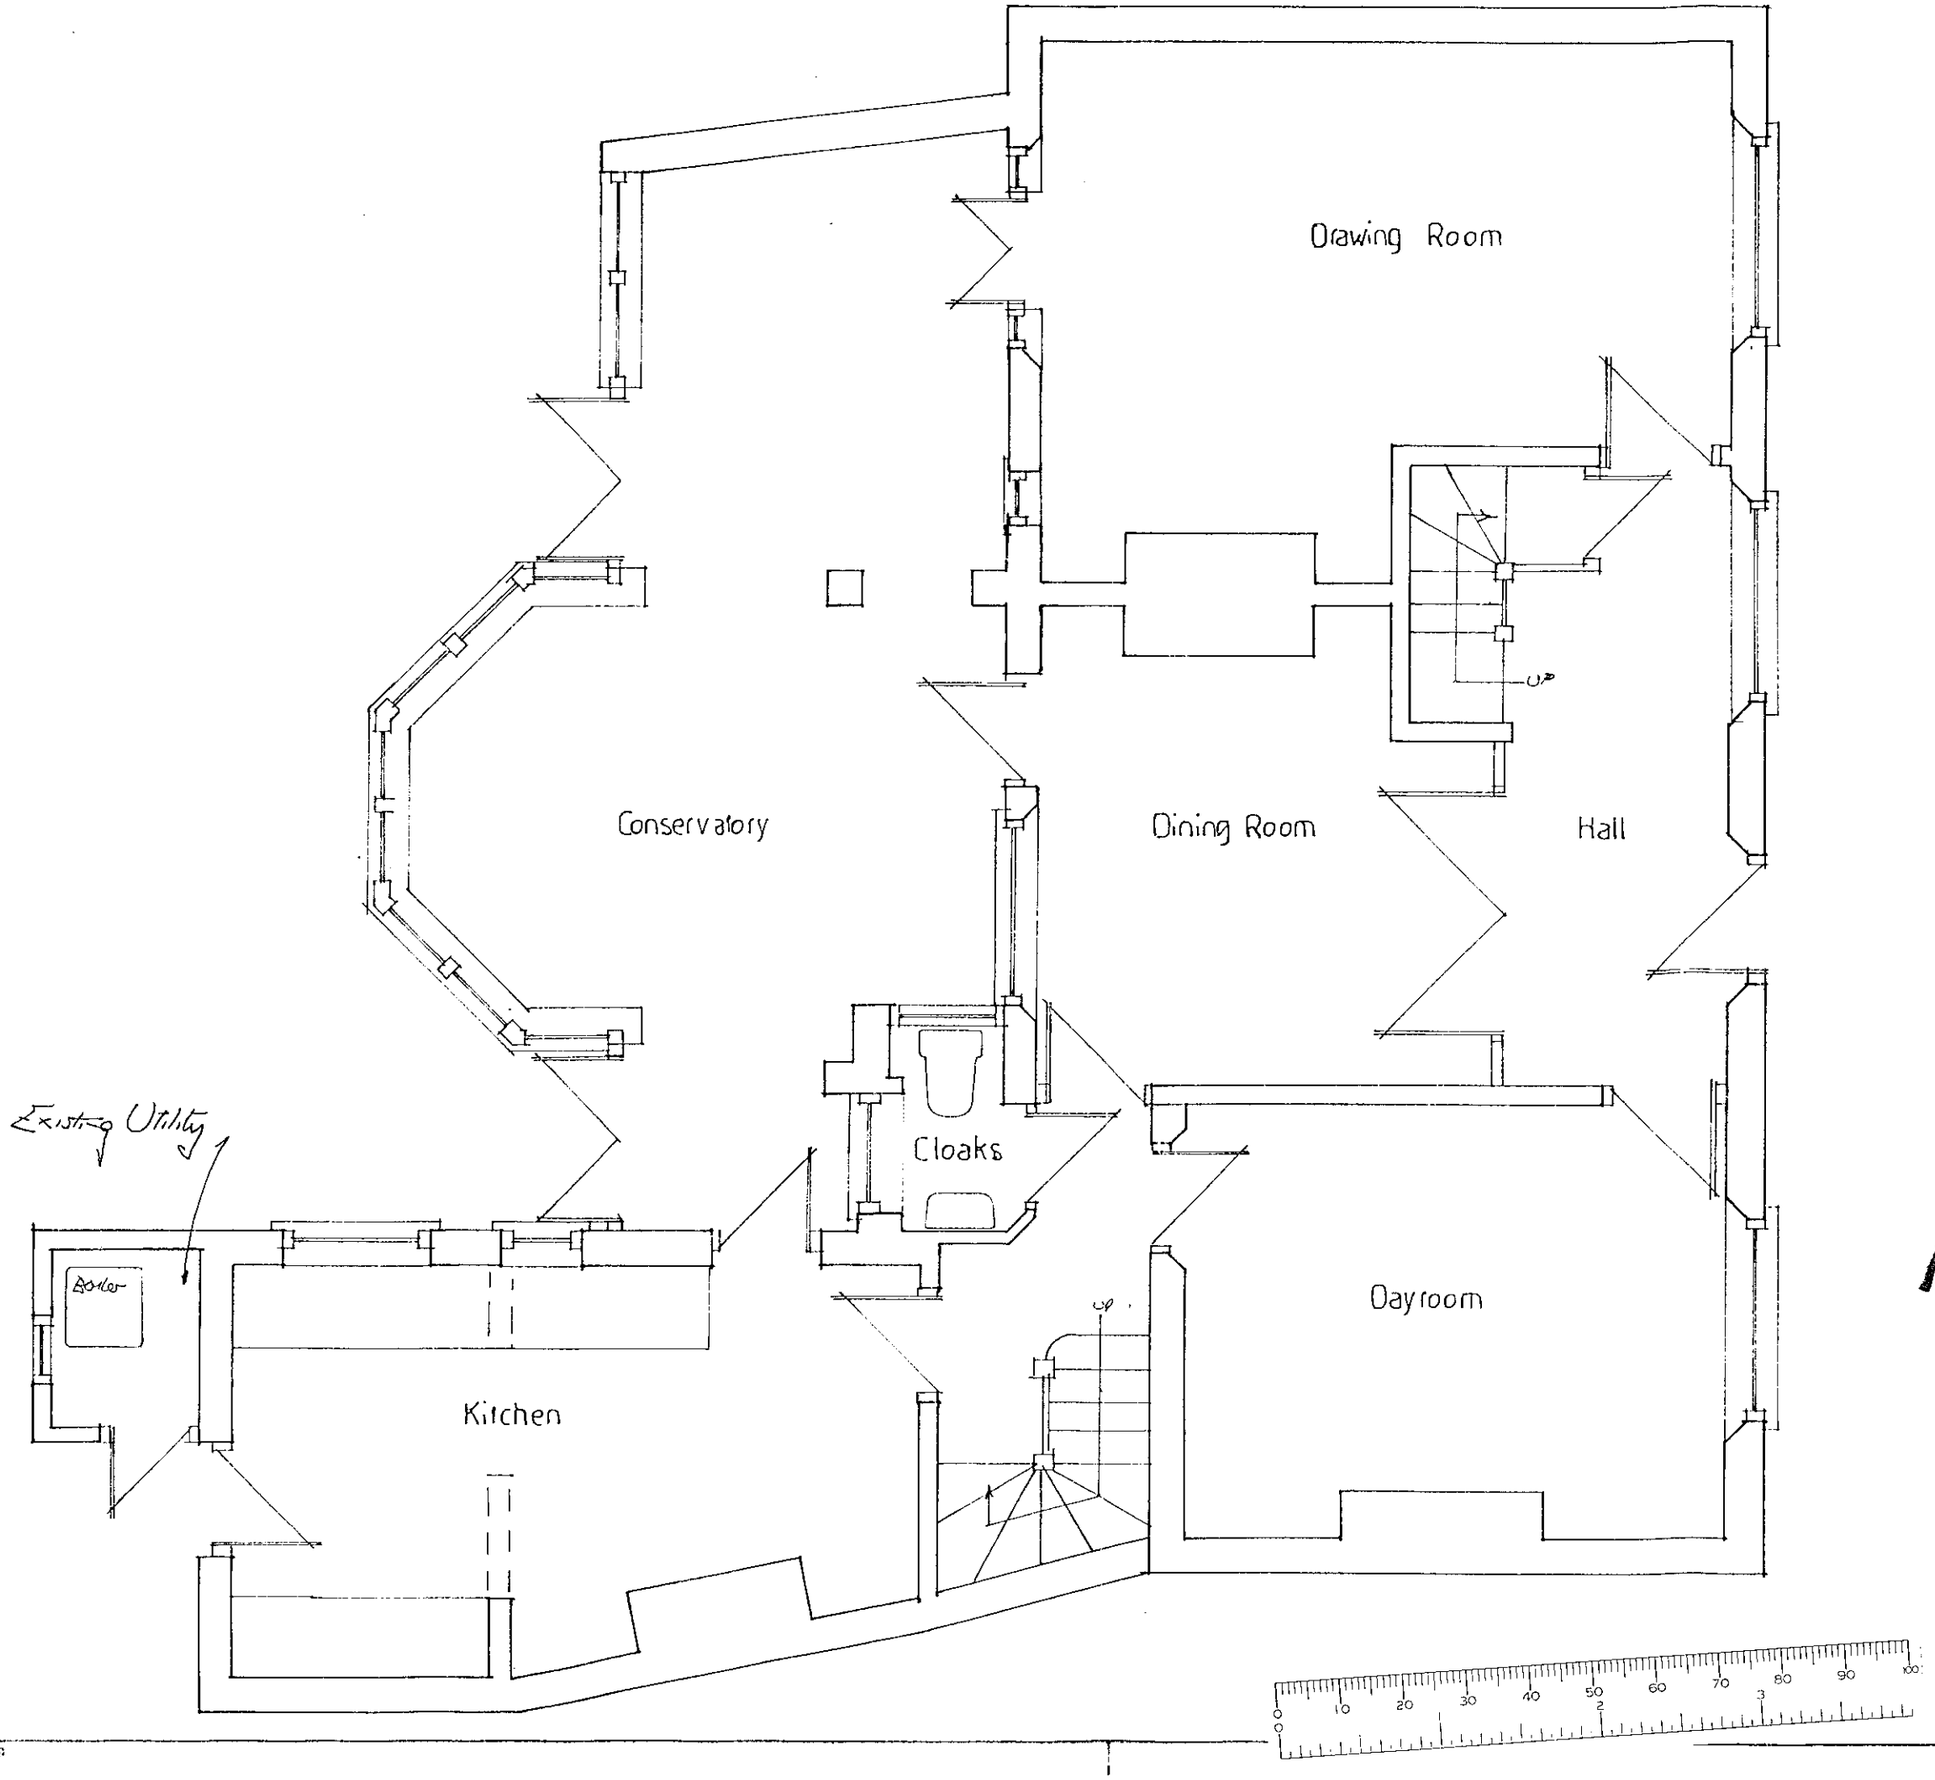

Note.
All dimensions must be checked on site and not scaled from this drawing.

20.NOV.2000* 2847

7

A		
	Date	Revision

© copyright

BOUCHER ASSOCIATES
CHARTERED SURVEYORS
CLIFTON HOUSE, 83 NEW ROAD
ASCOT
BERKSHIRE SL5 8PZ
TEL: 01344 883639

Client
Mr. N. Towers

Job Title
63 High Street
Wargrave
Berks.

APPROVED

Existing Ground Floor

Scale 1:50

Date Mar 00 | Drawn by

Drg. No 00 / 293 / 01 | Rev

REPROPOINT 2586

ARCHITECTURAL 420x297 A3