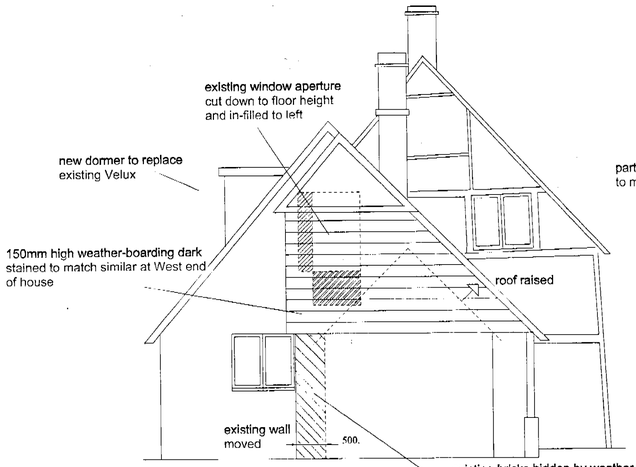


East Elevation

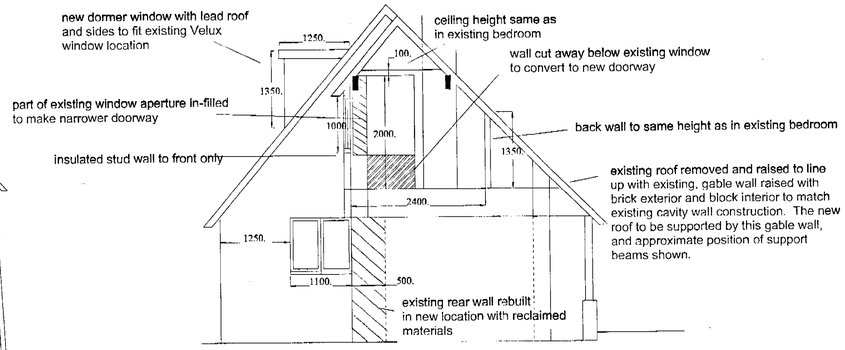


Section Through East Elevation
to Show Some Construction Detail



West Elevation




North Elevation (front)




South Elevation (rear)

DELEGATED

22.MAR2002* 6208

APPROVED

note:
The design of the proposed alterations have been discussed with WDC Conservation Architect and his comments and suggestions incorporated.

| rev. | description | date | drn. | chd. |
|---|---|---|---|---|
| D | | | | |
| C | | | | |
| B | | | | |
| A | First Issue | 11/3/02 | | |

**Keith Attfield**
The Old Cottage, Sandford, Reading, RG5 4TD
tel/fax: 0118 934 0848 email: keith@oldcottage.co.uk

circulation status:
if this box is empty, or not signed nor dated, information in drawing should be ignored

project:
Proposed New Bathroom
Above Existing Utility Room
at Old Cottage, Sandford

title:
Front, Rear and Side
Elevations

| paper size: | scale: | drawing no.: | revision |
|---|---|---|---|
| A1 | 1:50 | 2002/3 | A |

CD 19/9/02

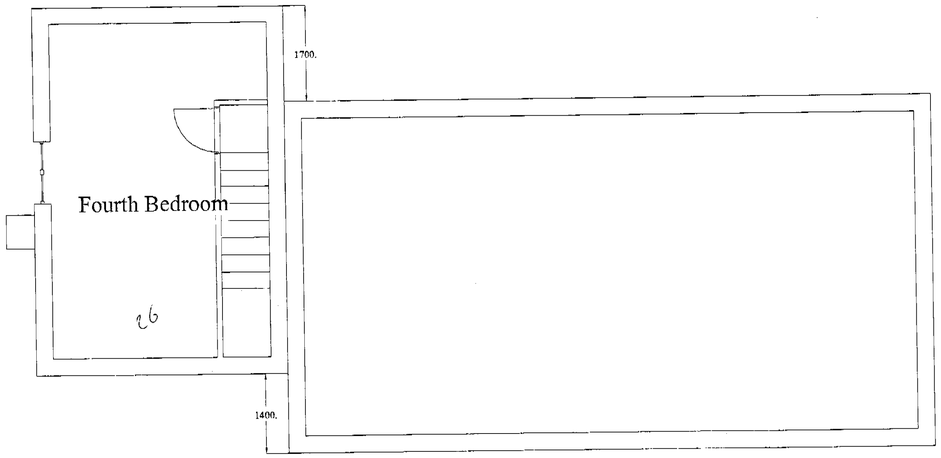


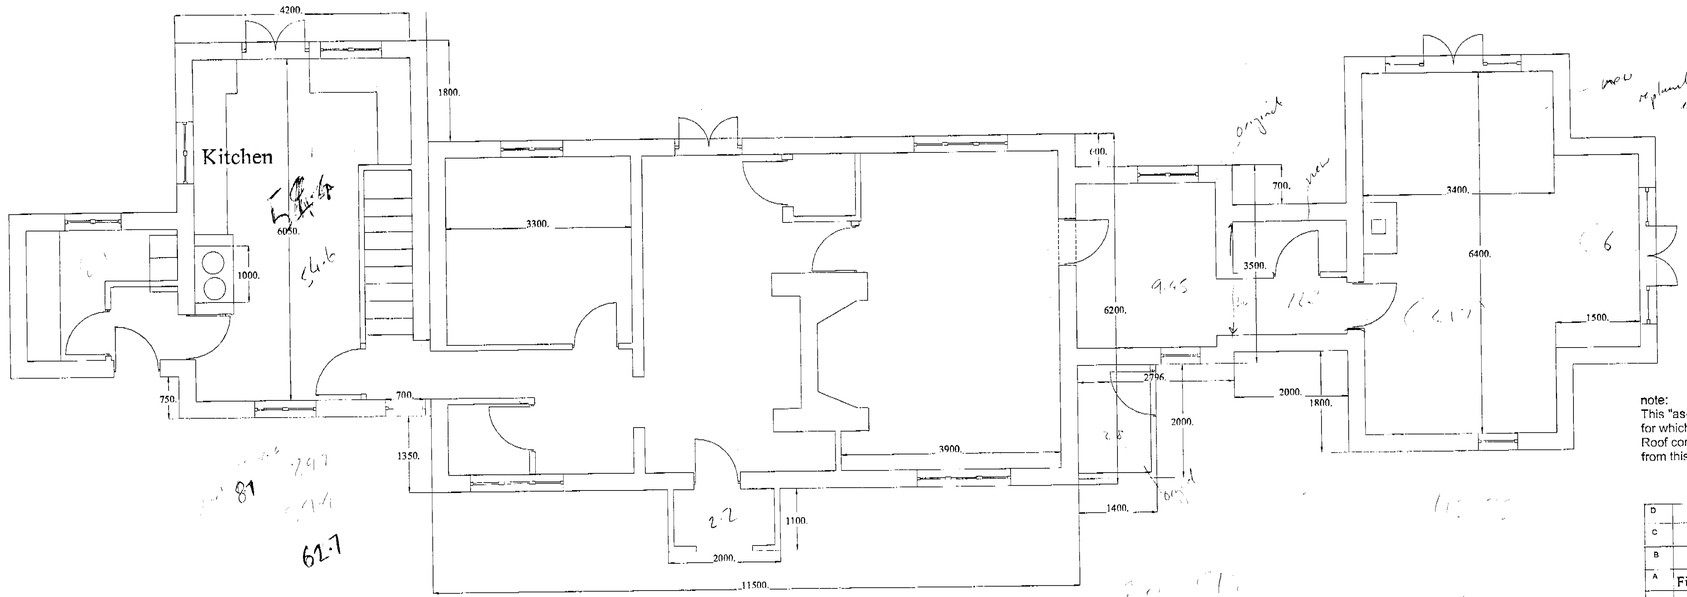


DELEGATED
22.MAR2002* 6208

note:
This "as-built" drawing is based on the drawing for which Listed Building Consent was gained. Roof construction detail has been removed from this drawing.

| | | | | |
|---|---|---|---|---|
| D | | | | |
| C | | | | |
| B | | | | |
| A | First Issue | | kca | 11/02/2002 |
| rev: | description | | dm. | chkd. |


**Keith Attfield**
The Old Cottage, Sandford, Reading, RG5 4TD
tel/fax: 0118 934 0848 email: keith@oldcottage.co.uk


| | |
|---|---|
| project: | Existing Old Cottage<br>Sandford |
| title: | Plan Views |
| paper size: | A1 |
| scale: | 1:50 |
| drawing no.: | 2002/2 |
| revision | A |



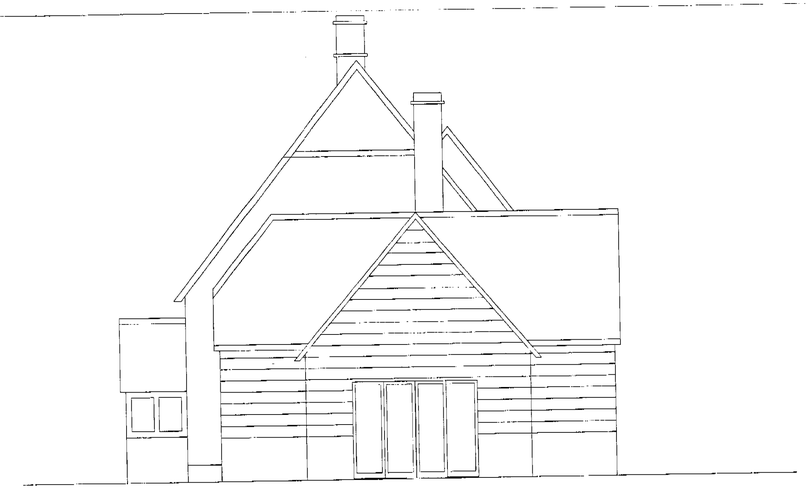






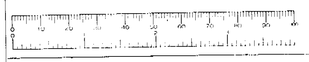

DELEGATED

22.MAR2002 6208

note:
This "as-built" drawing is based on the drawing for which Listed Building Consent was gained. Roof construction detail has been removed from this drawing.

| rev. | description | date | drn. | chkd. |
|---|---|---|---|---|
| D | | | | |
| C | | | | |
| B | | | | |
| A | First Issue | 10/3/2002 | kca | |

**Keith Attfield**
The Old Cottage, Sandford, Reading, RG5 4TD
tel/fax: 0118 934 0848 email: keith@oldcottage.co.uk

circulation status:
if this box is empty, or not signed nor dated, information in drawing should be ignored

project:
Existing Old Cottage
Sandford

title:
Front, Rear and Side Elevations

| master size | scale: | drawing no.: | revision |
|---|---|---|---|
| A1 | 1:50 | 2002/1 | A |