


PROPOSED ELEVATIONS

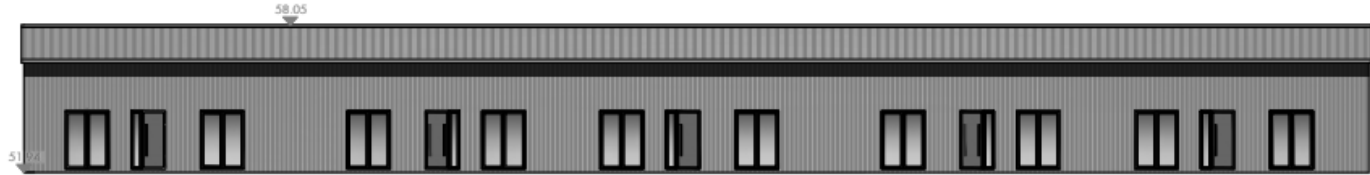

FRONT ELEVATION (South)




SIDE ELEVATION (West)



SIDE ELEVATION (East)




REAR ELEVATION (North)

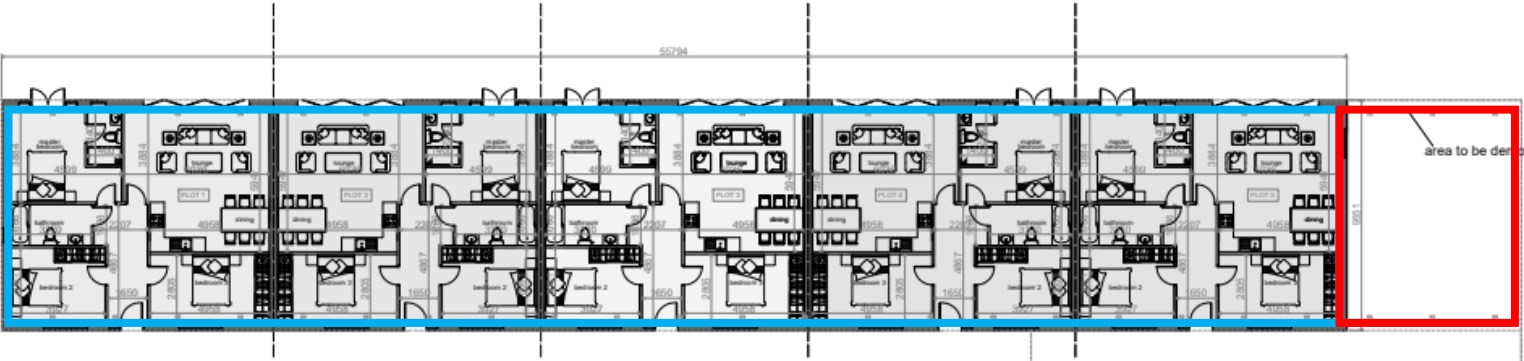

PROPOSED GROUND FLOOR PLAN

- PLOT 1 - 95.01m²
- PLOT 2 - 95.01m²
- PLOT 3 - 95.01m²
- PLOT 4 - 95.01m²
- PLOT 5 - 95.01m²

BUILDING A

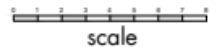

PDP markup 07/10/25
Residential area – 475.05sqm
Demolition GIA – 62.5sqm

IMPORTANT NOTE; DRAWING INFORMATION BASED ON ORIGINAL IMAGEON DESIGN LTD. PLANS FOR ILLUSTRATION PURPOSES ONLY NO COPYRIGHT CLAIMED

Drawing title	Proposed floor plans and elevations BUILDING A
Project	Proposed barn conversion to form 3 new residential dwellings
Address	Old Chapel Farm, Post Lane, Walsley, B67 1BU
Client	
Scale	1:100
Date	July 2024
Drawing Number	GP02/24
Architectural details	