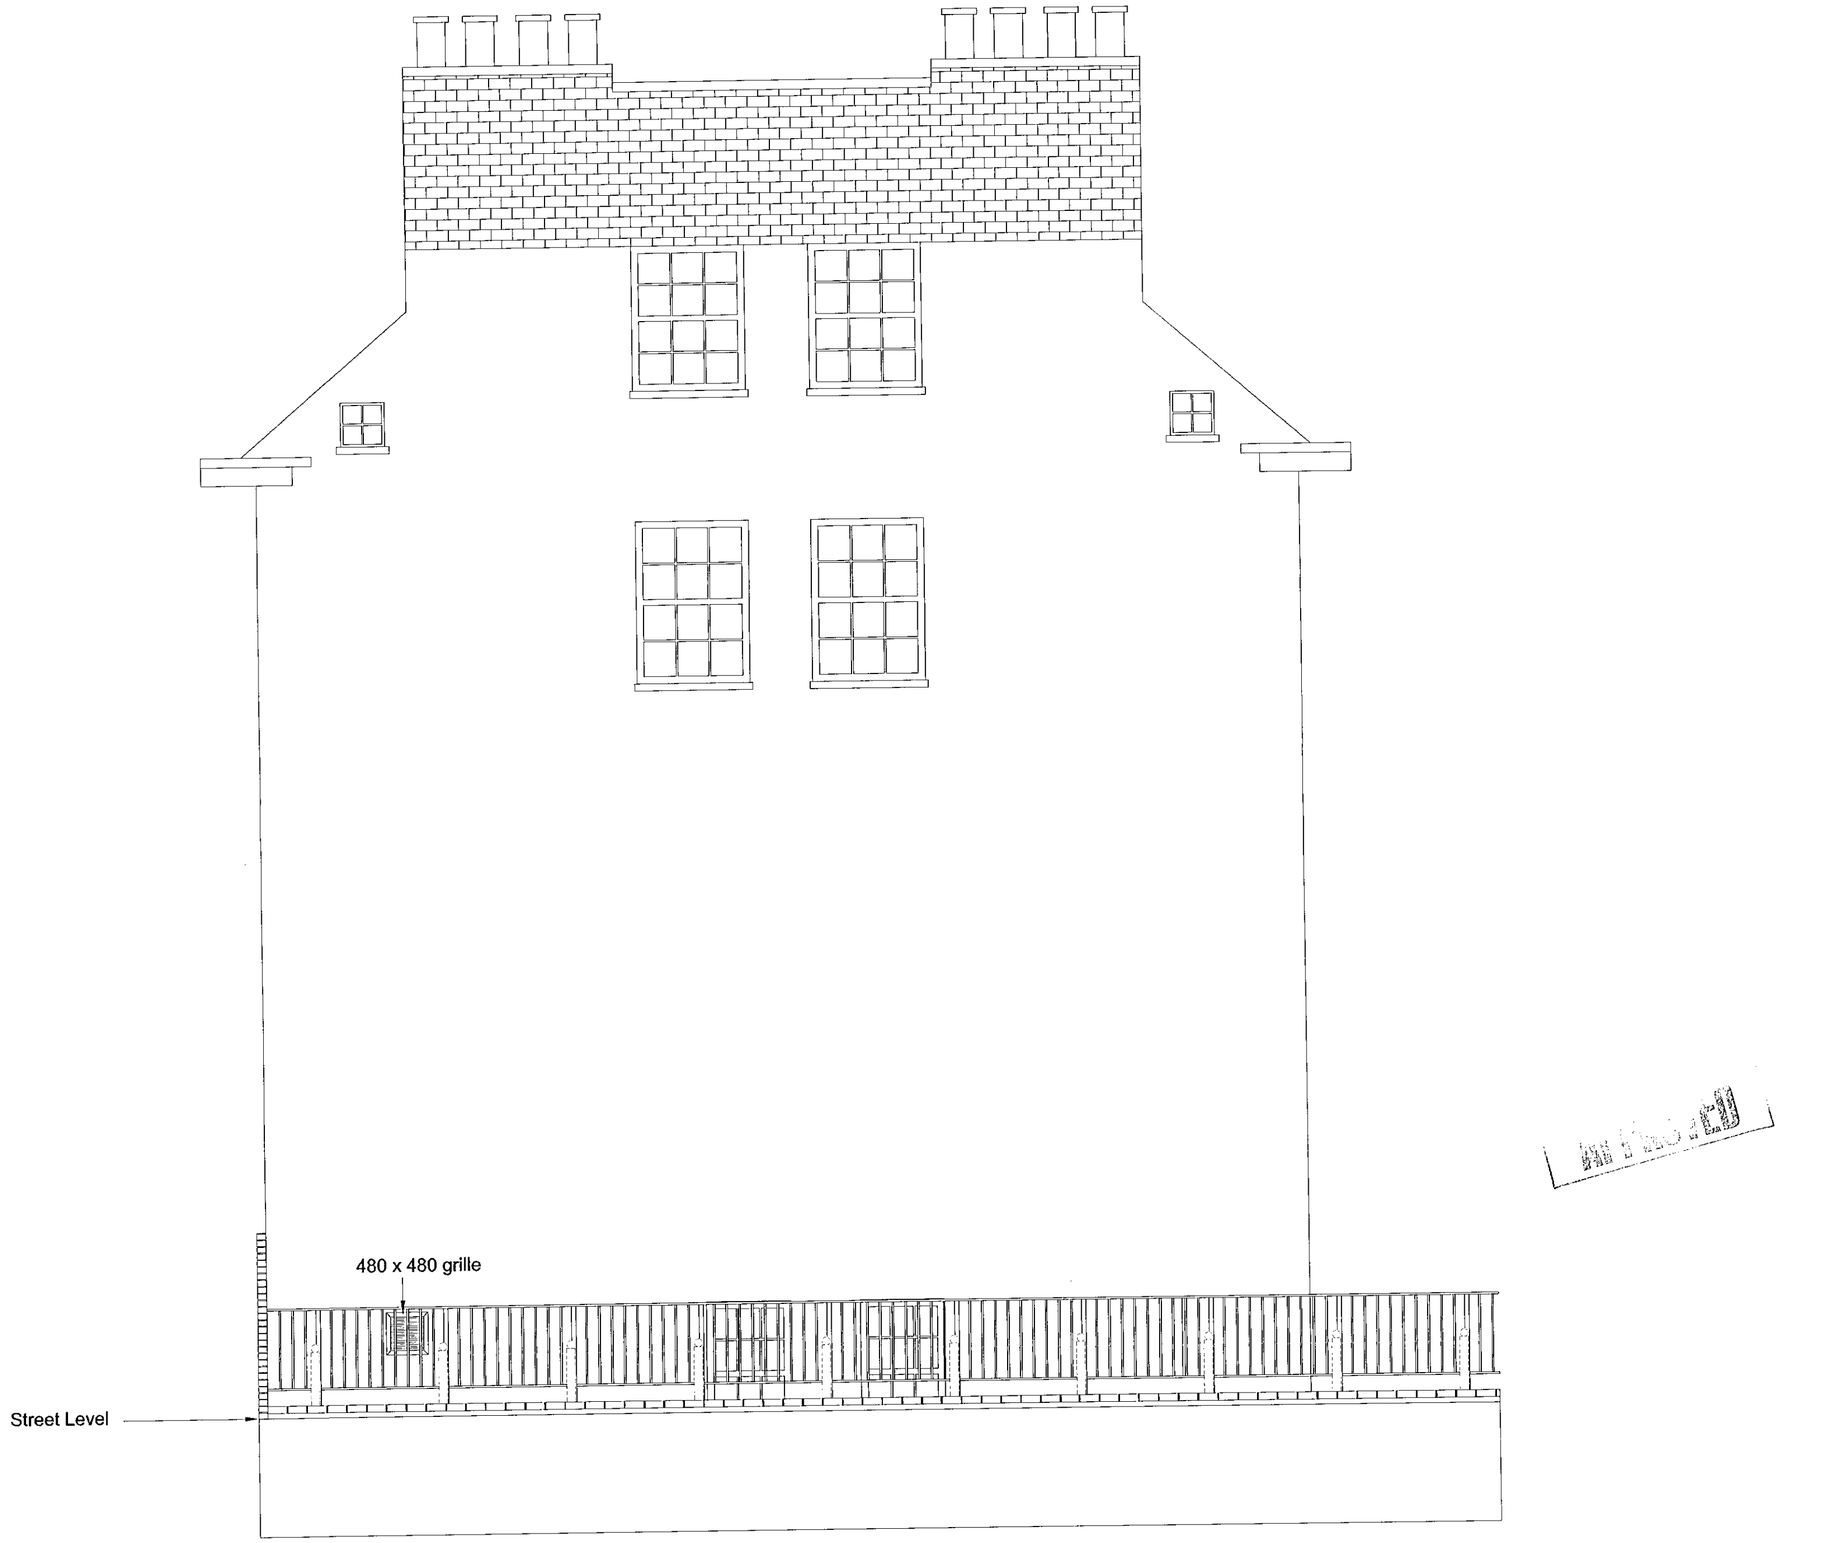

NOTE:

This drawing is protected under Copyright and at no time should any portion of this drawing be reproduced or copied without the permission of Morgan Lovell.

Please note all sub-contractors drawings are subject to approval by Morgan Lovell or their consultants.

For the avoidance of doubt, we wish to clarify that all designs and any costings derived from them, is subject only to all reasonable skill and care.

Do not scale from this drawing, check dimensions on site. Subject to statutory approval & Site survey.

Building outline taken from drawings provided.

Rev	Revision & Date	By	DC No.

Status

= Preliminary/Information	= Approval/Comment
= Contract	= As Built
= Construction	= Building Control

Designed by / drawn by	Checked by / date
HL	SG

MORGAN LOVELL
THE WORKPLACE SPECIALIST®

Morgan Lovell
Ascot House, Fitzmaurice Road,
Wokingham, Berks RG10 2NW
Telephone: 0118 989 5300 Fax: 0118 989 5301
Email: contact@morganlovell.co.uk
http://www.morganlovell.co.uk

FS13724

Client

ATTACHMATE

Project

MARKHAM HOUSE
20 BROAD STREET
WOKINGHAM

Drawing

AS BUILT
SIDE ELEVATION - GRILLE

Scale	Date
1:50	25.04.00

Project no	Sequential	Bldg/Floor	Detail	Rev
A9115	-	2/0	GRL	.

Document Reference ..... D-REV-0 Size = A2

APPROVED

28.APR.2000* 1297

NOTE:

This drawing is protected under Copyright and at no time should any portion of this drawing be reproduced or copied without the permission of Morgan Lovell.

Please note all sub-contractors drawings are subject to approval by Morgan Lovell or their consultants.

For the avoidance of doubt, we wish to clarify that all designs and any costings derived from them, is subject only to all reasonable skill and care.

Do not scale from this drawing, check dimensions on site. Subject to statutory approval & Site survey.

Building outline taken from drawings provided.

ALL NEW CUPBOARDS TO BE 1650 HIGH

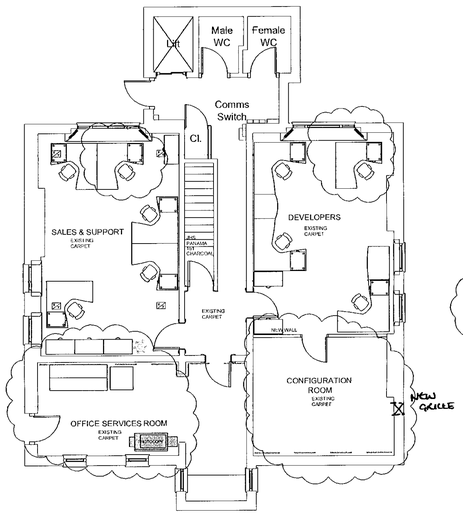

Lower Ground Floor

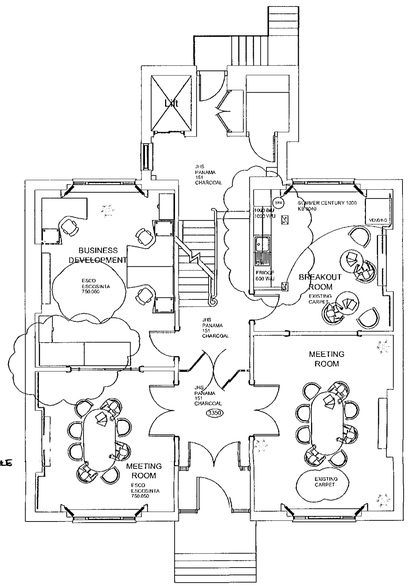

Upper Ground Floor

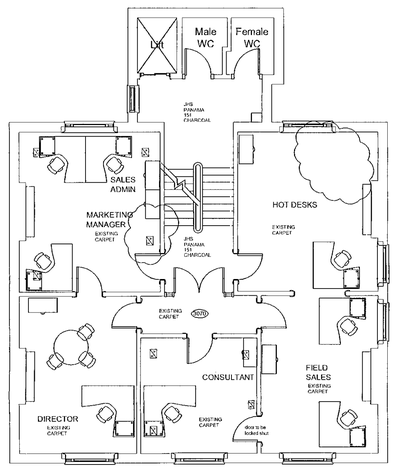

First Floor

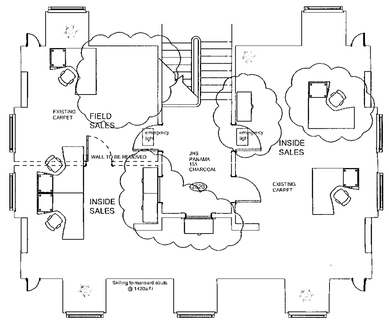

Second Floor



DULUX TRADE COLOUR DIMENSIONS 3040 R80B

DULUX TRADE COLOUR DIMENSIONS 0010 Y20R

Note, all doors are fire rated, with closers

Rev.	Revision	By	DC Chk
F	ALTERATIONS TO CARPET NOTES. PAINT COLOUR REFERENCES NOTED. DESIGN CHANGES 16.03.00	16.03.00	joe dr.19
E	ALTERATIONS TO FURNITURE IN THE OFFICE SERVICES ROOM, BUSINESS DEVELOPMENT AND 2ND FLOOR CUPBOARDS. KITCHEN UNIT LAYOUT ALTERATIONS. FLOOR FINISHES SHOWN CLIENT & DESIGN CHANGES AS MTG 09.03.00	13.03.00	joe dr.18
D	MINOR FURNITURE POSITION CHANGES. FEATURE WALL PAINT COLOURS INDICATED. TEA POINT WORKTOP ALTERATIONS. WORKSURFACE IN OFFICE SERVICES, ROOM ALTERED TO 900 WIDE CLIENT & DESIGN CHANGES AS MTG 02.03.00	02.03.00	joe dr.17
C	1 WORKSTATIONS MOVED POSITION. BENCH & TABLE OMMITTED FROM OFFICE SERVICES ROOM 2 STORAGE UNITS REMOVED. VINYL AMENDED. KITCHEN UNITS INDICATED. 2 PEDS REMOVED EX. DOOR INDICATED AND EX. DOOR TO REMAIN	15.02.00	joe dr.15
B	ALTERATIONS TO NO. OF WORKSTATIONS & STORAGE RISER CUPSS REMOVED. VINYL FLOOR INDICATED	07.02.00	joe dr.13
A	ALTERATIONS TO SIZE OF WORKSTATIONS, BENCHES	13.01.00	joe dr.06
-	CHANGES TO GENERAL LAYOUT CLIENT MTG 12.01.00	-	-

Status

= Preliminary/Information
= Approval/Comment
= Costplan
= As Built
= Construction
= Building Control

Designed by / Drawn by: RS and E Bennett

Checked by / Date: Paul Hollingsworth

MORGAN LOVELL
THE WORKPLACE SPECIALISTS

FS13724

Morgan Lovell
Ascot House, Finchampstead Road,
Wokingham, Berks RG40 2NW
Telephone: 0118 989 5300 Fax: 0118 989 5301
Email: mlregions@morganlovell.co.uk
http://www.morganlovell.co.uk

Client: ATTACHMATE

Project: MARKHAM HOUSE
20 BROAD STREET
WOKINGHAM

Drawing: ALL FLOORS
GENERAL LAYOUT

Scale	Date
1:50	16.11.99

Project no.	Sequential	Bldg/Floor	Detail	Rev.
A0115	21	20	GL	F

3 REV - 0 A1

28 APR 2000 * 1297

APPROVED

29/4/00