


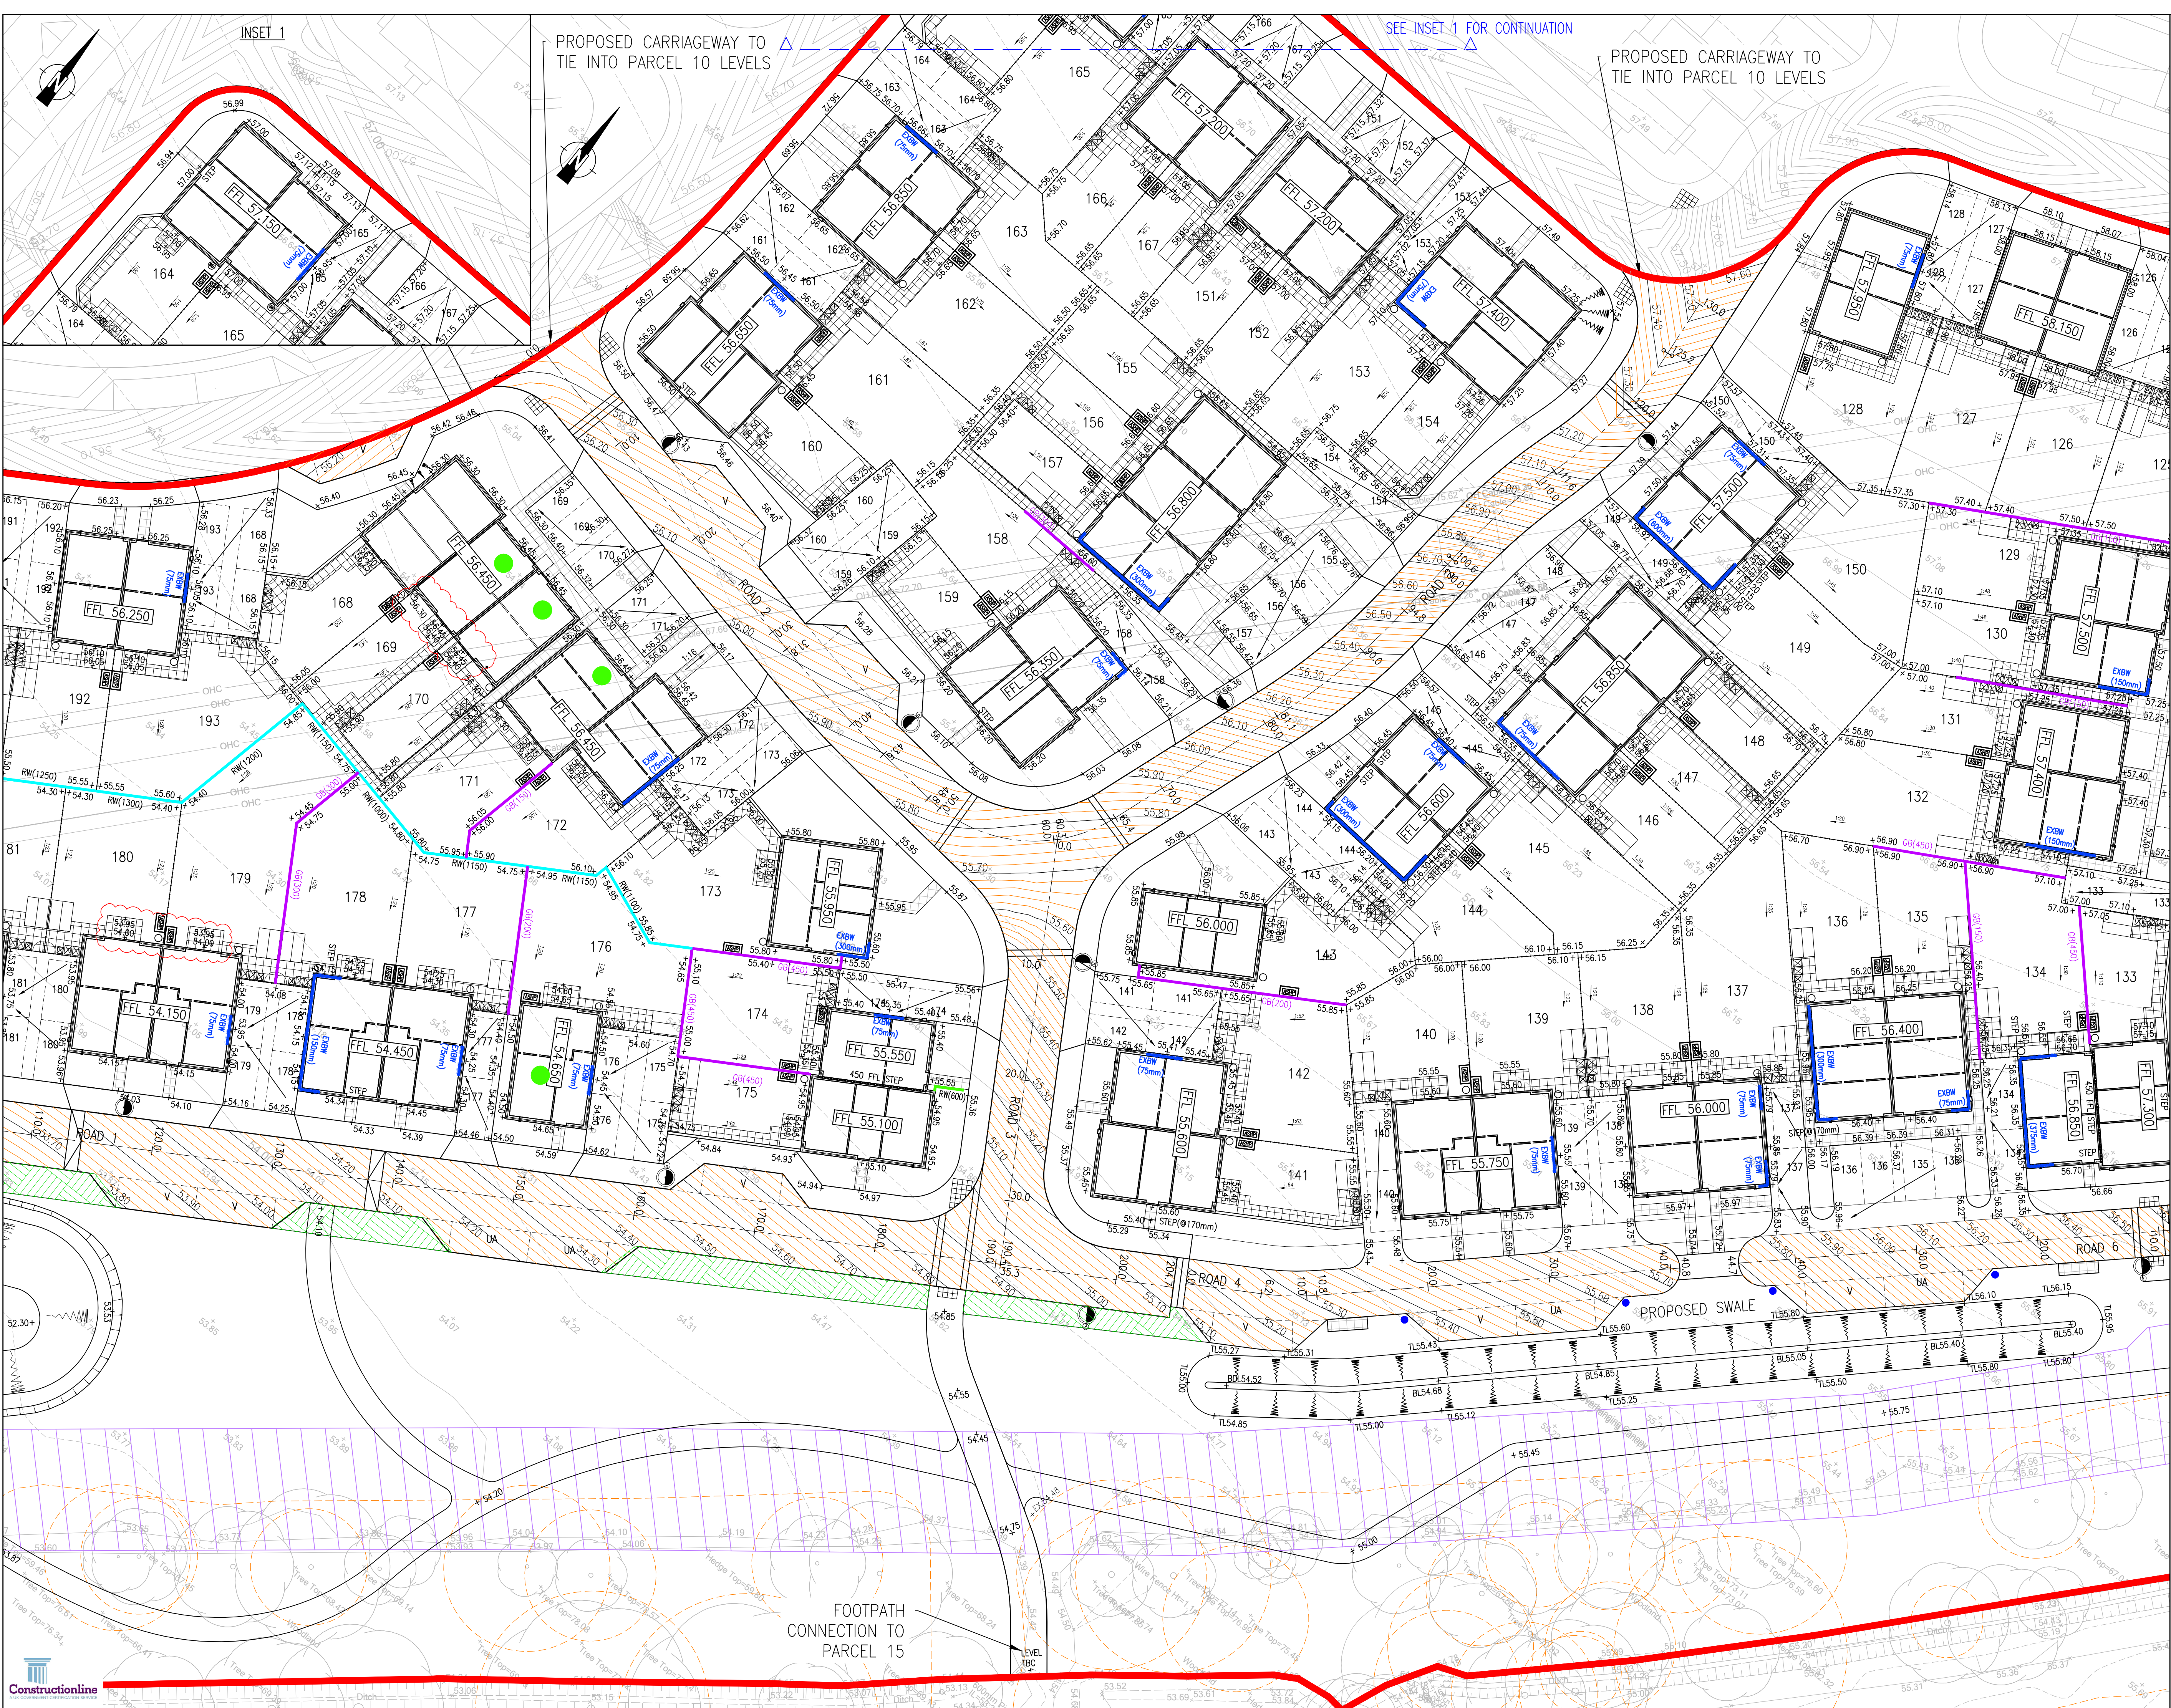

NOTES:

- DO NOT SCALE FROM THIS DRAWING.
- ALL DIMENSIONS ARE IN METRES, UNLESS STATED OTHERWISE.
- THIS DRAWING IS TO BE READ IN CONJUNCTION WITH ALL RELEVANT SCHEME DRAWINGS AND SPECIFICATIONS.

KEY:

- P11&12 SITE BOUNDARY
- PRIMARY CONTOUR
- SECONDARY CONTOUR
- PROPOSED LEVEL
- PROPOSED FINISHED FLOOR LEVEL
- GRAVEL BOARD
- RAISED DAMP PROOF COURSE
- EXPOSED BRICKWORK
- RETAINING WALL
- TEAM ELITE RETAINING WALL
- CENTRELINE AND CHAINAGE
- M4(2) UNIT
- TREE ROOT PROTECTION AREA
- PROPOSED BIORETENTION STRIP
- UNDERGROUND DIVERSION EASEMENT OF EXISTING OVERHEAD ELECTRIC CABLE
- EXISTING OIL MAIN EASEMENT
- EXISTING SEWER EASEMENT
- 1 IN 3 BANK

SHEET KEY

SO 105	UPDATED TO SUIT LATEST RM SUBMISSION	JH	TA	02.12.25	
SO 104	LEVELS TO REAR OF PLOT 179 AND 180 REVISED AND ROPC ADDED TO PLOT 169 AND 170	TV	TA	29.10.25	
SO 103	UPDATED TO SUIT CLIENT TENDER PACK COMMENTS	HF	TA	22.08.25	
SO 102	UPDATED RETAINING WALL TO SUIT TEAM ELITE WALL SYSTEM	WM	TA	23.07.25	
SO 101	ISSUED FOR TENDER	AS	TA	16.07.25	
ST	Rev	Description	Drm	Cnk	Date
REVISIONS					
Preliminary Issue					
Submitted for S104					
Planning Issue					
Submitted for S38					
Submitted for S278					
As Built					
DRAINAGE STATUS					

STUART MICHAEL ASSOCIATES
CONSULTING ENGINEERS

Stuart Michael Associates Ltd
Coombe House, Coombe Square, Thatcham, Berkshire RG19 4JF
T: 01635 867 711 E: mail@stuartmichael.co.uk
F: 01635 861 715 W: www.stuartmichael.co.uk

Part of the Vistry Group

FINCHWOOD PARCELS 11, 12 & 13

PARCELS 11 & 12
PROPOSED LEVELS & CONTOURS
SHEET 2 OF 4

DATE	JUNE 2025	DRAWN	AS	CHECKED	KJM	SCALE	1:250	BY	SO
PROJECT NO.	7292-SMA-XX-XX-DR-C-0506	REV	T05	SO					

This drawing is the copyright of Stuart Michael Associates Limited. It may not be reproduced or amended without the written approval of Stuart Michael Associates