


65 BARKHAM RIDE RG40 4HA EXISTING DRIVEWAY AND WALL

Existing wall




N↑

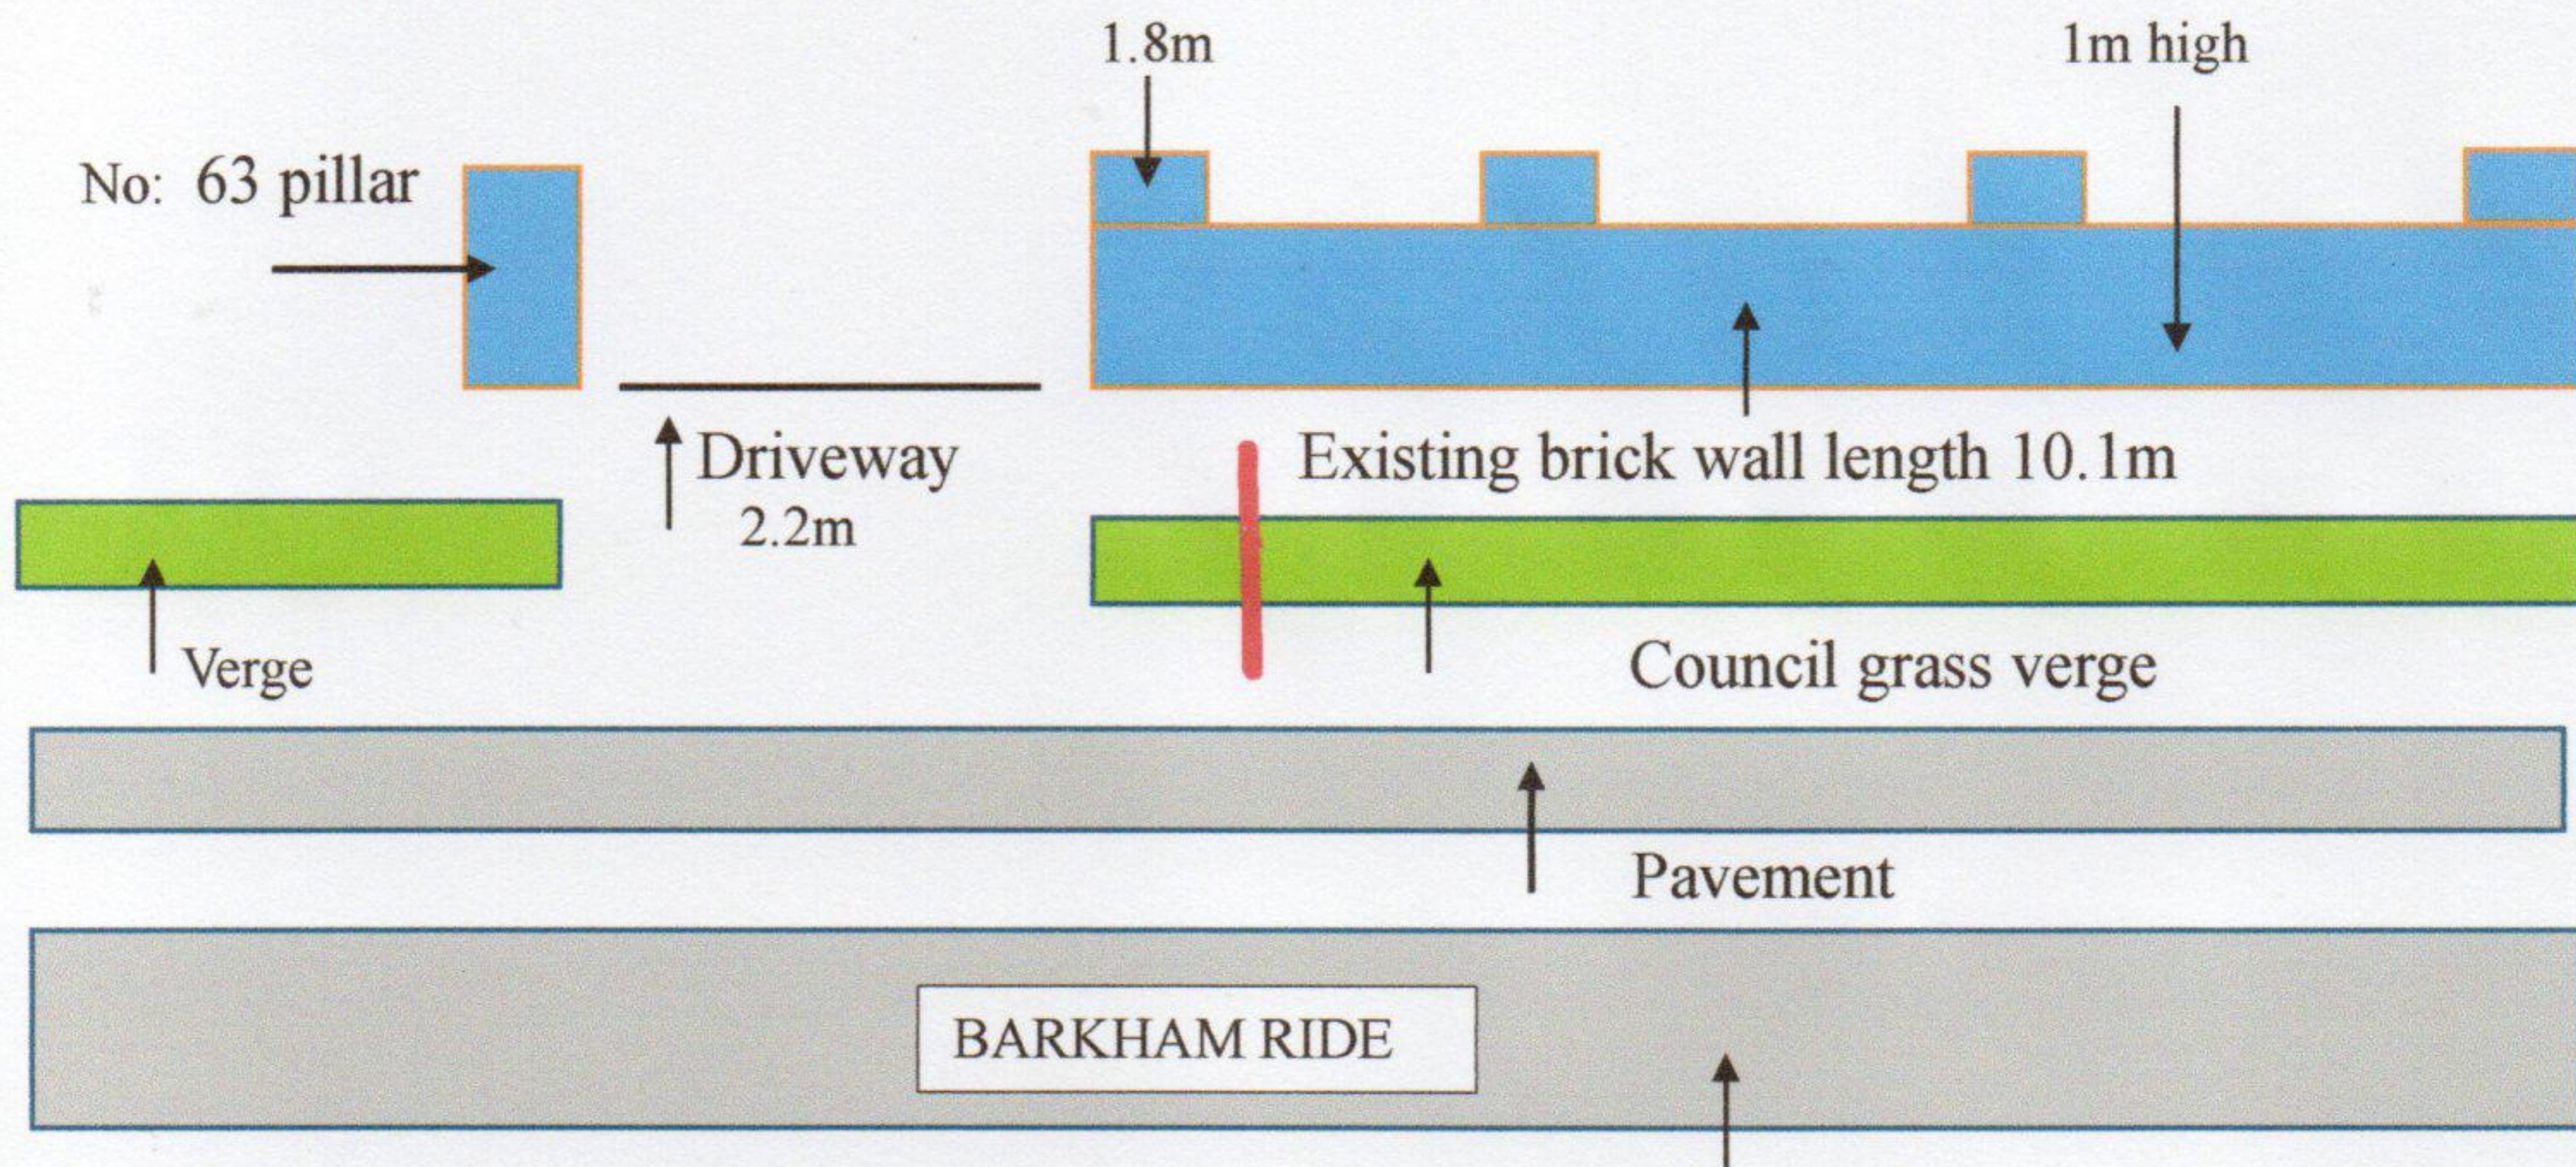

RED LINE shows the 0.6m × 0.9m section of council verge required for the driveway widening (to be surfaced in tarmac)

PROPOSED DRIVEWAY AND WALL

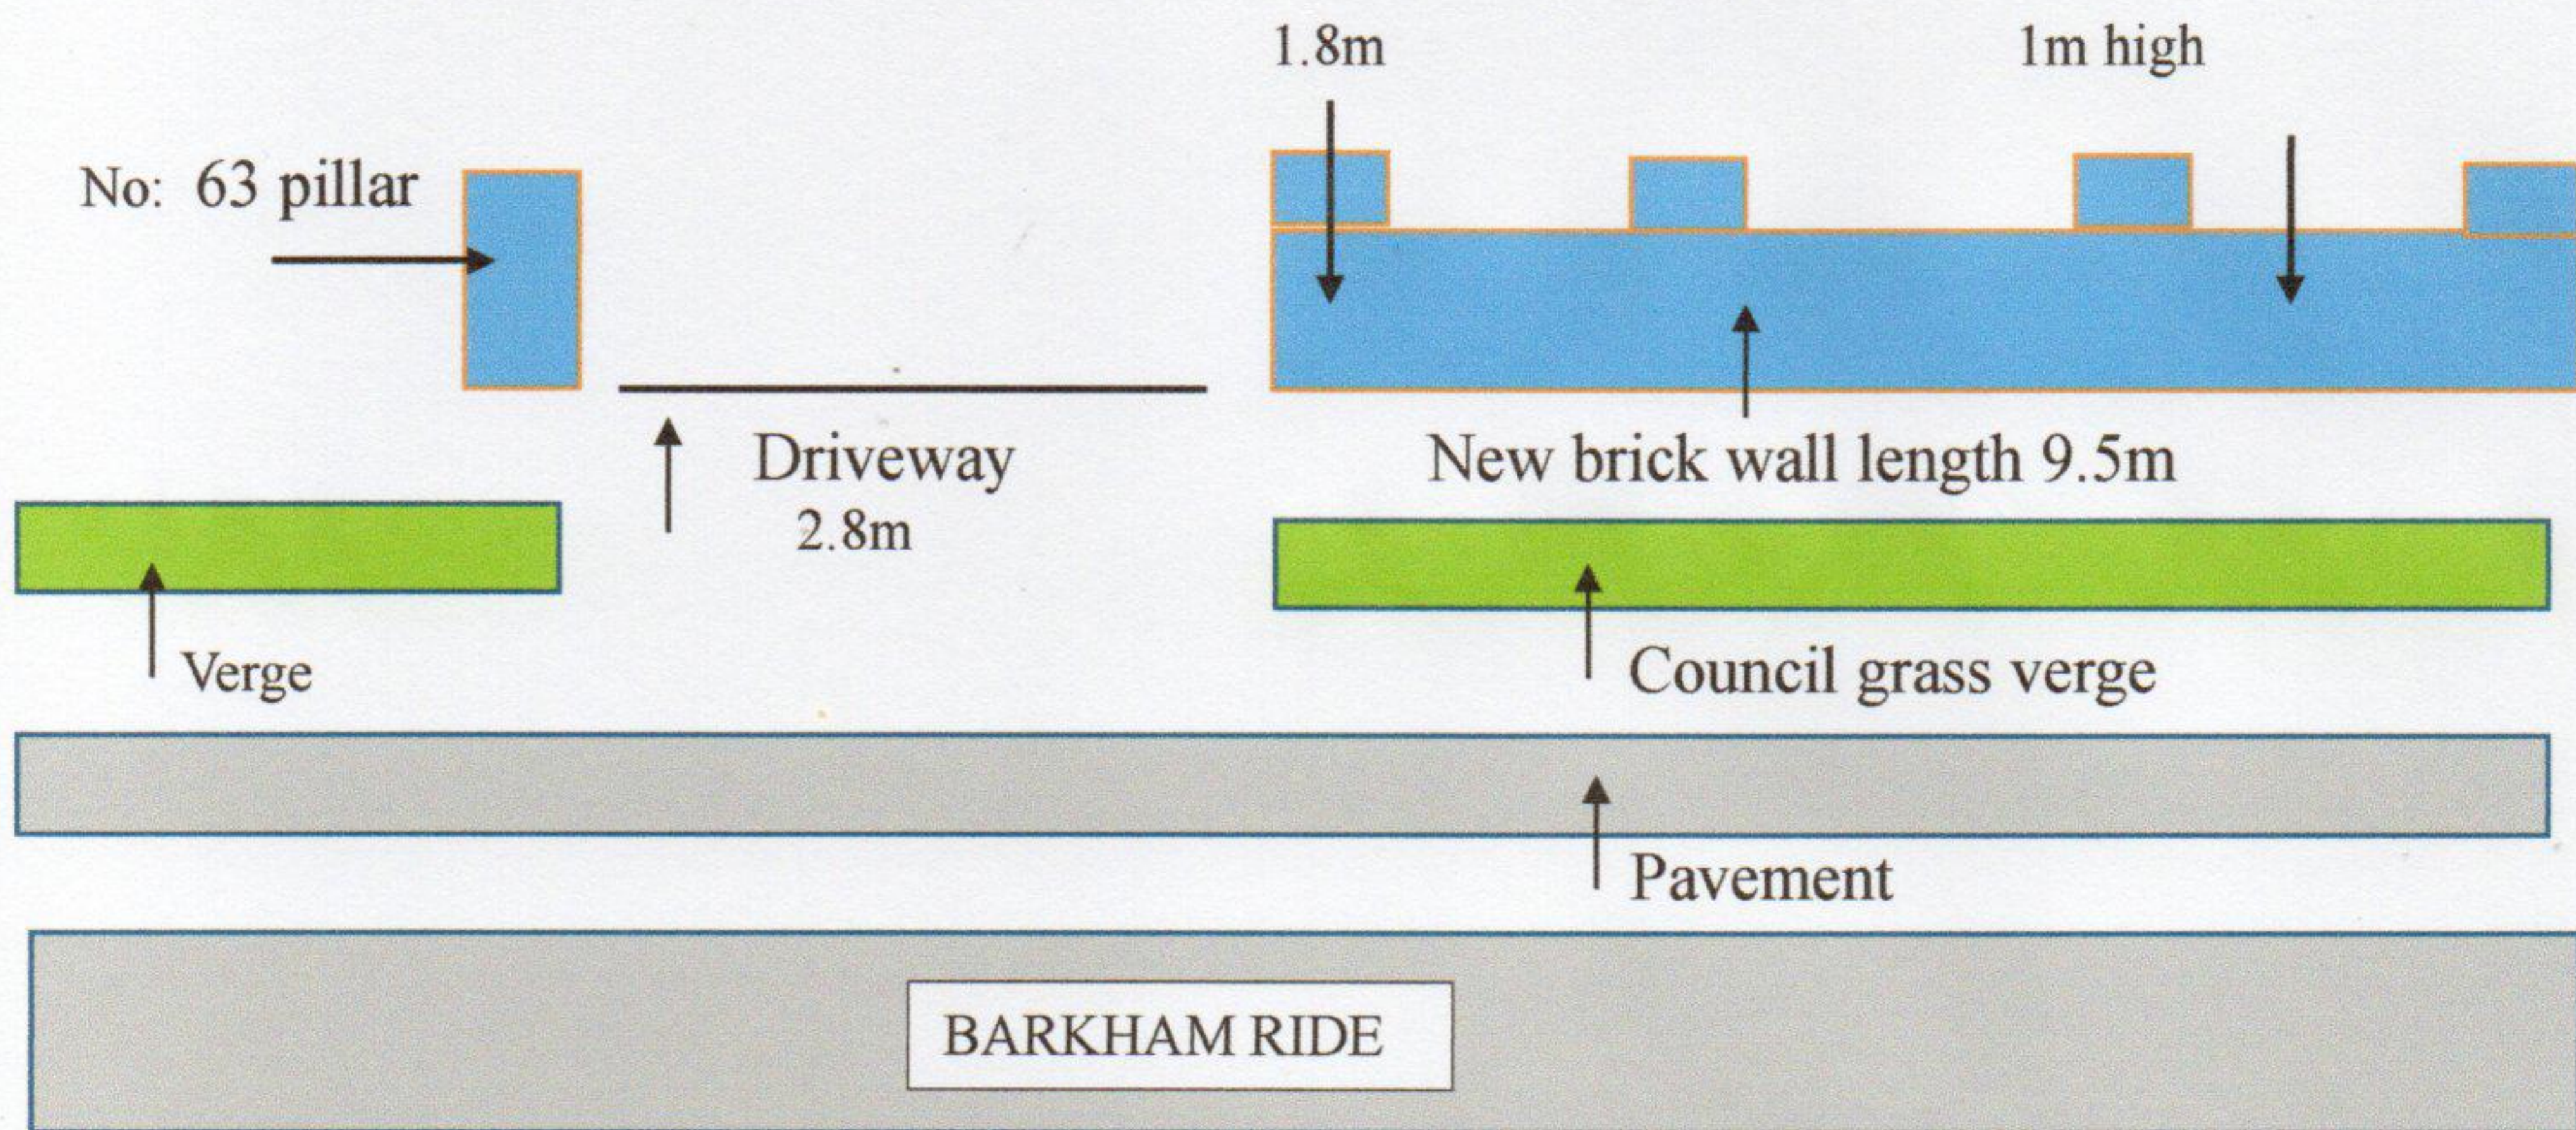

NEW DRIVE WAY

1m
Scale 1:100
(@ A4)



New widened drive

