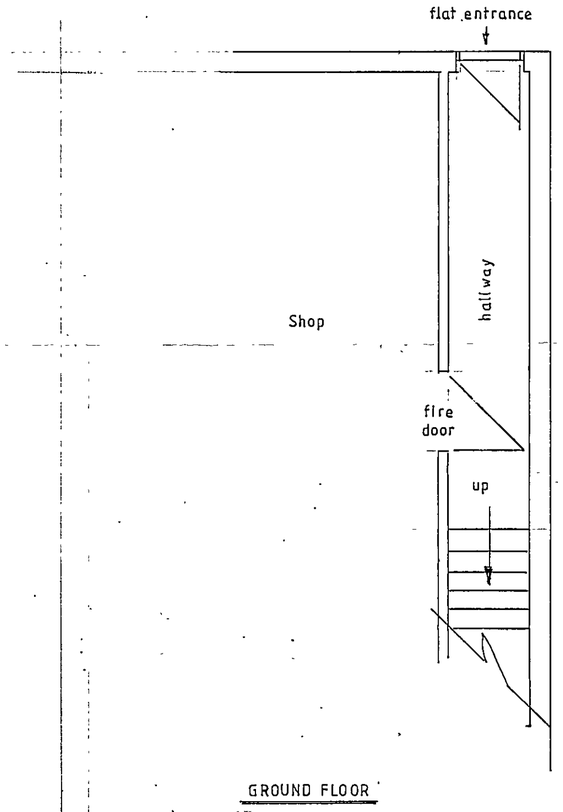

GROUND FLOOR

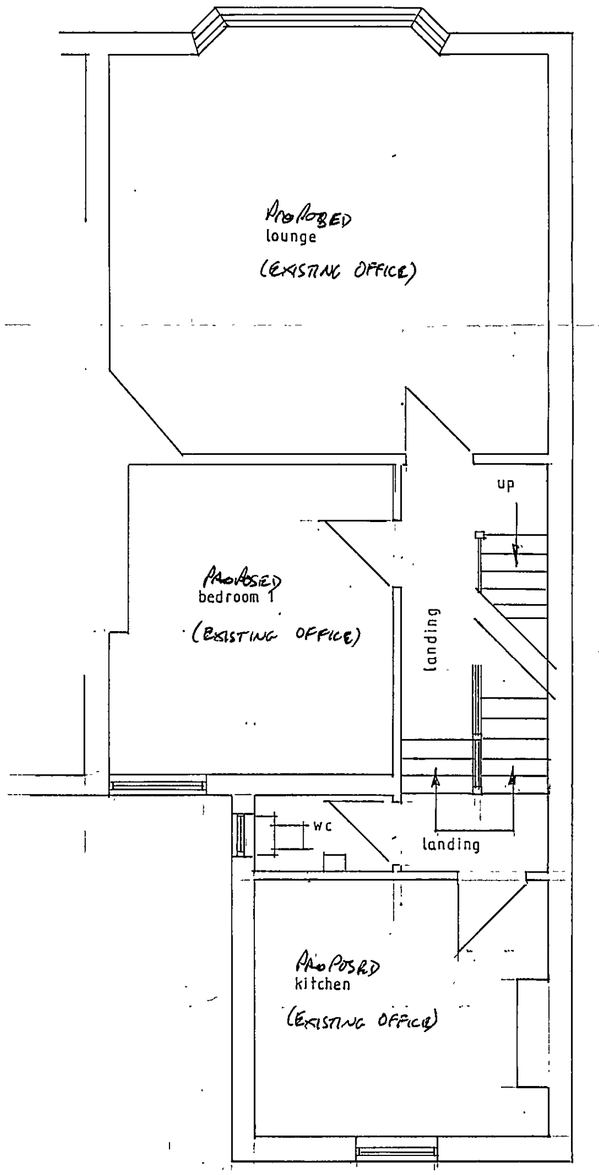

FIRST FLOOR

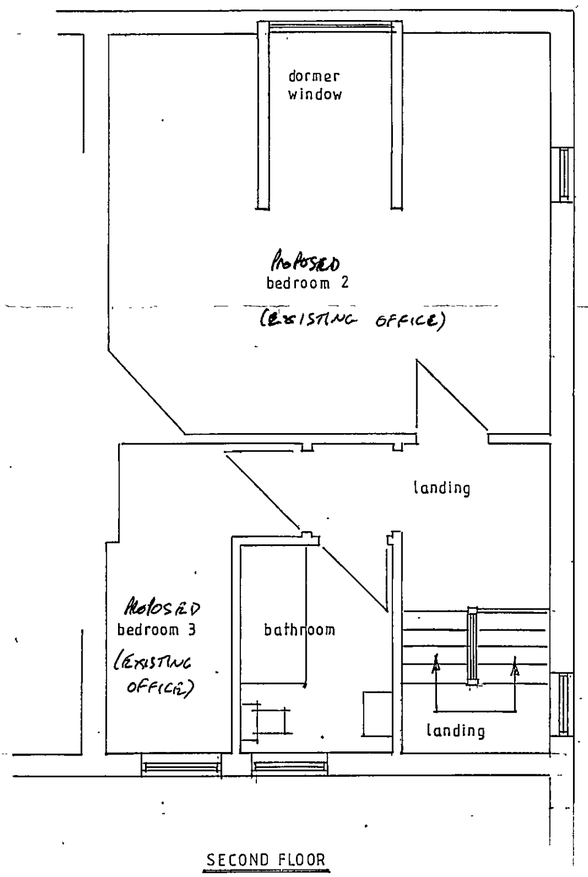

SECOND FLOOR

Notes:
~~All dimensions must be checked on site and not scaled from this drawing.~~

A		
	Date	Revisions

© copyright

31.OCT.2002 7905

Client

Job Title
Change of use-
Offices to living accommodation

Drawing Title
Nº 2A SHUTE END
WOKINGHAM
BERKS
RG40

Scale 1:50

Date October 2002 | Drawn by

Drg. No. [illegible] | Rev.

[ARCH]

420 x 594mm A2

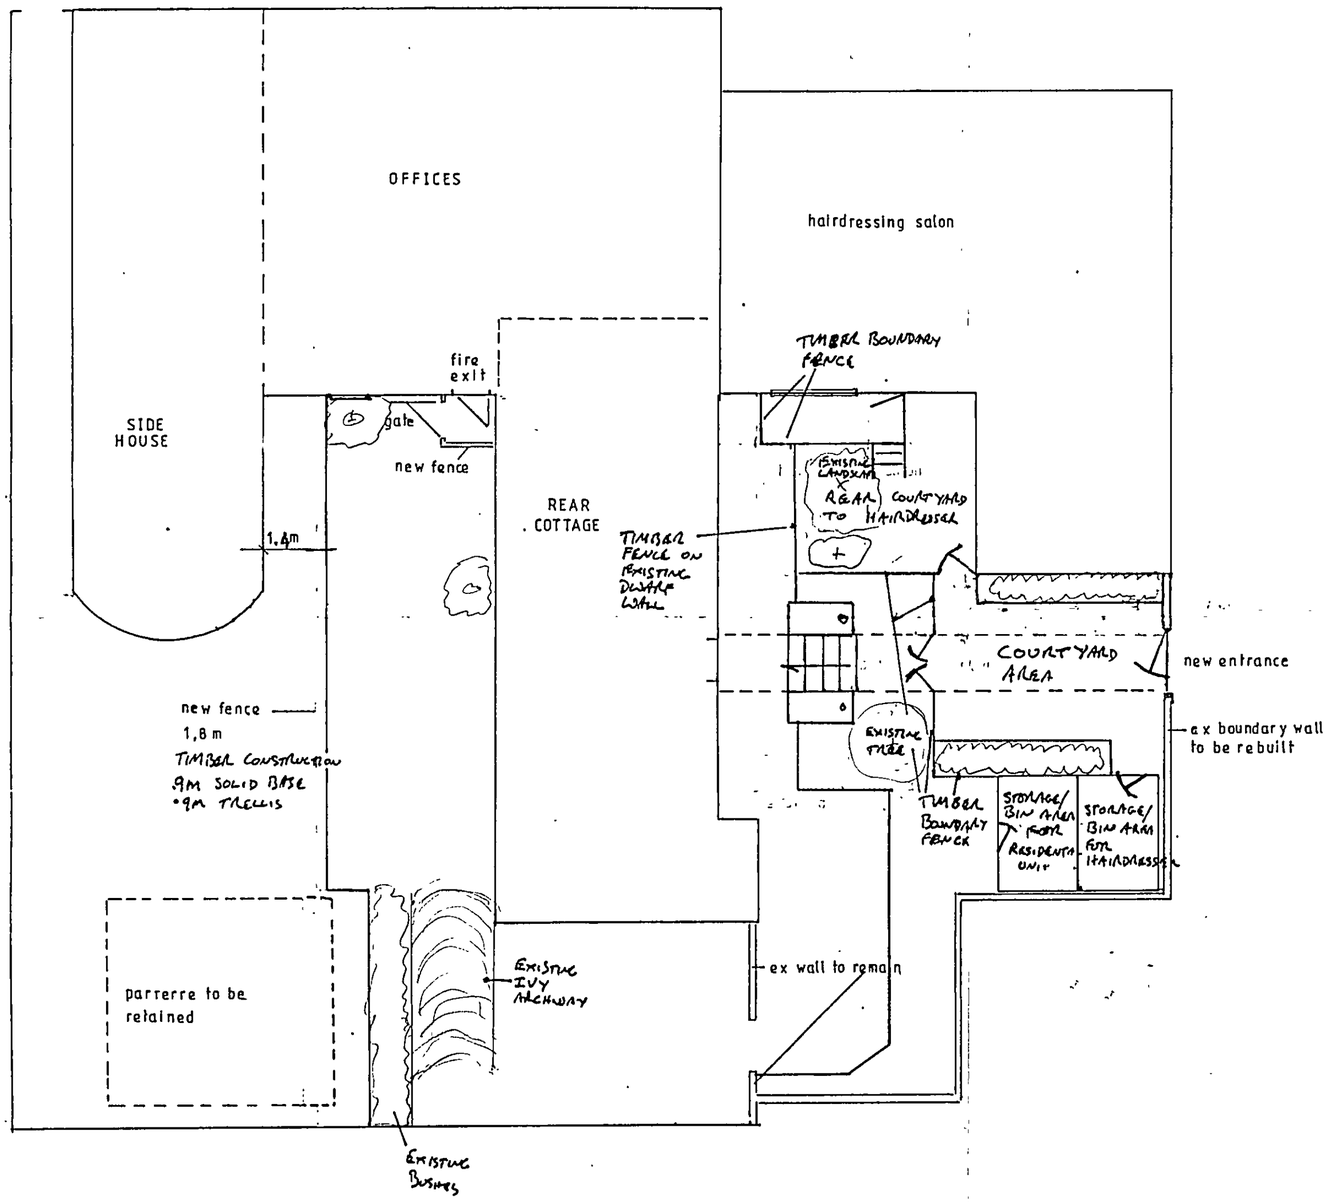

REVISED PLAN
7905
8801

Notes:
~~All dimensions must be checked on site and not scaled from this drawing.~~

PLANNING SERVICES	HPT
POL	TLS
UC	ENF
APP	
CS	

10 JUN

B	10/7/03	REAR BOUNDARIES
A		
	Date	Revisions

© copyright

Client

Job Title
proposed gardens and ammenity areas

PLANNING SERVICES	HPT
POL	TLS
DC	ENF
APP	
CS	
	ACK
	FILE

Drawing Title
N° 6 and 8 SHUTE END
WOKINGHAM
BERKS
RG 40 1BY

Scale

Date
March 2003

Drawn by

Drg. No.
68SE/02

Rev.
A

420 x 594mm A2

31 OCT 2002 7905

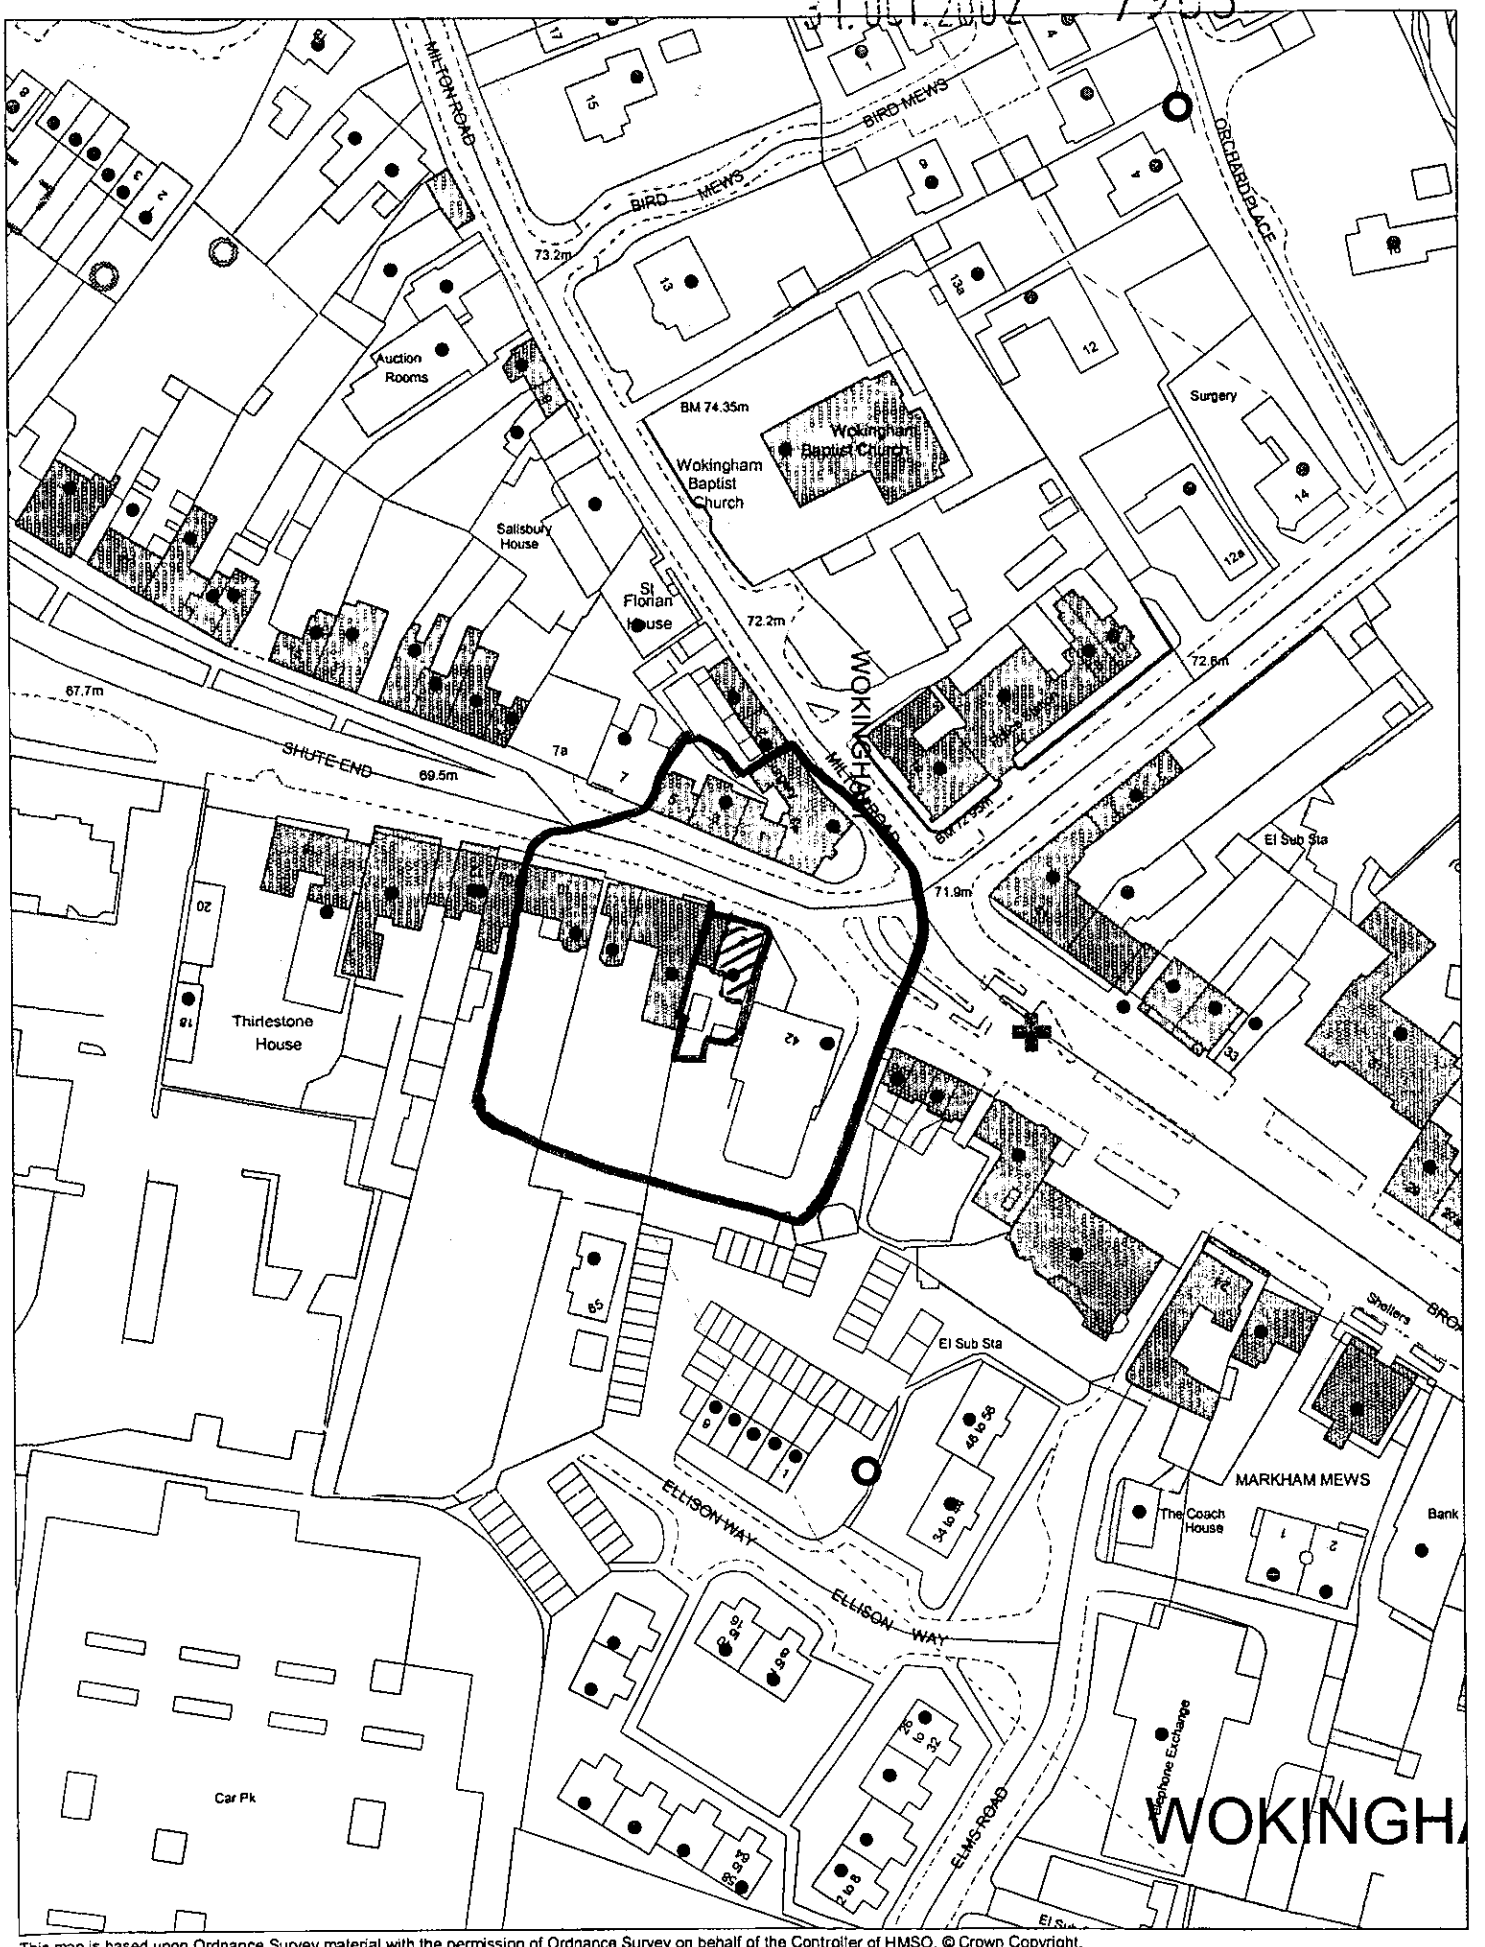

This map is based upon Ordnance Survey material with the permission of Ordnance Survey on behalf of the Controller of HMSO. © Crown Copyright.
Unauthorised reproduction infringes Crown Copyright and may lead to prosecution or civil proceedings.Wokingham District Council Licence LA086134

Development Control,Wokingham District Council.
6 November 2002

Scale: 1 : 1250

N
W E
S

Ordnance Survey®
Superplan®

31.OCT.2002 7905

Option 1
Site-centred

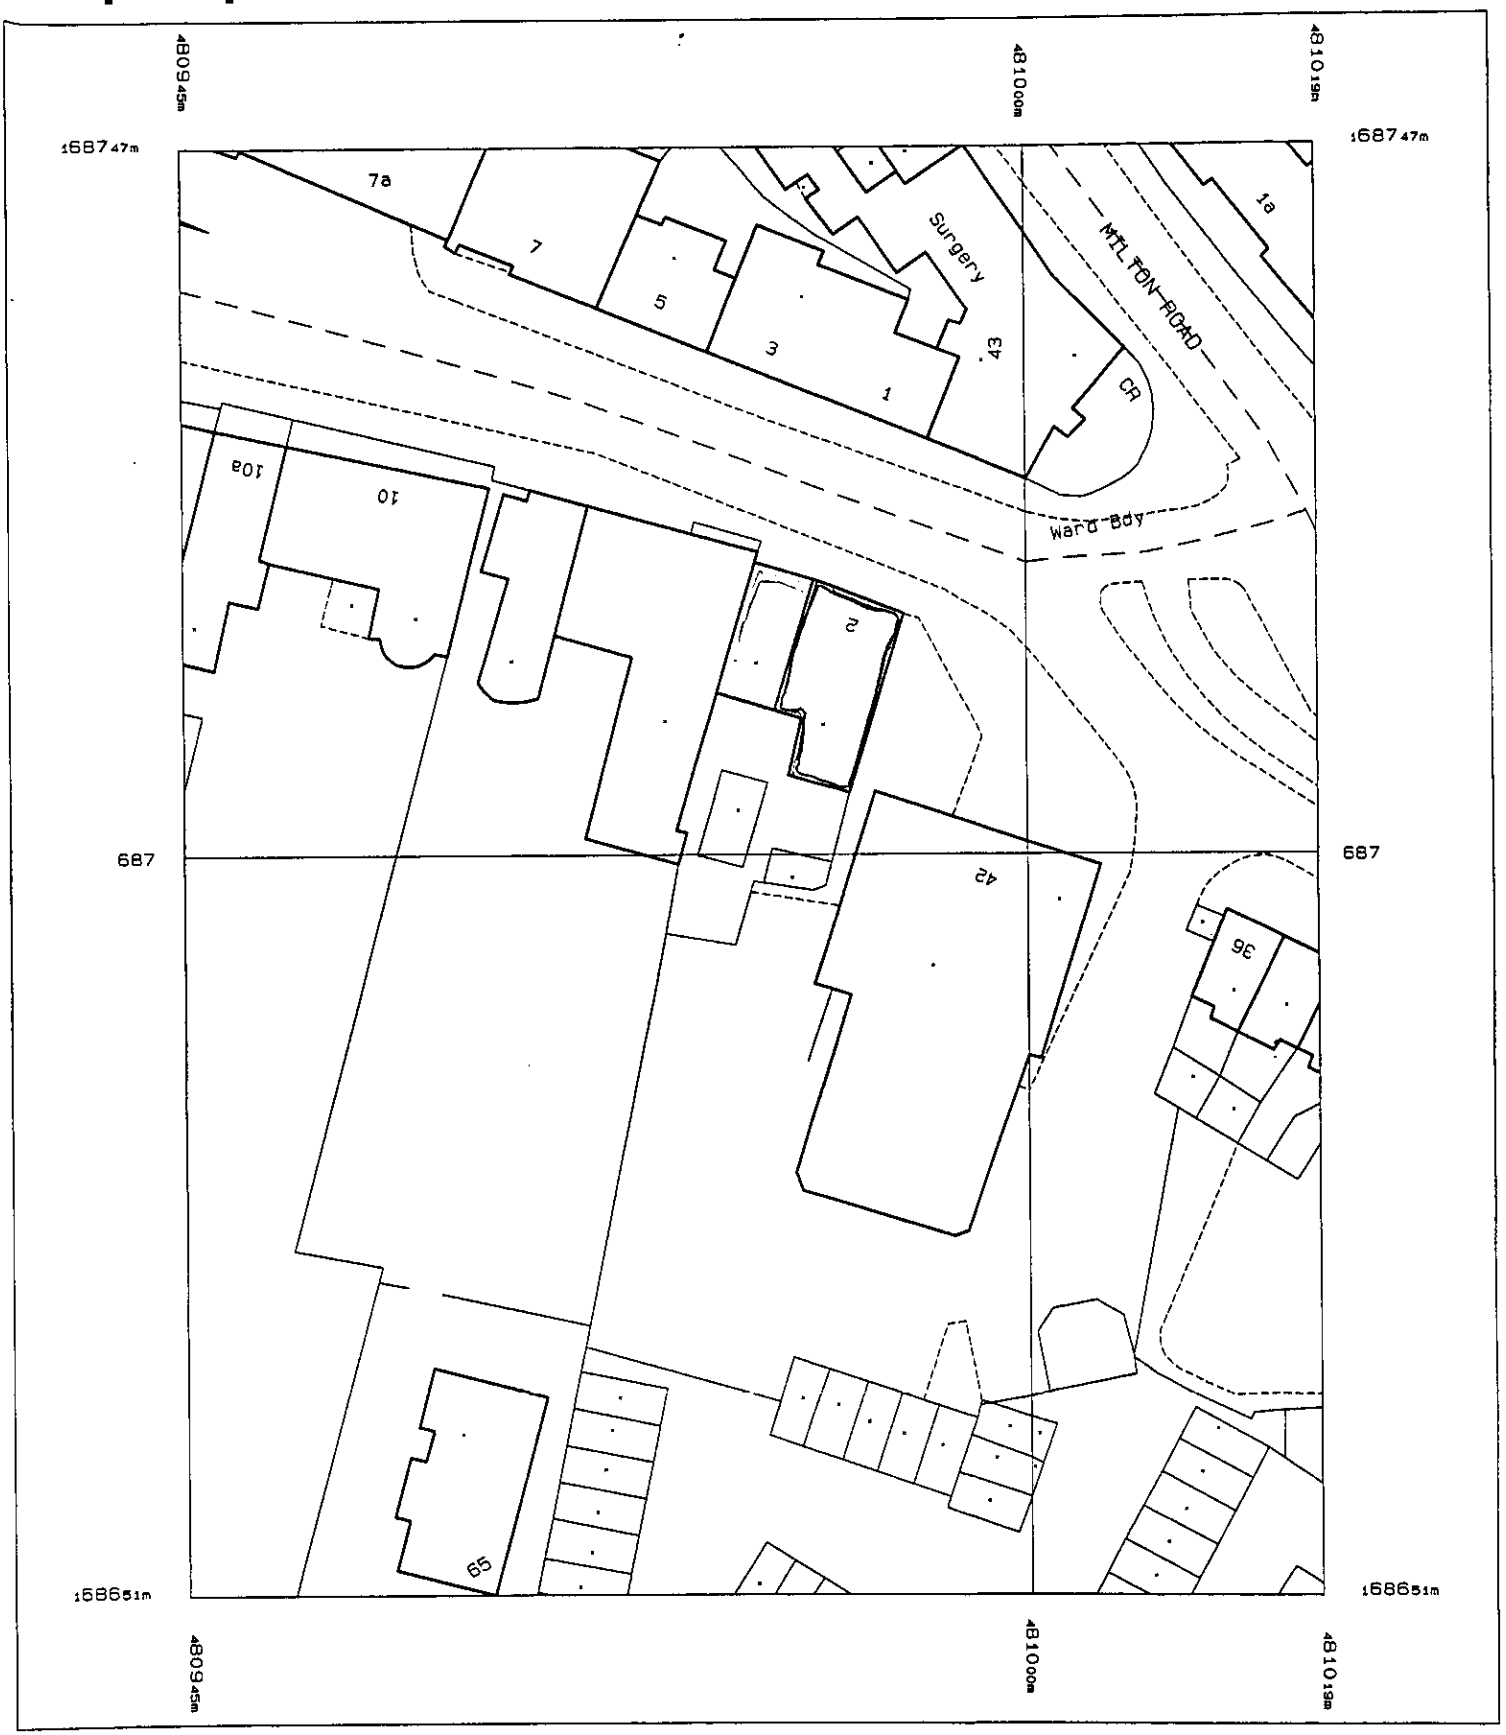

Produced 27 Aug 2002 from Ordnance Survey digital data and incorporating surveyed revision available at this date. © Crown Copyright 2002.

Reproduction in whole or in part is prohibited without the prior permission of Ordnance Survey.

Ordnance Survey, the OS symbol and Superplan are registered trade marks of Ordnance Survey,

Part or all of this Superplan is enlarged from mapping produced at one or more of the following scales: 1:1250, 1:2500 & 1:10000

Scale 1:500

National Grid sheet reference at centre of this Superplan: SU8068NE

THE FOLLOWING SCANNED IMAGES ARE DOCUMENTS OF BAD QUALITY OR ARE PHOTOCOPIES.

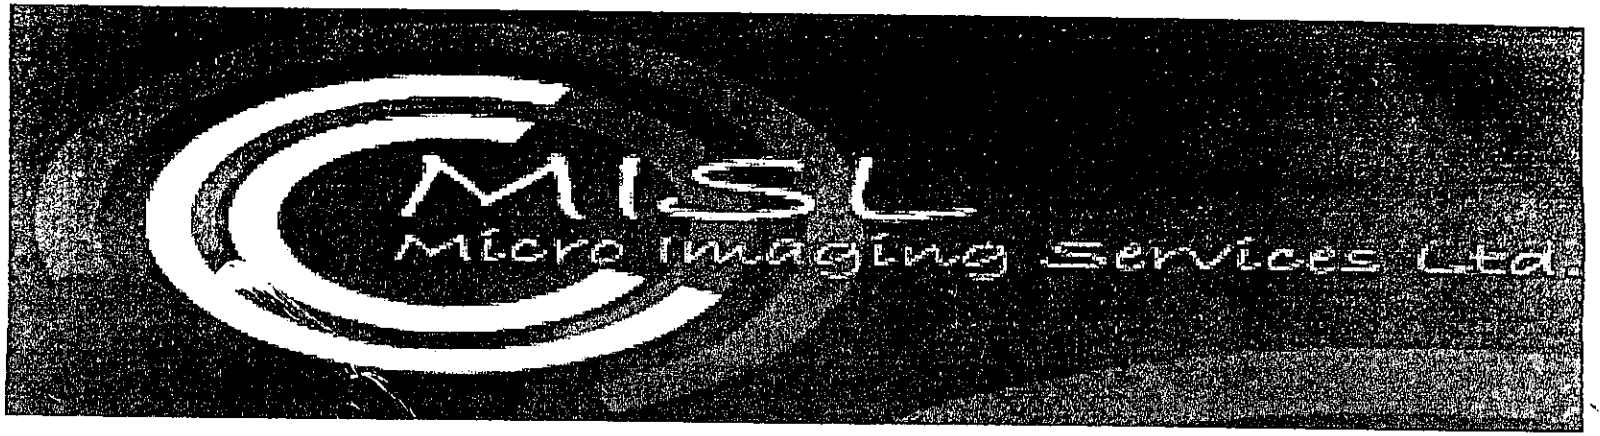

FOR THIS REASON THEY MAY APPEAR UNREADABLE ON SCREEN

Scale 1:2500

31.OCT.2002 7965

2A SHUTE END

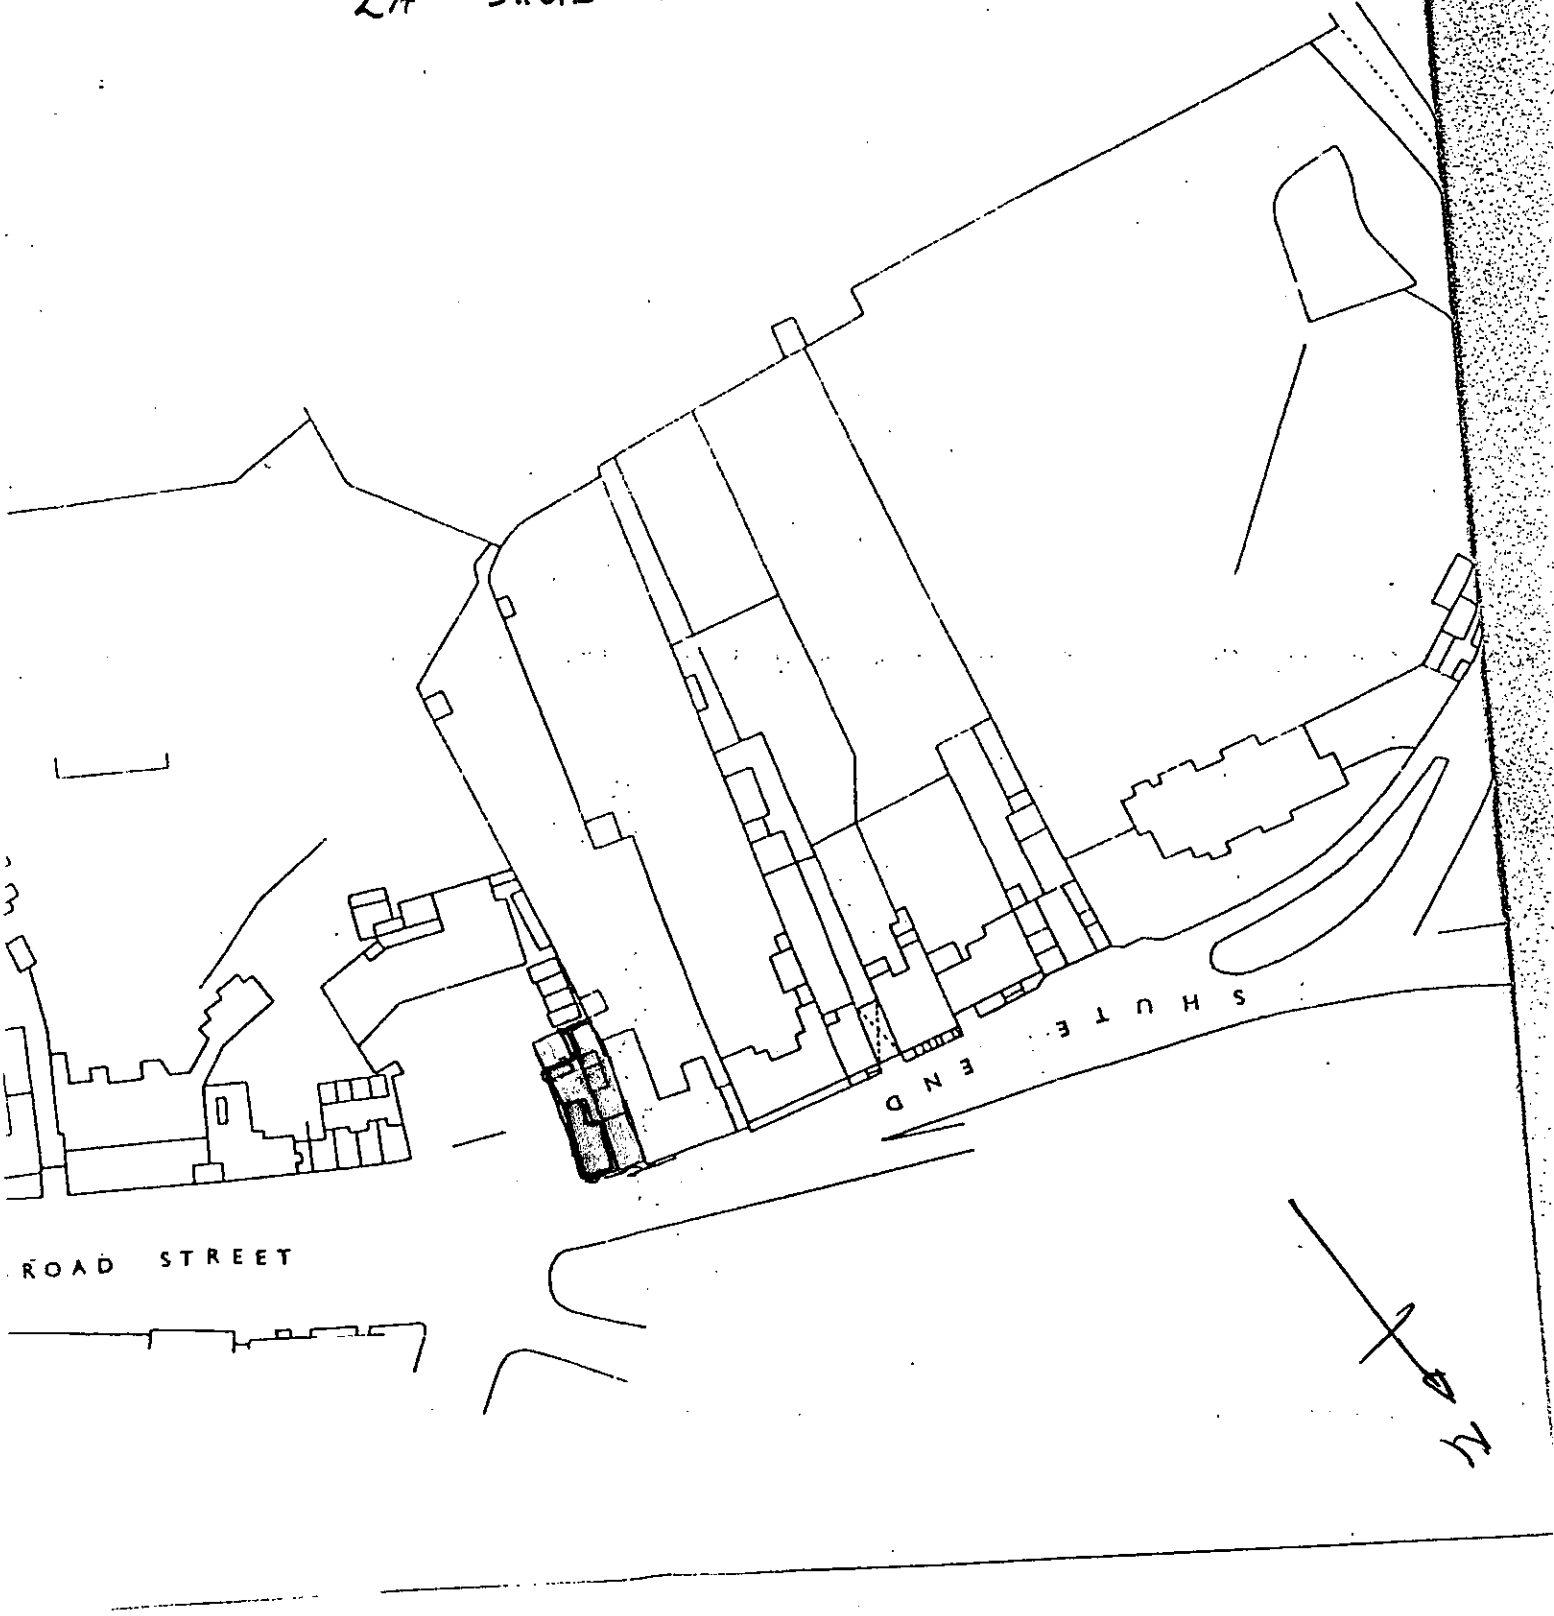

2636027003