


06.NOV.2000* 2755

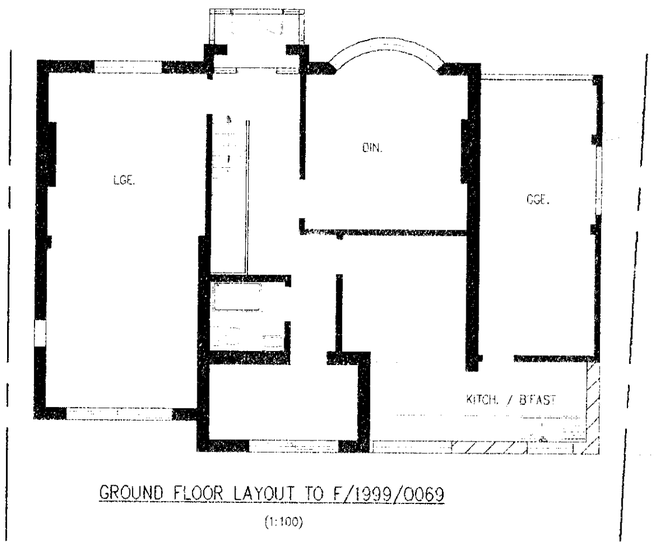



GROUND FLOOR LAYOUT TO F/1999/0069
(1:100)

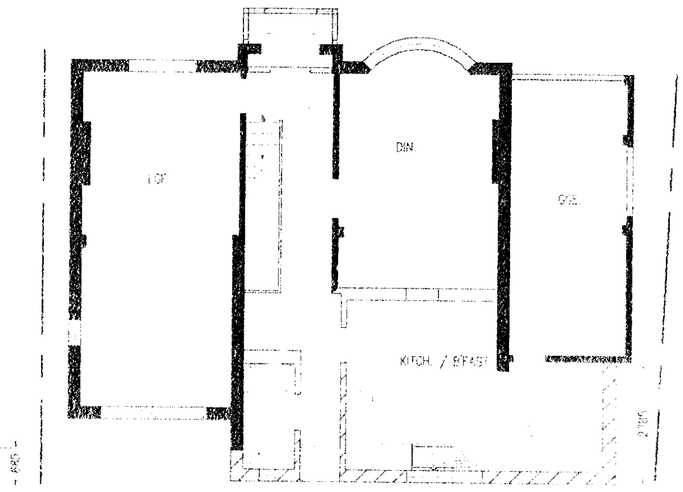



GROUND FLOOR LAYOUT
(1:100)

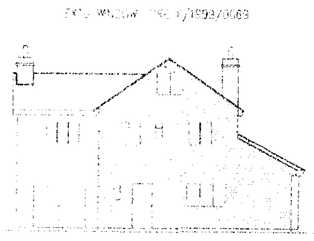

REAR (SOUTH EAST)

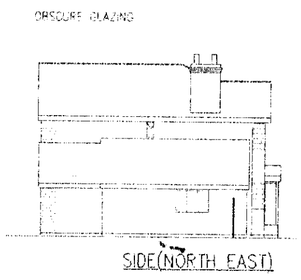



SIDE(NORTH EAST)

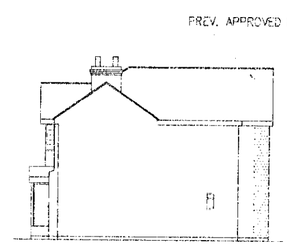



SIDE(SOUTH WEST)


ELEVATIONS FOR RETROSPECTIVE APPROVAL
(1:200)

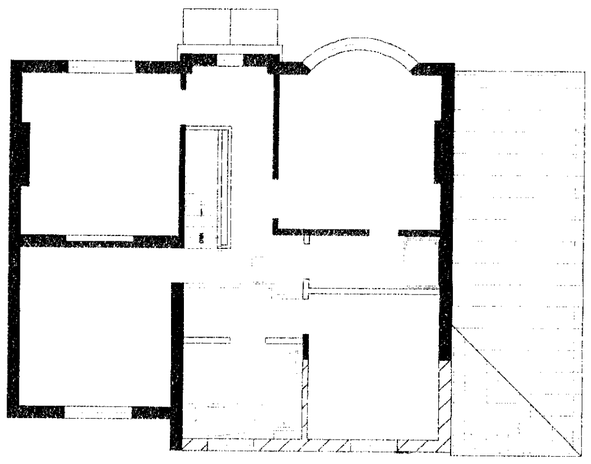

FIRST FLOOR LAYOUT TO F/1999/0069
(1:100)

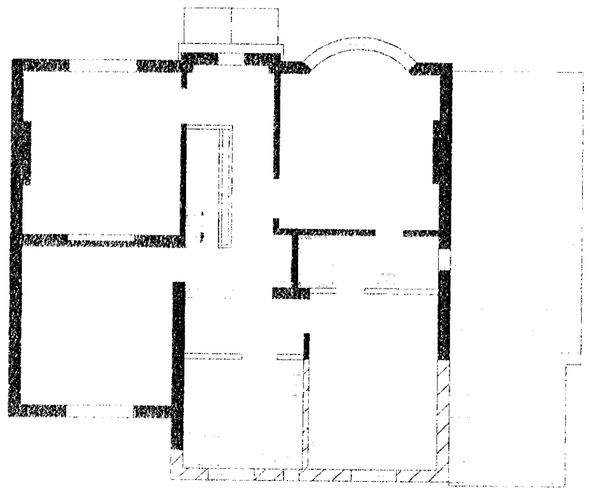


FIRST FLOOR LAYOUT
(1:100)

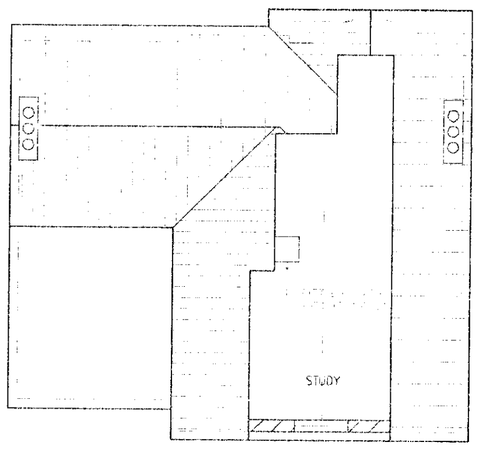



SECOND FLOOR LAYOUT TO F/1999/0069(IMPLIED)
(1:100)

APPROVED PLANS TO APP. NO. F/1999/0069

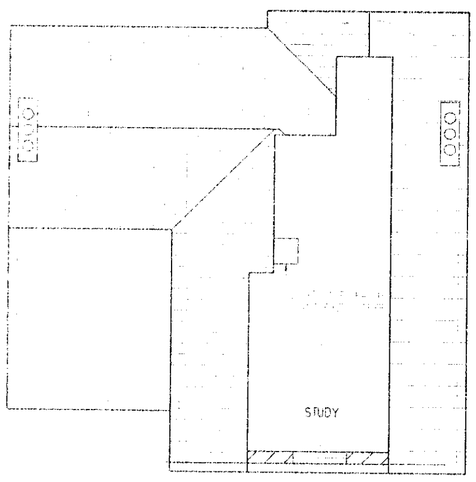


SECOND FLOOR LAYOUT
(1:100)


AS BUILT OR PLANS FOR RETROSPECTIVE APPROVAL

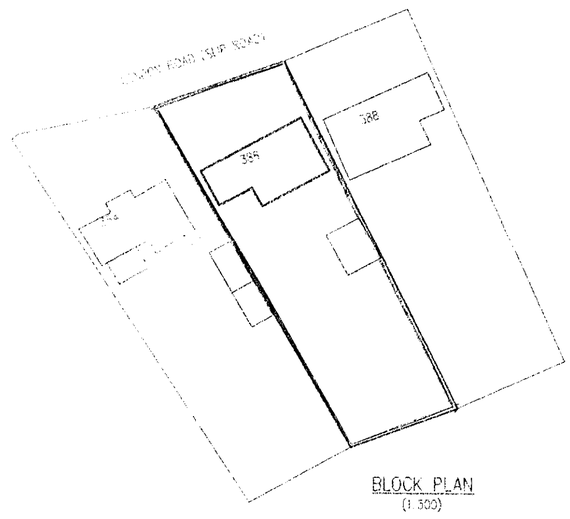


BLOCK PLAN
(1:500)

N

APPROVED

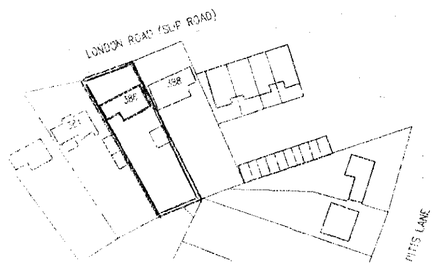


SITE LOCATION PLAN
(1:1250)




## NOTES AND SPECIFICATION

1. DO NOT SCALE OF THIS DRAWING.
2. ALL DIMENSIONS ARE IN MILLIMETRES UNLESS OTHERWISE SPECIFIED.
3. THIS DRAWING IS ONLY FOR PLANNING PERMISSION AND PRELIMINARY ESTIMATION PURPOSES AND NO OTHER.
4. ALL EXTERNAL MATERIALS SHALL MATCH EXISTING EXCEPT WHERE OTHERWISE SPECIFIED.
5. ALL COPYRIGHTS ARE RESERVED WITH THE ORIGINATOR.
6. NO PART OF THE WORKS SHALL ENCROACH UNDERGROUND, OR ABOVE, OR OVERHANG IN ANY WAY BEYOND THE APPLICATION SITE BOUNDARIES.
7. THIS DRAWING IS TO BE READ FULLY IN CONJUNCTION WITH DWG./SHT. NOs: N/A
8. SUPPORTING REPORTS TO BE READ WITH THIS DRAWING, EITHER PRINTED HEREON OR ISSUED SEPARATELY, ARE AS FOLLOWS : N/A
9. © *COPYRIGHT KALSI ASSOCIATES LTD. 2000*

NEW CONST. SHOWN THUS:
PLAN
ELEVATIONS

| | | |
|---|---|---|
| 0 | 26.10.00 | FIRST ISSUE |


KALSI ASSOCIATES
*KALSI ASSOCIATES LTD.*
*BUILDING CONSULTANTS*
*6 Devonshire Park,*
*Reading, RG2 7DX*
*Tel: (0118) 975 7988*
*Fax: (0118) 975 7966*
*E-mail: KA LTD@CS.COM*
*Planning, Architectural*
*Civil and Structural Design,*
*Survey & Project Management Services*
*Dir.: R.S. KALSI BSc;MBA;C.Eng;MICE;MIAS;MBIM*


MR & MRS D. S. PHANDER

PROPOSED DOUBLE STOREY REAR EXTENSION AT 386 LONDON ROAD EARLEY READING BERKSHIRE

T&CP DETAILS: PLANS/ELEVATIONS


| SCALE | DATE | DRN | JOB NO. | DWG. NO. | SHEET NO. | REVISION |
|---|---|---|---|---|---|---|
| 1:100 | 14.03.00 | RSK | 447 0016 | 447.02 | 0 | 1 OF 1 |

A2 1:100

CAD FILE NAME: 447-01-SRV

PLOT DATE: 26.10.00
JOB. INF. C:\MBP-BVC\447-0016\386-LON\DWGP

06.NOV.2000* 2756

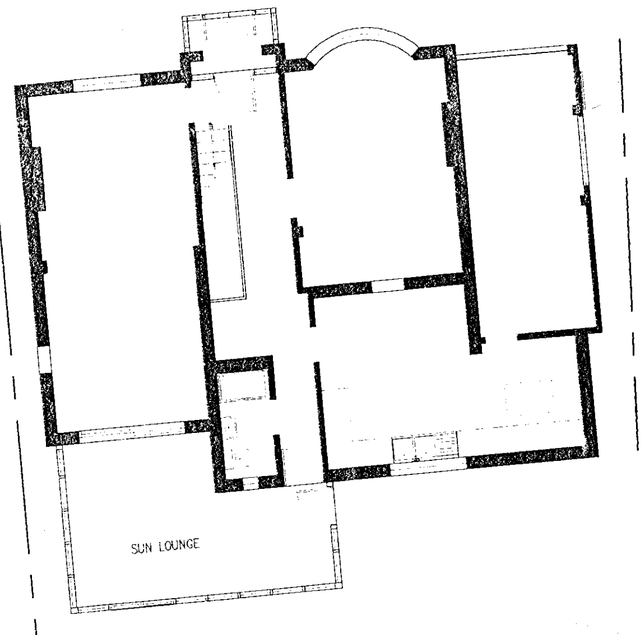



PROPOSED GROUND FLOOR PLAN
(1:100)



REAR (SOUTH EAST)



SIDE(NORTH EAST)

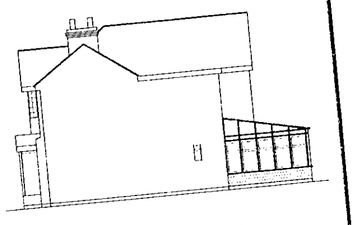

SIDE(SOUTH WEST)

ELEVATIONS FOR SUNLOUNGE
(1:200)

APPROVED

## NOTES AND SPECIFICATION

1. DO NOT SCALE OF THIS DRAWING.
2. ALL DIMENSIONS ARE IN MILLIMETRES UNLESS OTHERWISE SPECIFIED.
3. THIS DRAWING IS ONLY FOR PLANNING PERMISSION AND PRELIMINARY ESTIMATION PURPOSES AND NO OTHER.
4. ALL EXTERNAL MATERIALS SHALL MATCH EXISTING EXCEPT WHERE OTHERWISE SPECIFIED.
5. ALL COPYRIGHTS ARE RESERVED WITH THE ORIGINATOR.
6. NO PART OF THE WORKS SHALL ENCROACH UNDERGROUND, OR ABOVE, OR OVERHANG IN ANY WAY BEYOND THE APPLICATION SITE BOUNDARIES.
7. THIS DRAWING IS TO BE HEAD FULLY IN CONJUNCTION WITH DWG./SHT. NOs: N/A
8. SUPPORTING REPORTS TO BE READ WITH THIS DRAWING, EITHER PRINTED HEREON OR ISSUED SEPARATELY, ARE AS FOLLOWS : N/A
9. © *COPYRIGHT KALSI ASSOCIATES LTD. 2000*

NEW CONST. SHOWN THUS:
PLAN
ELEVATIONS

| | | |
|---|---|---|
| 0 | 26.10.00 | FIRST ISSUE |


KALSI ASSOCIATES
*KALSI ASSOCIATES LTD.*
*BUILDING CONSULTANTS*
*6 Devonshire Park,*
*Reading, RG2 7DX*
*Tel: (0118) 975 7988*
*Fax: (0118) 975 7966*
*E-mail: KA LTD@CS.COM*
*Planning, Architectural*
*Civil and Structural Design,*
*Survey & Project Management Services*
*Dir.: R.S. KALSI BSc;MBA;C.Eng;MICE;MIAS;MBIM*


MR & MRS D. S. PHANDER

PROPOSED SUN LOUNGE AT 386 LONDON ROAD EARLEY READING BERKSHIRE


T&CP DETAILS: PLANS/ELEVATIONS

| SCALE | DATE | DRN | JOB NO. | DWG. NO. | SHEET NO. | REVISION |
|---|---|---|---|---|---|---|
| 1:100 1:200 1:500 | 14.03.00 | RSK | 447 0016 | 447.03 | 0 | 1 OF 1 |


A3 1:100

CAD FILE NAME: 447-01-SRV

PLOT DATE: 26.10.00
JOB. INF. C:\MBP-BVC\447-0016\386-LON\DWGP

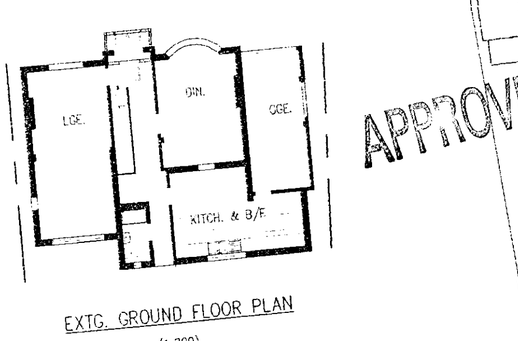



EXTG. GROUND FLOOR PLAN
(1:200)

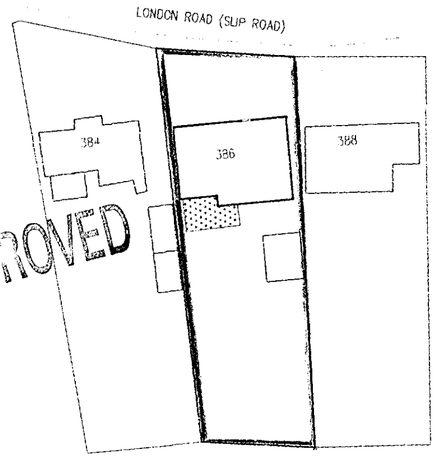


APPROVED

BLOCK PLAN
(1:500)

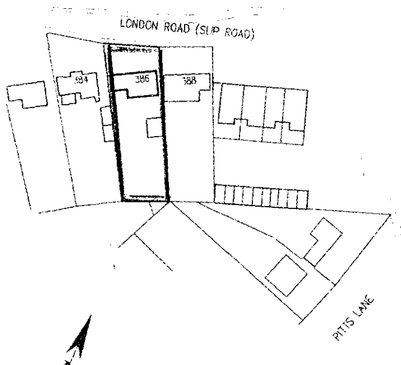


SITE LOCATION PLAN
(1:1250)